


PREPARED FOR :
DIANE KRAUSE
@ PROPERTIES
LAKE GENEVA, WI. 53147

PLAT OF SURVEY

- OF -

PATHFINDER SURVEYING INC.
(formerly)
J.K. SURVEYING INC.
P.O BOX 322
LAKE GENEVA, WI. 53147
WWW.PATHFINDERSURVEYING.NET
262-248-8303

LOT 1 OF CERTIFIED SURVEY MAP No. 4191, RECORDED IN THE OFFICE OF THE REGISTER OF DEEDS FOR WALWORTH COUNTY, WISCONSIN, ON OCTOBER 15, 2008, IN VOLUME 26, PAGE 262, AS DOCUMENT No. 747616, BEING A REDIVISION OF LOT 1 OF CERTIFIED SURVEY MAP No. 2926 AND PART OF THE SE 1/4 OF THE NE 1/4 OF SECTION 26, TOWN 2 NORTH, RANGE 17 EAST. SAID LAND BEING IN THE CITY OF LAKE GENEVA, COUNTY OF WALWORTH AND STATE OF WISCONSIN.

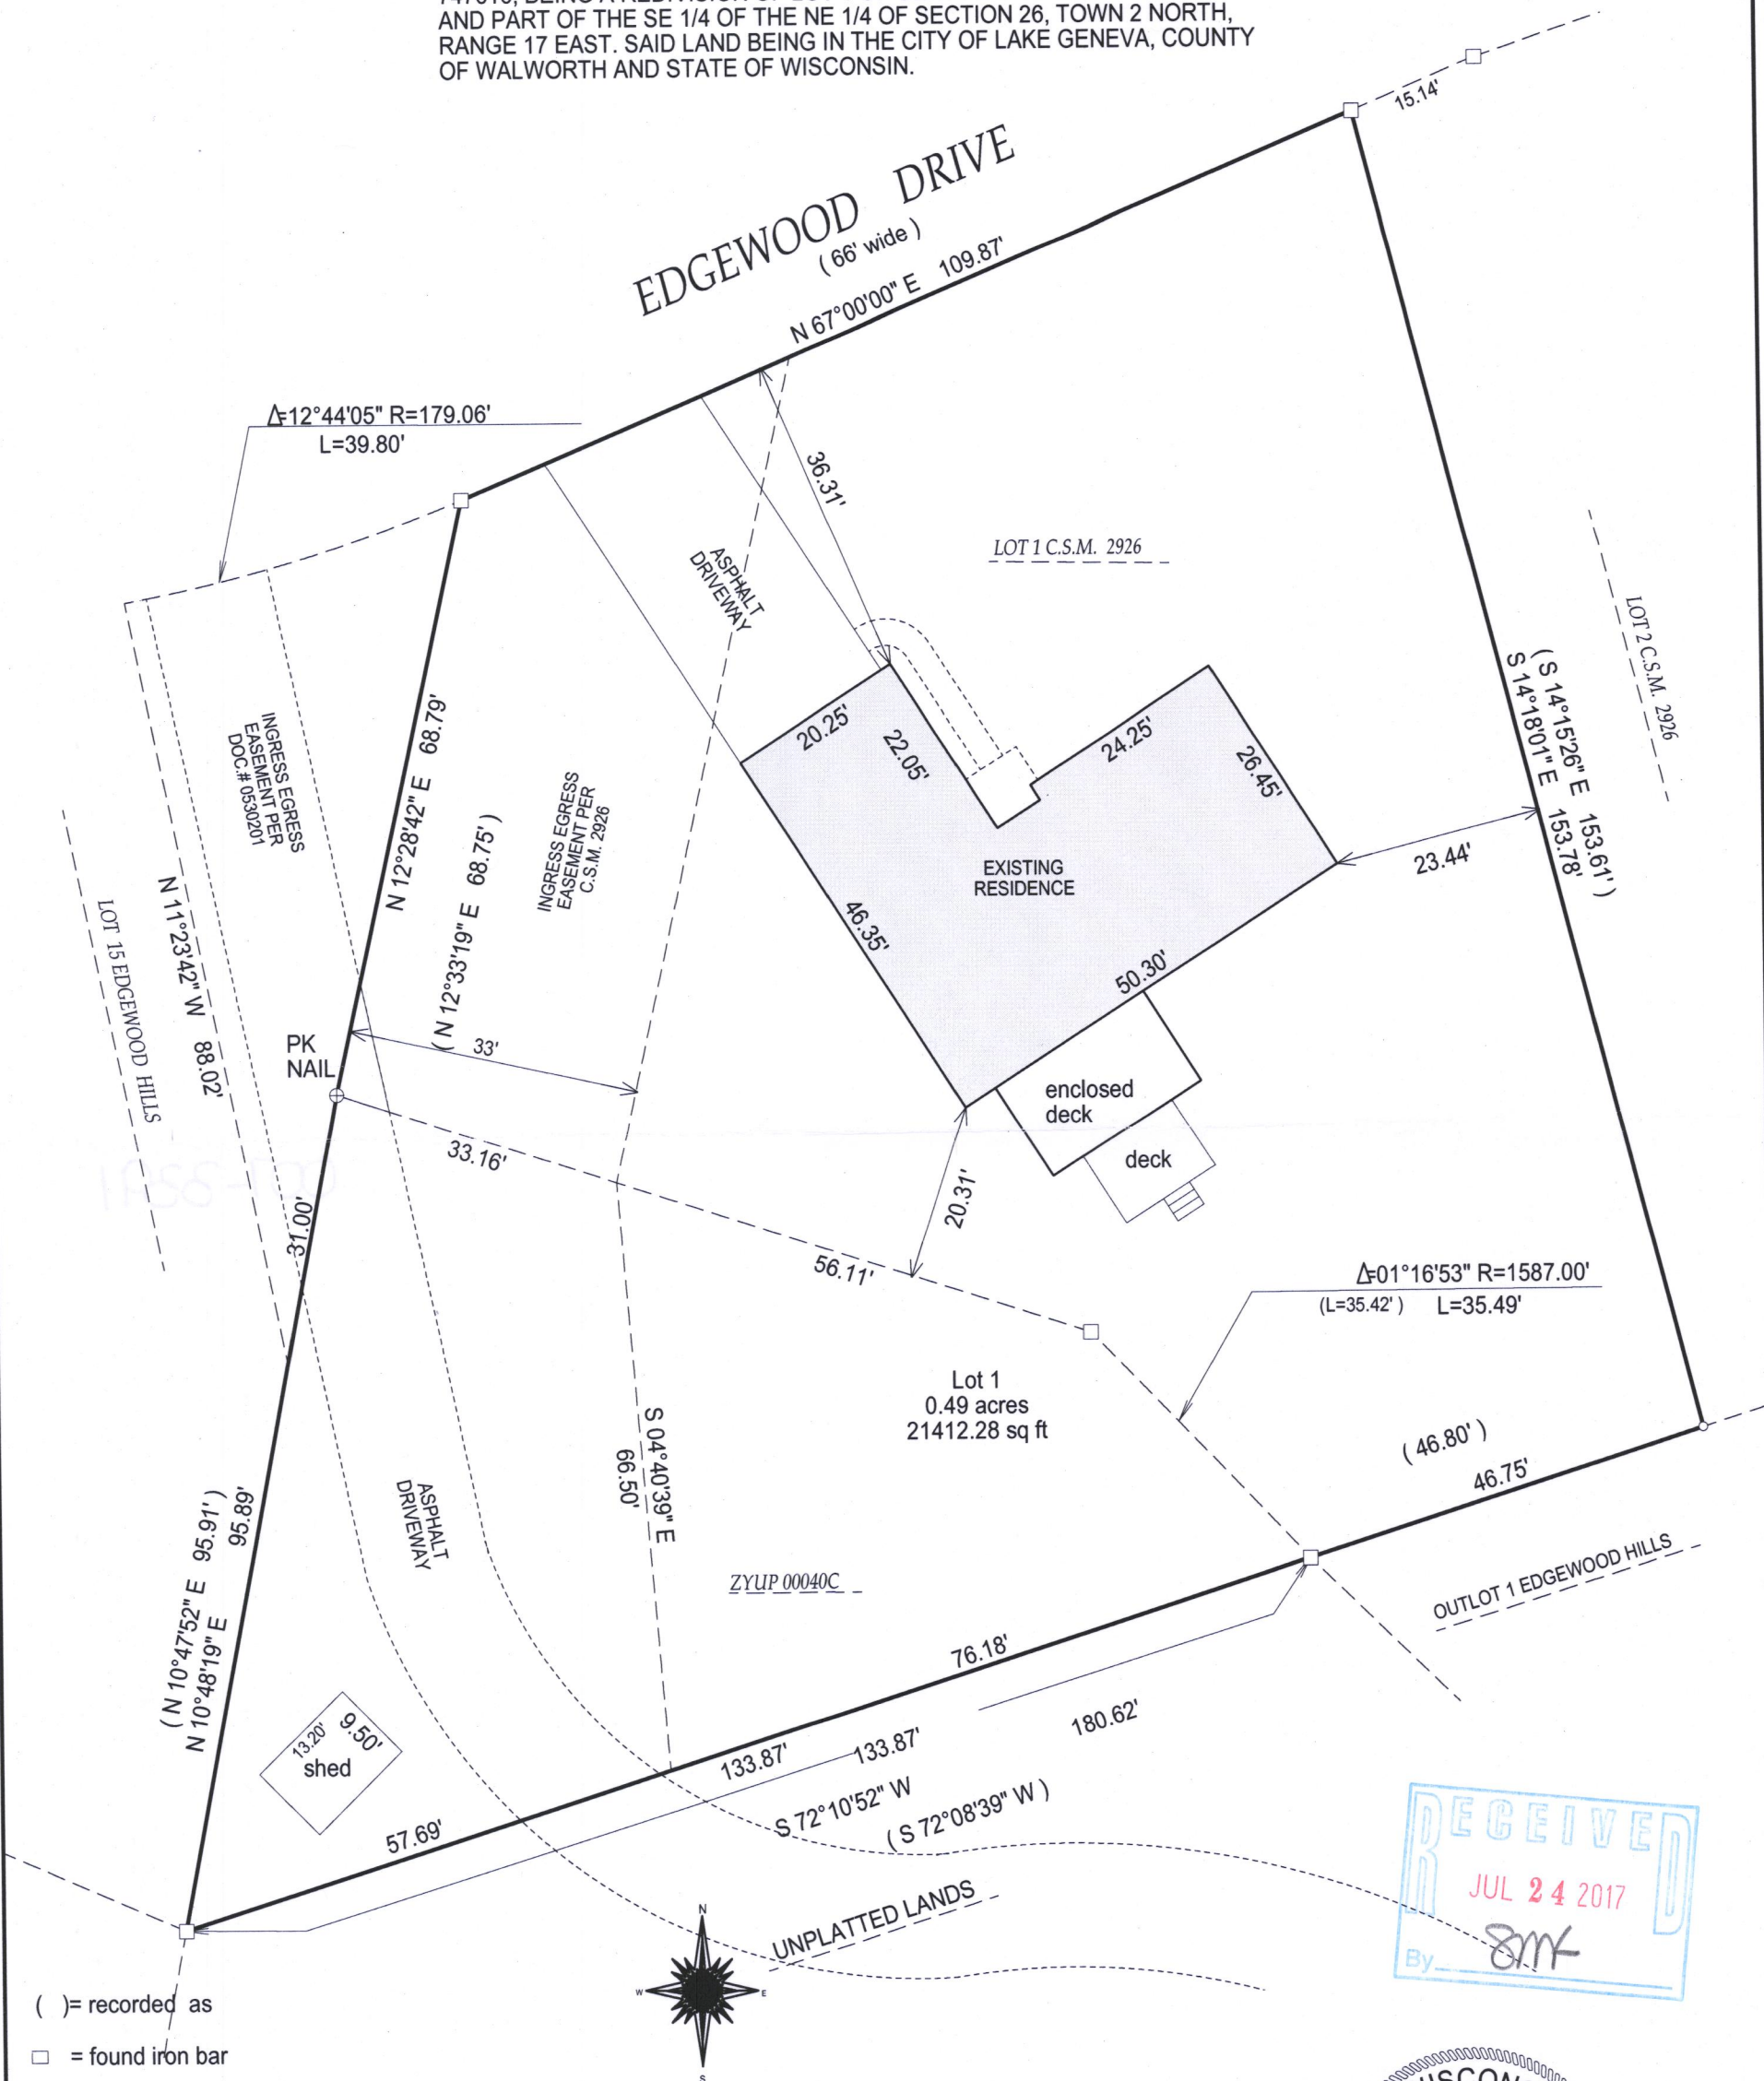

- () = recorded as
- = found iron bar
- = found iron pipe
- = set iron pipe
- = set iron bar

SCALE 1" = 20'

JOB # 17-103


TAX ID #
ZA419100001

BASIS OF BEARING OF THIS PLAT: THE CERTIFIED SURVEY OF RECORD.

"I hereby certify that I have surveyed the above described property and that the above map is a true representation of its exterior boundary and shows the size and location of all visible structures, apparent easements and encroachments if any."

This survey is made for the present owners of the property, and those who purchase, mortgage, or guarantee the title thereto, within one year from the date hereof.

DATED THIS 6th day of May, 2017.

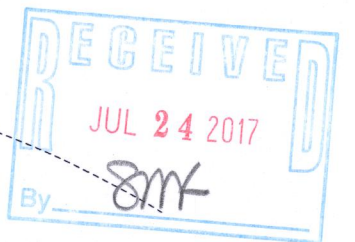

JEFFREY L. KIMPS S - 2436
Wisconsin Professional Land Surveyor
(original if signed in red)

007-3391