


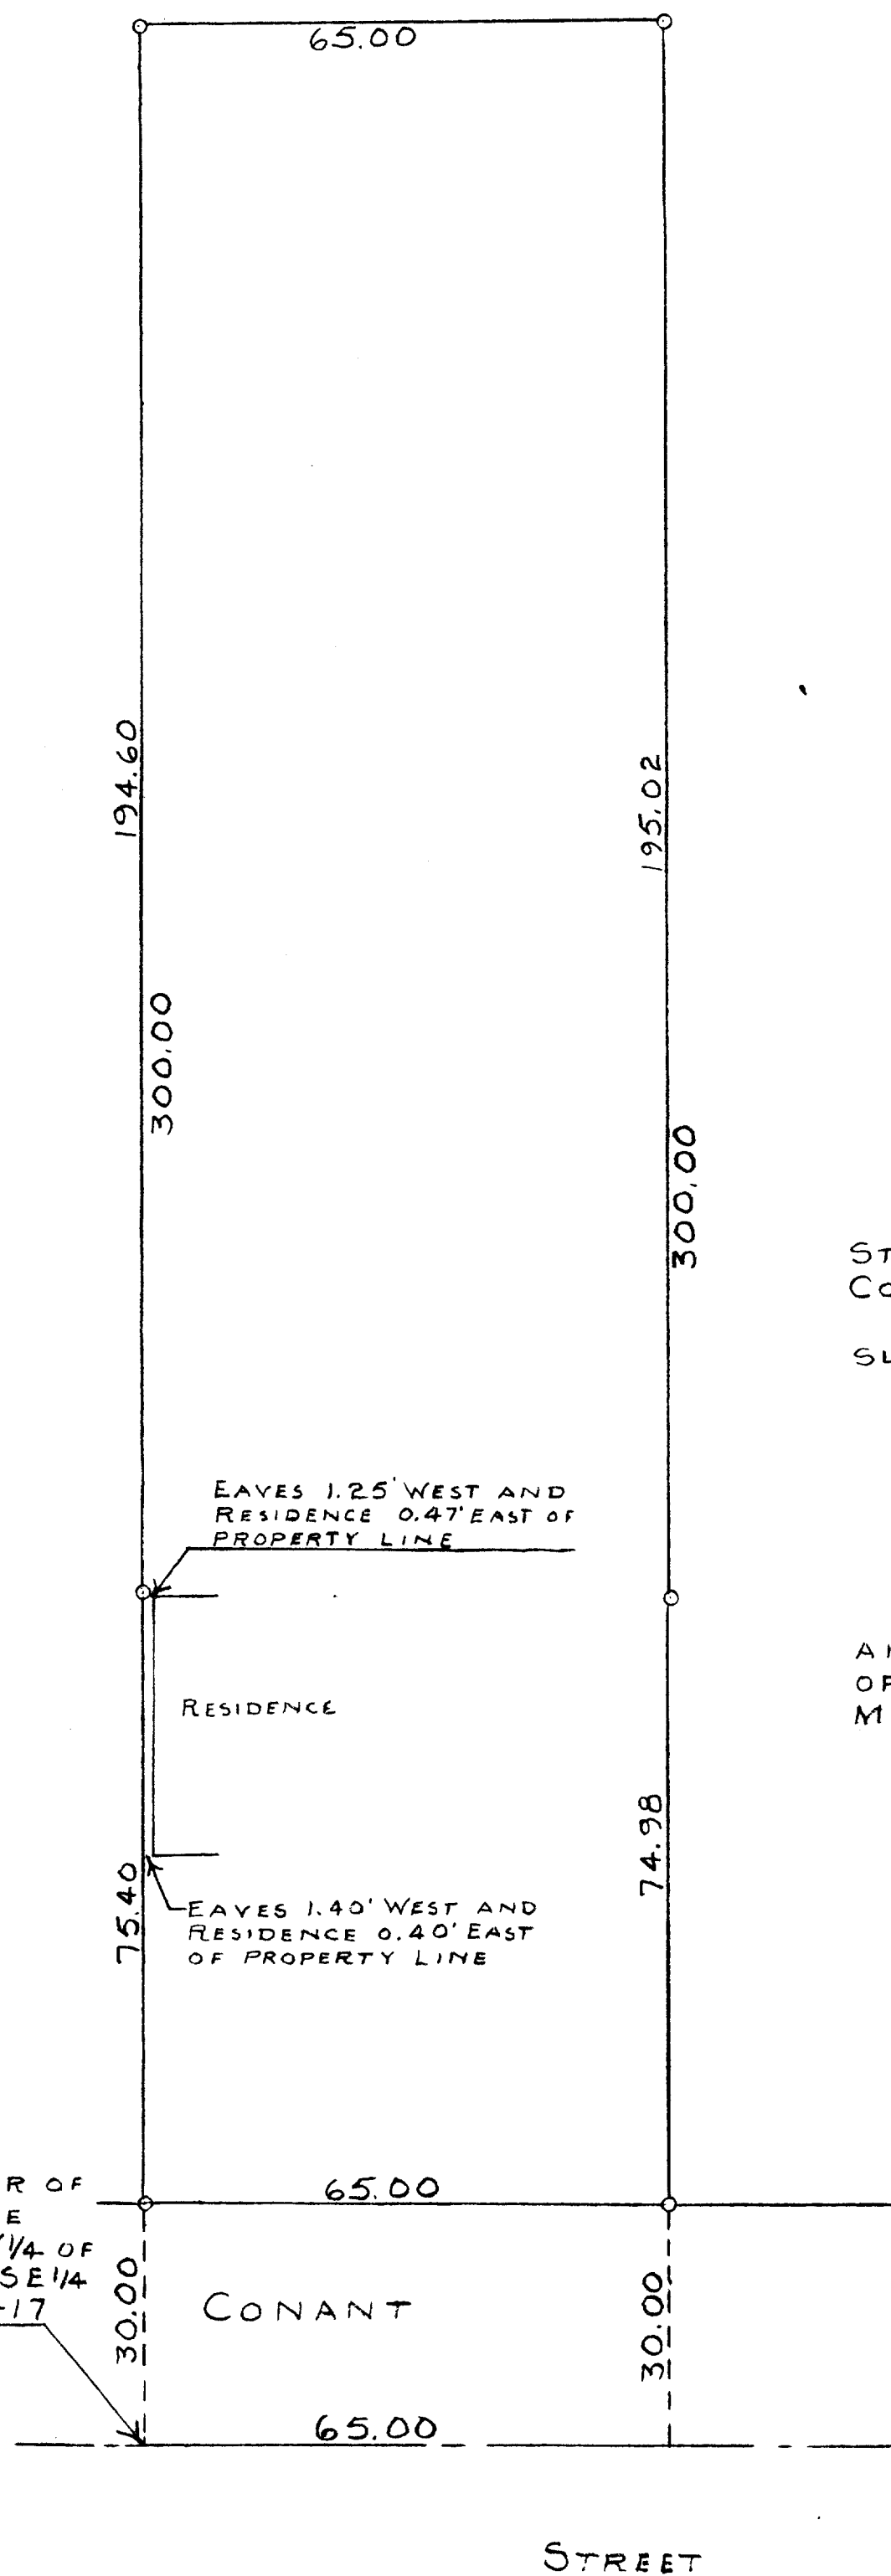

N

SCALE-1"=20'
0=IRON PIPE

STATE OF WISCONSIN)^{SS}
COUNTY OF WALWORTH)

I, GEORGE T. DUNHAM, DO HEREBY CERTIFY THAT I HAVE
SURVEYED THE PROPERTY DESCRIBED AS FOLLOWS:

A PARCEL OF LAND LOCATED IN THE E 1/2 OF THE W 1/2 OF THE
NW 1/4 OF THE SE 1/4 OF THE SE 1/4 OF SECTION 26, T2N
R17E OF 4TH P.M., WALWORTH COUNTY, WISCONSIN, DESCRIBED
AS FOLLOWS, TO-WIT: BEGINNING AT THE SOUTHWEST CORNER
OF SAID EAST 1/2; THENCE NORTH ALONG THE WEST LINE OF SAID
EAST 1/2, 300.00 FEET; THENCE EAST PARALLEL TO THE SOUTH
LINE OF SAID EAST 1/2, 65.00 FEET; THENCE SOUTH 300.00
FEET; THENCE WEST 65.00 FEET TO THE PLACE OF BEGINNING;
AND THAT THE PLAT SHOWN HEREON IS A CORRECT REPRESENTATION
OF THE PROPERTY LINES.
MARCH 28, 1957

George T. Dunham
GEORGE T. DUNHAM
DELAYAN, WISCONSIN
WIS. LAND SURVEYOR NO S-306

7-33A