


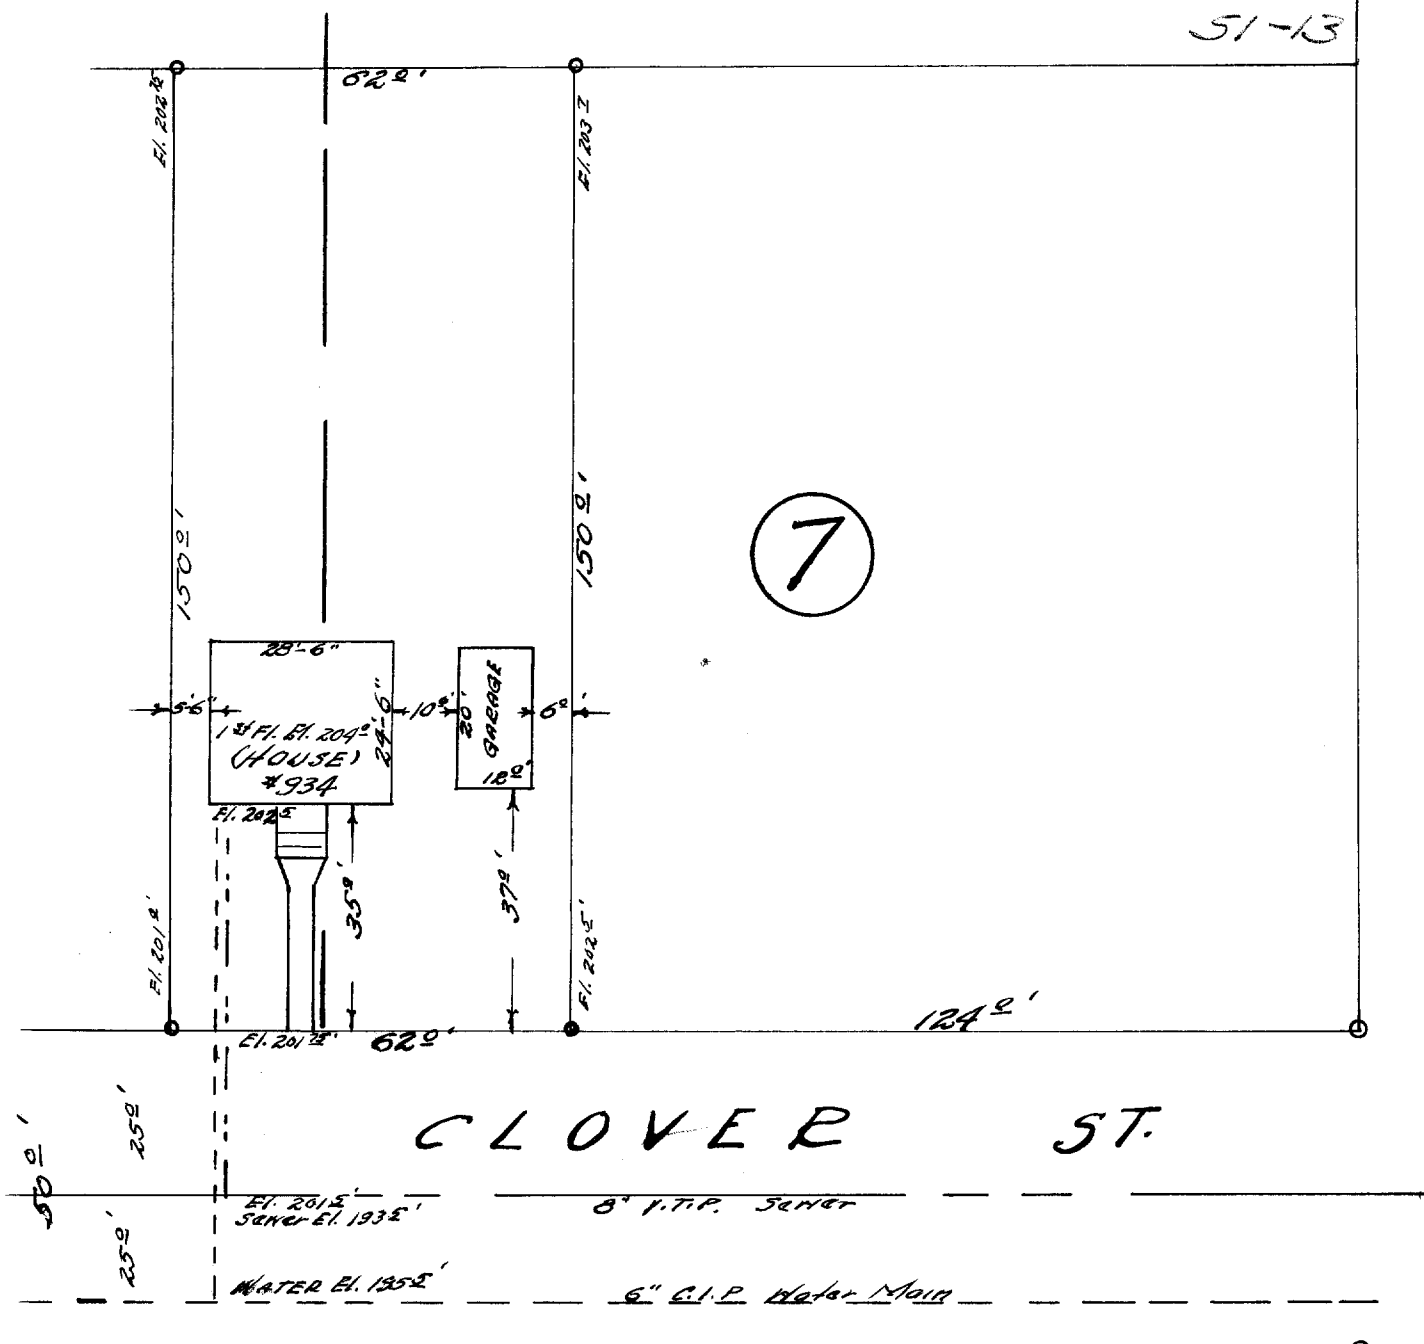

## DESCRIPTION:

Beginning at the N.E. corner of Lot 7 of the Columbian 2nd. Subdivision of a portion of the City of Lake Geneva Walworth County, Wisconsin, according to plat of said subdivision on record in the office of the Recorder of Deeds in and for Walworth County, Wisconsin; run thence South in the east line of Lot 7, 124.0 feet to the place of beginning of this description, run thence West parallel with the north line of said lot 7, 150.0 feet, thence South parallel with the east line of said lot 7, and the east line of lot 8, of said subdivision 62.0 feet, thence East parallel to the north line of said subdivision and said lot 7, 150.0 feet, to the east line of lot 8, thence North in the east lines of lot 7 and lot 8, 62.0 feet to the place of beginning.

## DESCRIPTION:

I, hereby certify that I have on this the 6th day of March 1951, surveyed the above described property according to the official records on file in the office of the Recorder of Deeds in and for Walworth County, Wisconsin, and find that the measurements and bearings of the boundary lines of said property as taken at the site on this day, substantially agree with those in said official record and that no encroachments exist,

SIGNED AND SEALED ON THIS THE 14TH DAY OF MARCH 1951.

*Joseph M. Blagi*  
Joseph M. Blagi. Professional Engineer.  
Elkhorn Wisconsin.

7-33B