


S 30°-09'E 6.61
 N 89°-37'E 327.89
 EAST - WEST 1/4 SECTION LINE
 EAST 1/4 SECTION
 CORNER OF SECTION 26
 T2N R17E



SCALE ~ 1" = 60'
 O = IRON PIPE

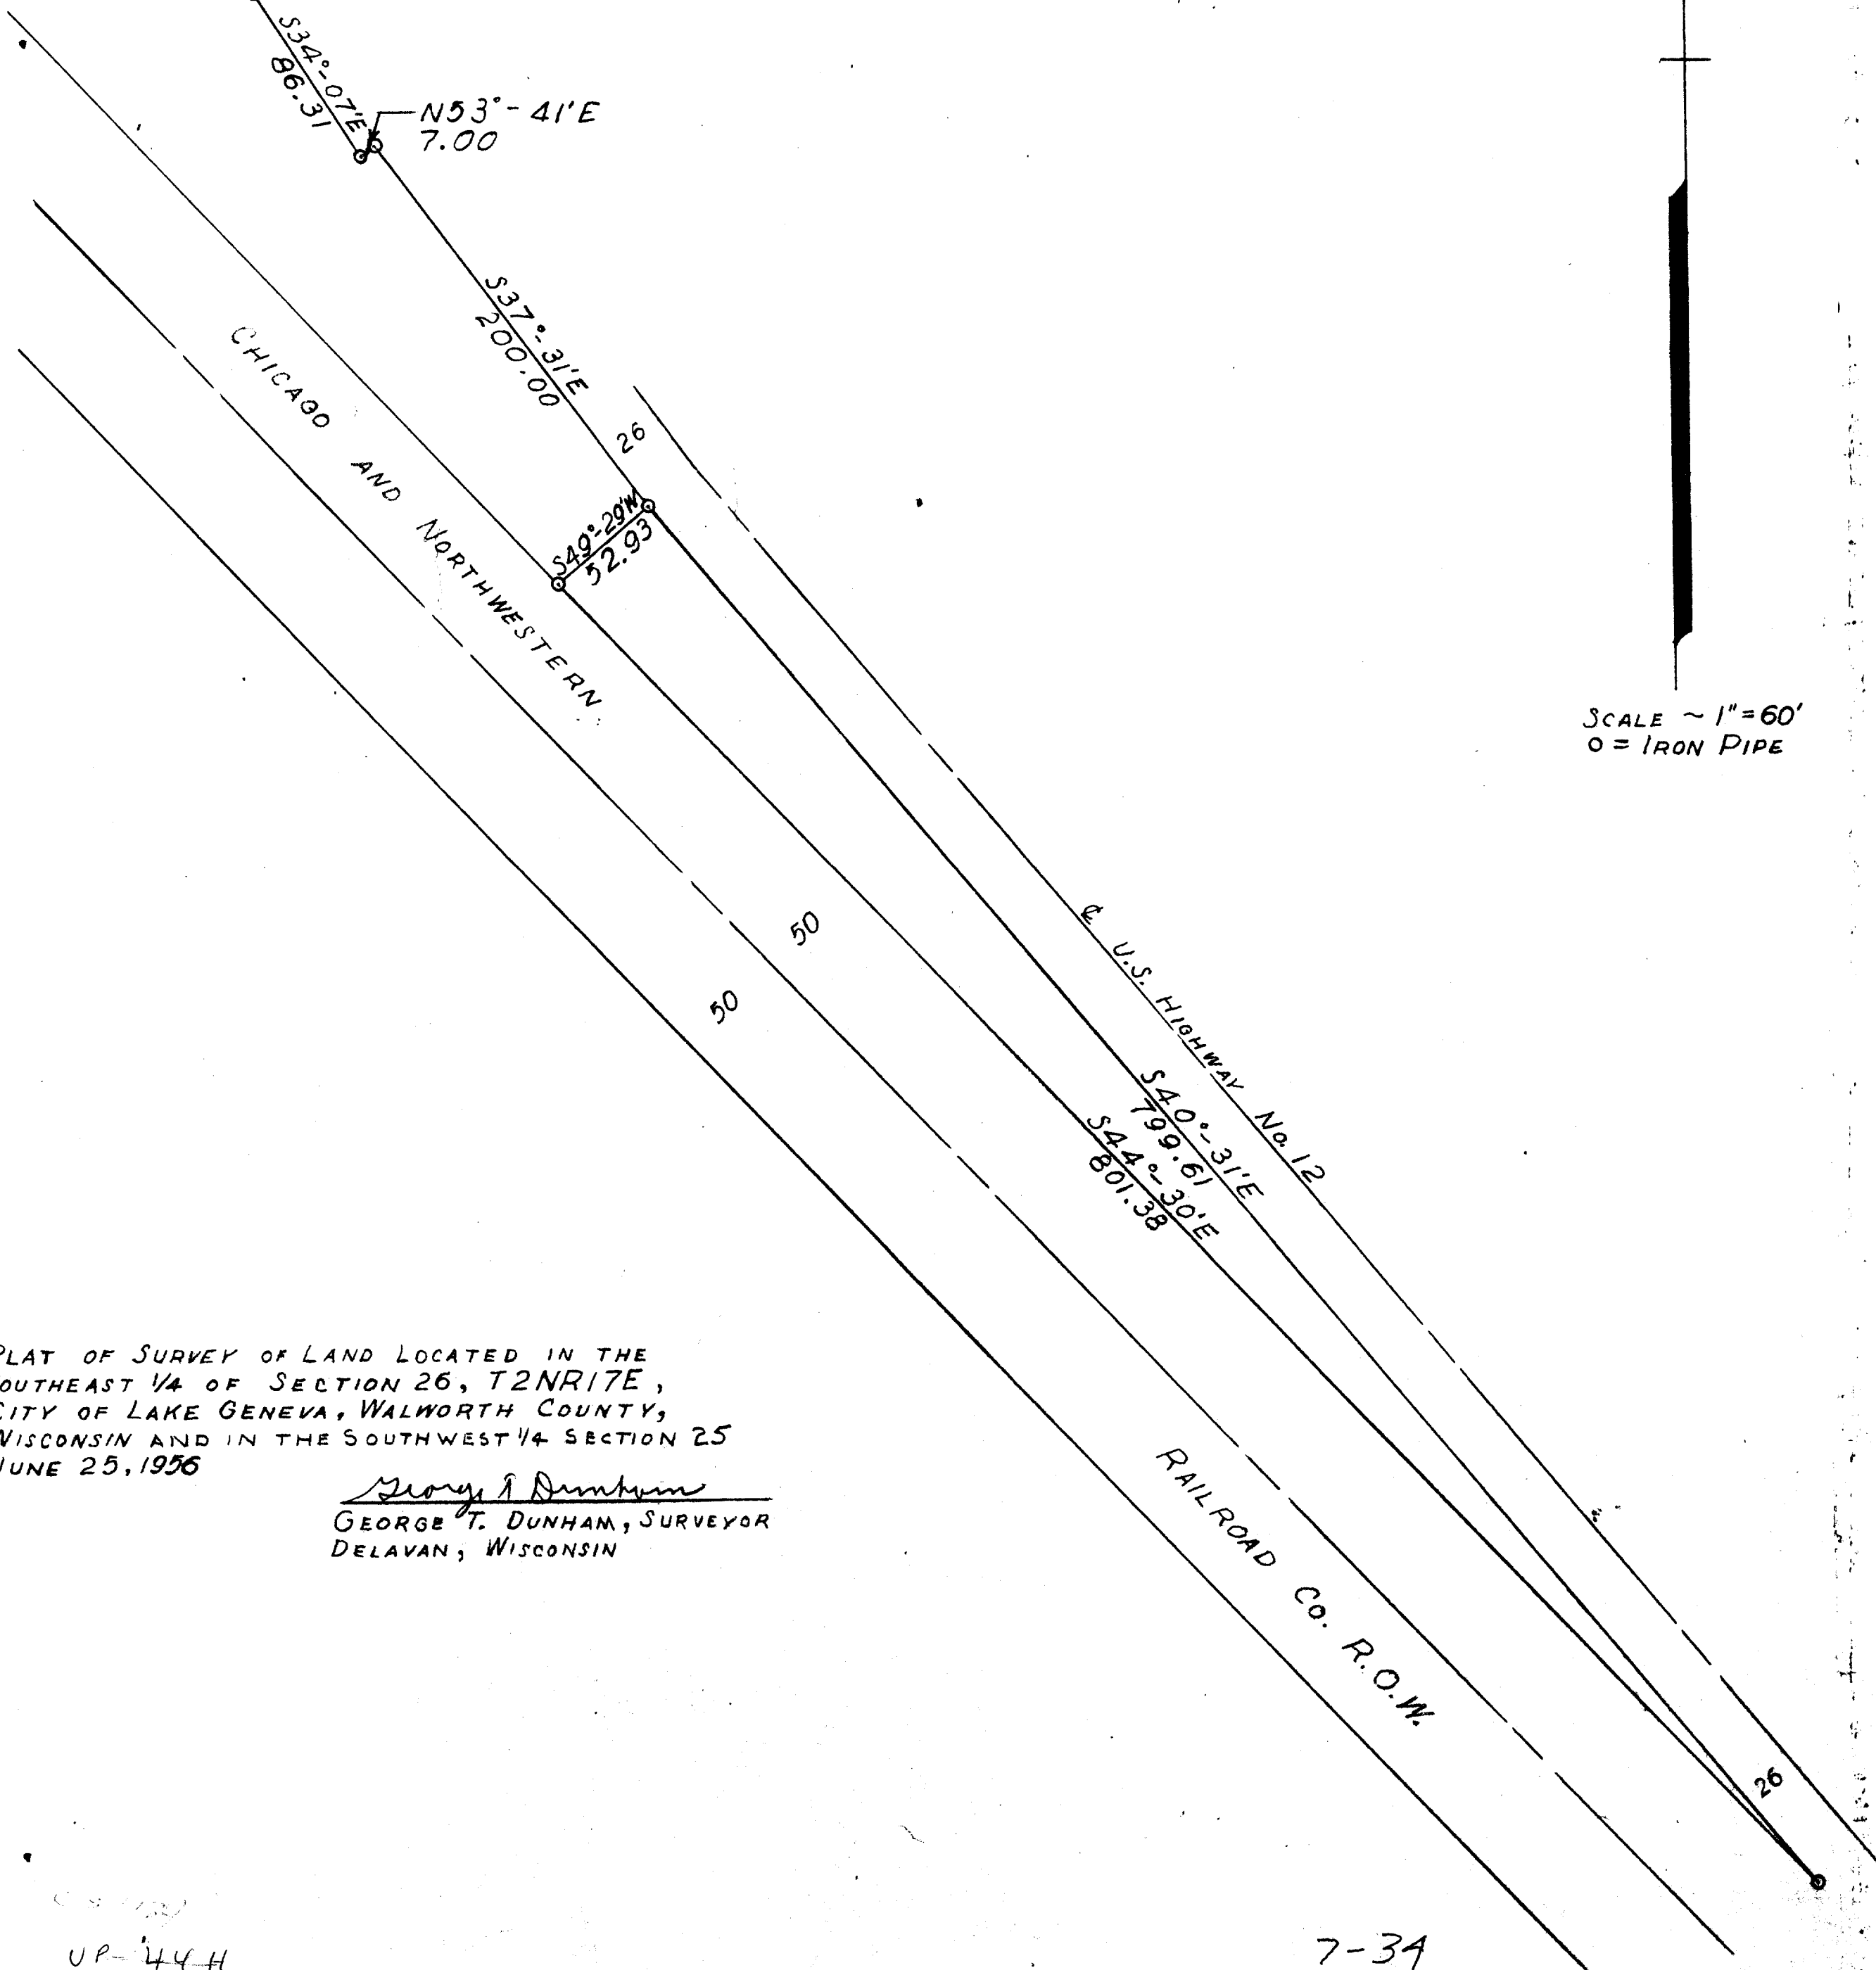

PLAT OF SURVEY OF LAND LOCATED IN THE
 SOUTHEAST 1/4 OF SECTION 26, T2N R17E,
 CITY OF LAKE GENEVA, WALWORTH COUNTY,
 WISCONSIN AND IN THE SOUTHWEST 1/4 SECTION 25
 JUNE 25, 1956

George T. Dunham
 GEORGE T. DUNHAM, SURVEYOR
 DELAVAN, WISCONSIN

UP 44H

7-34