


PREPARED FOR:
LAKE GENEVA AREA REALTY
101 BROAD ST
LAKE GENEVA, WI.

PLAT OF SURVEY


- OF -

PATHFINDER SURVEYING INC.
(formerly)
J.K. SURVEYING INC.
P.O BOX 322
LAKE GENEVA, WI. 53147
WWW.PATHFINDERSURVEYING.NET
262-248-8303

LOT 12, BLOCK 2 WARHURSTS SUBDIVISION, ACCORDING TO THE
RECORD PLAT THEREOF: LOCATED IN THE SW 1/4 OF SECTION 25,
TOWN 2 NORTH, RANGE, 17 EAST, CITY OF LAKE GENEVA, COUNTY
OF WALWORTH AND STATE OF WISCONSIN.

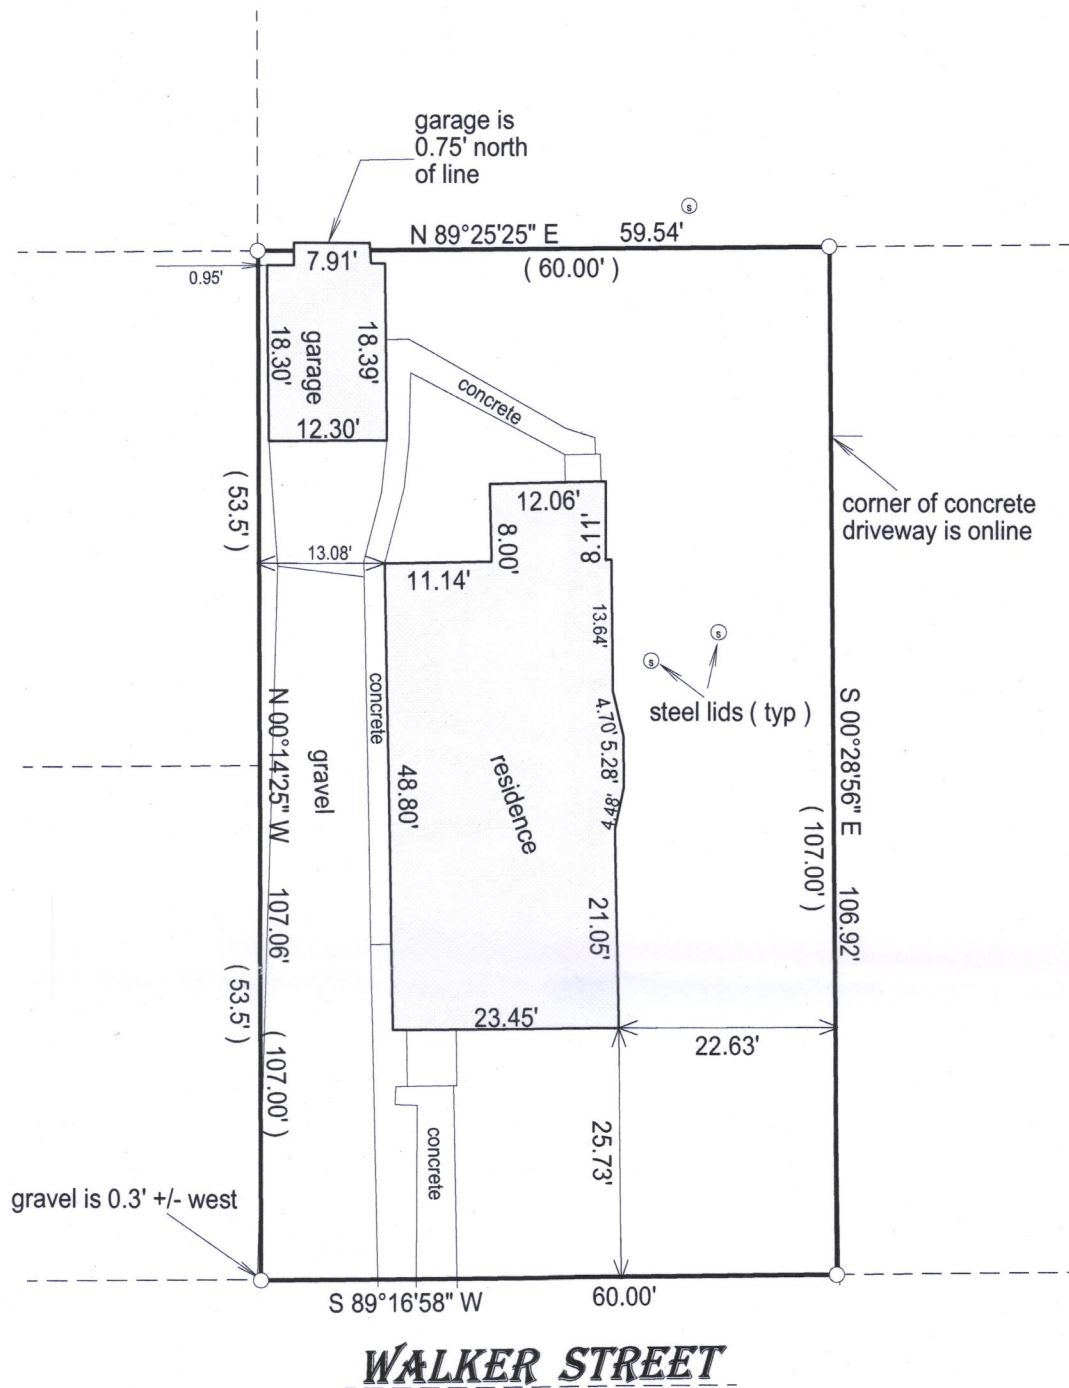

WALKER STREET

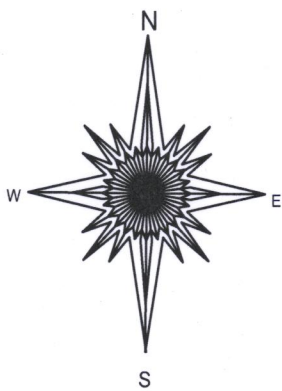


- () = recorded as
- = found iron bar
- = found iron pipe
- = set iron pipe
- = set iron bar

SCALE 1" = 20'

JOB # 17-163

TAX ID # ZW 00013

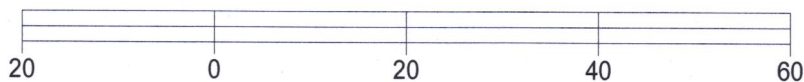


THE US STATE PLANR COORDINATE SYSTEM: SOUTH ZONE
NAD 83. WISCORS.

I hereby certify that I have surveyed the above- described property and the
above map is a true representation thereof and shows the size and
location of the property, its exterior boundaries, the location and
dimensions of all structures thereon, fences, apparant easements and
roadways and visible encroachments if any.

This survey is made for the present owners of the property, and those who
purchase, mortgage, or guarantee the title thereto, within one year from
the date hereof.

DATED THIS 19TH DAY OF JUNE, 2017.

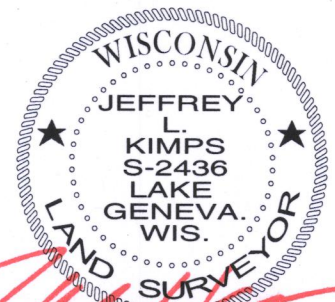

JEFFREY L KIMPS S - 2436
Wisconsin Professional Land Surveyor
(original if signed in red)

002-3414