


PLAT OF SURVEY

BEING LOT 19 OF CEYLON COURT ESTATES SUBDIVISION, A SUBDIVISION OF PART OF GOVERNMENT LOT 2 AND 3, WHICH SUBDIVISION IS ALSO PART OF THE SE 1/4 OF THE NW 1/4, THE SW 1/4 OF THE NE 1/4, THE NE 1/4 OF THE SW 1/4, THE NW 1/4 OF THE SE 1/4 OF SECTION 1, T1N, R17E, WALWORTH COUNTY, WISCONSIN.



LOT 20
CEYLON COURT
ESTATES SUB.

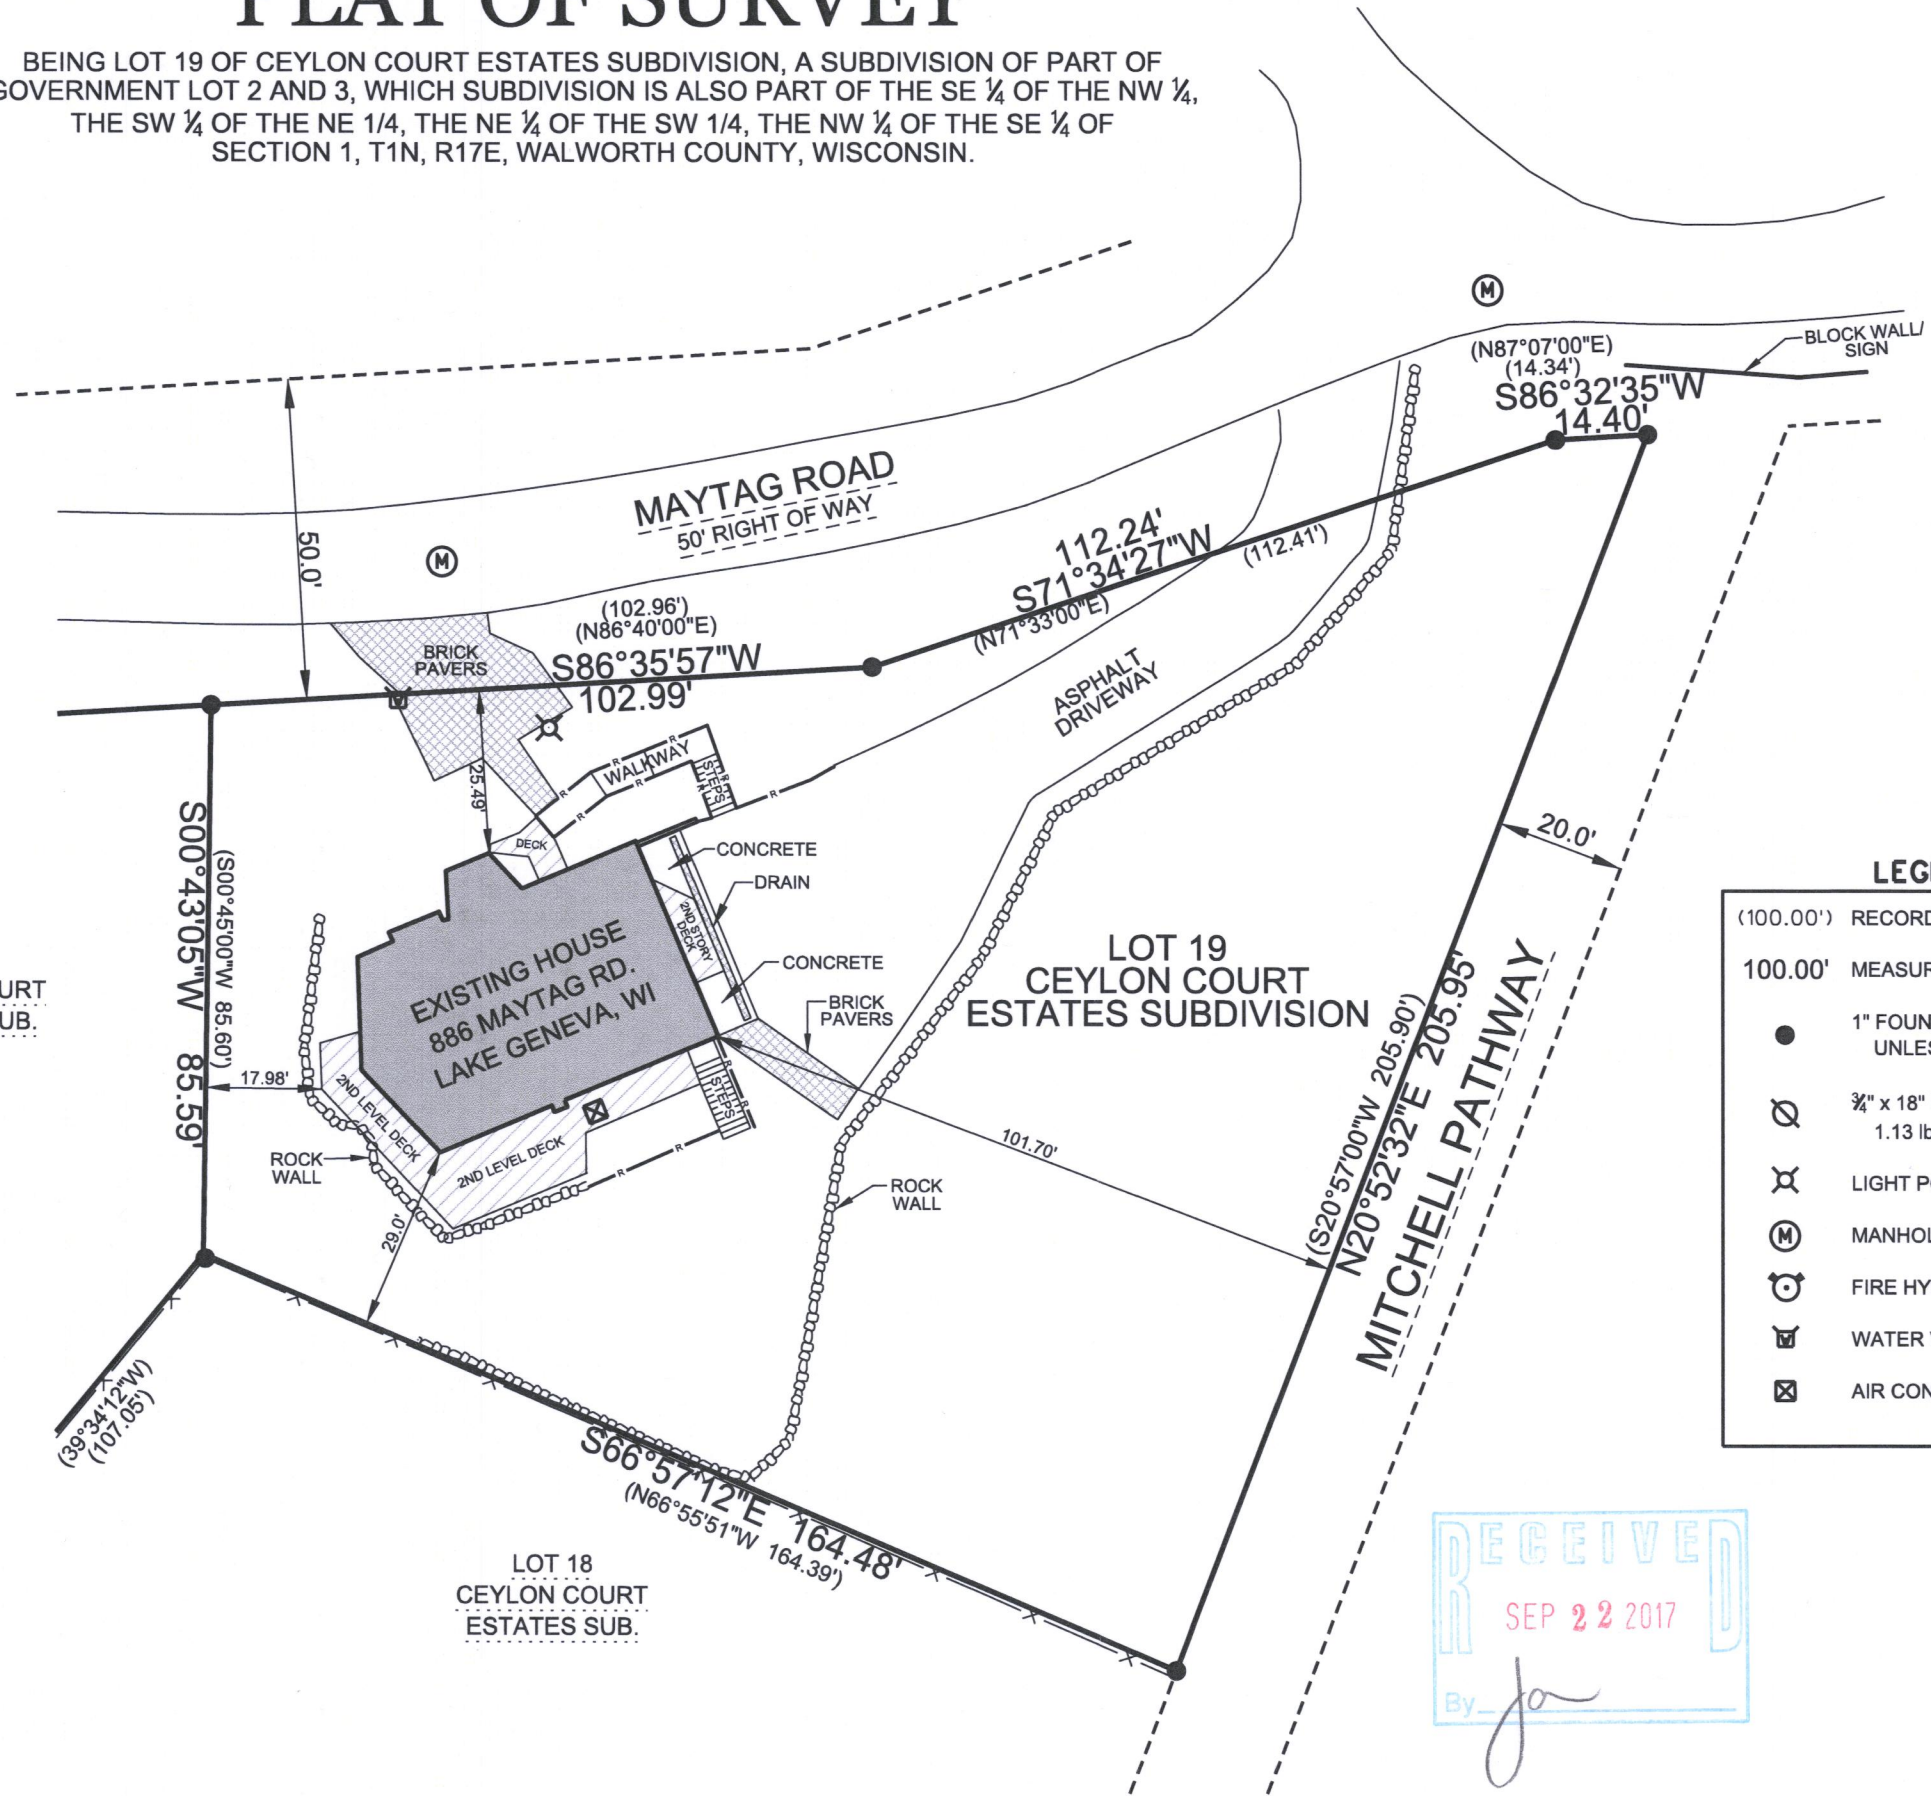

LOT 19
CEYLON COURT
ESTATES SUBDIVISION

EXISTING HOUSE
886 MAYTAG RD.
LAKE GENEVA, WI

LOT 18
CEYLON COURT
ESTATES SUB.

LEGEND:

- (100.00') RECORDED DISTANCE
- 100.00' MEASURED DISTANCE
- 1" FOUND IRON PIPE, UNLESS NOTED
- Ø 3/4" x 18" IRON PIPE SET, 1.13 lbs./L.F.
- ⋈ LIGHT POLE
- (M) MANHOLE
- (H) FIRE HYDRANT
- ⊠ WATER VALVE
- ⊠ AIR CONDITIONER

RECEIVED
SEP 22 2017
By *ja*



THIS SURVEY IS MADE FOR THE USE OF THE PRESENT OWNERS OF THE PROPERTY, AND ALSO THOSE WHO PURCHASE, MORTGAGE OR GUARANTEE TITLE TO WITHIN ONE (1) YEAR FROM DATE HERETO.

I, MICHAEL A. GREESON R.L.S. #2770, HEREBY CERTIFY THAT THIS SURVEY WAS MADE IN ACCORDANCE WITH THE MINIMUM STANDARDS FOR PROPERTY SURVEYS (CHAPTER A-E 7) FOR THE STATE OF WISCONSIN AND HAS BEEN PREPARED UNDER MY DIRECTION AND CONTROL AND IS CORRECT TO THE BEST OF MY KNOWLEDGE AND BELIEF.

SURVEY DATE: 05/24/2017
SURVEY MADE FOR:
KEEFE REAL ESTATE
JANIS HARTLEY
751 GENEVA PARKWAY N.
LAKE GENEVA, WI 53147

V²G
SURVEYING, LLC
123 WOLF RUN - SUITE 4
MUKWONAGO, WI 53149
(262) 378-5097

FILE NAME: 2017-074 MAYTAG RD SURVEY LAKE GENEVA.DGN