


PLAT OF SURVEY

BEING LOT 20 OF CEYLON COURT ESTATES SUBDIVISION, A SUBDIVISION OF PART OF GOVERNMENT LOT 2 AND 3, WHICH SUBDIVISION IS ALSO PART OF THE SE ¼ OF THE NW ¼, THE SW ¼ OF THE NE ¼, THE NE ¼ OF THE SW ¼, THE NW ¼ OF THE SE ¼ OF SECTION 1, T1N, R17E, WALWORTH COUNTY, WISCONSIN.

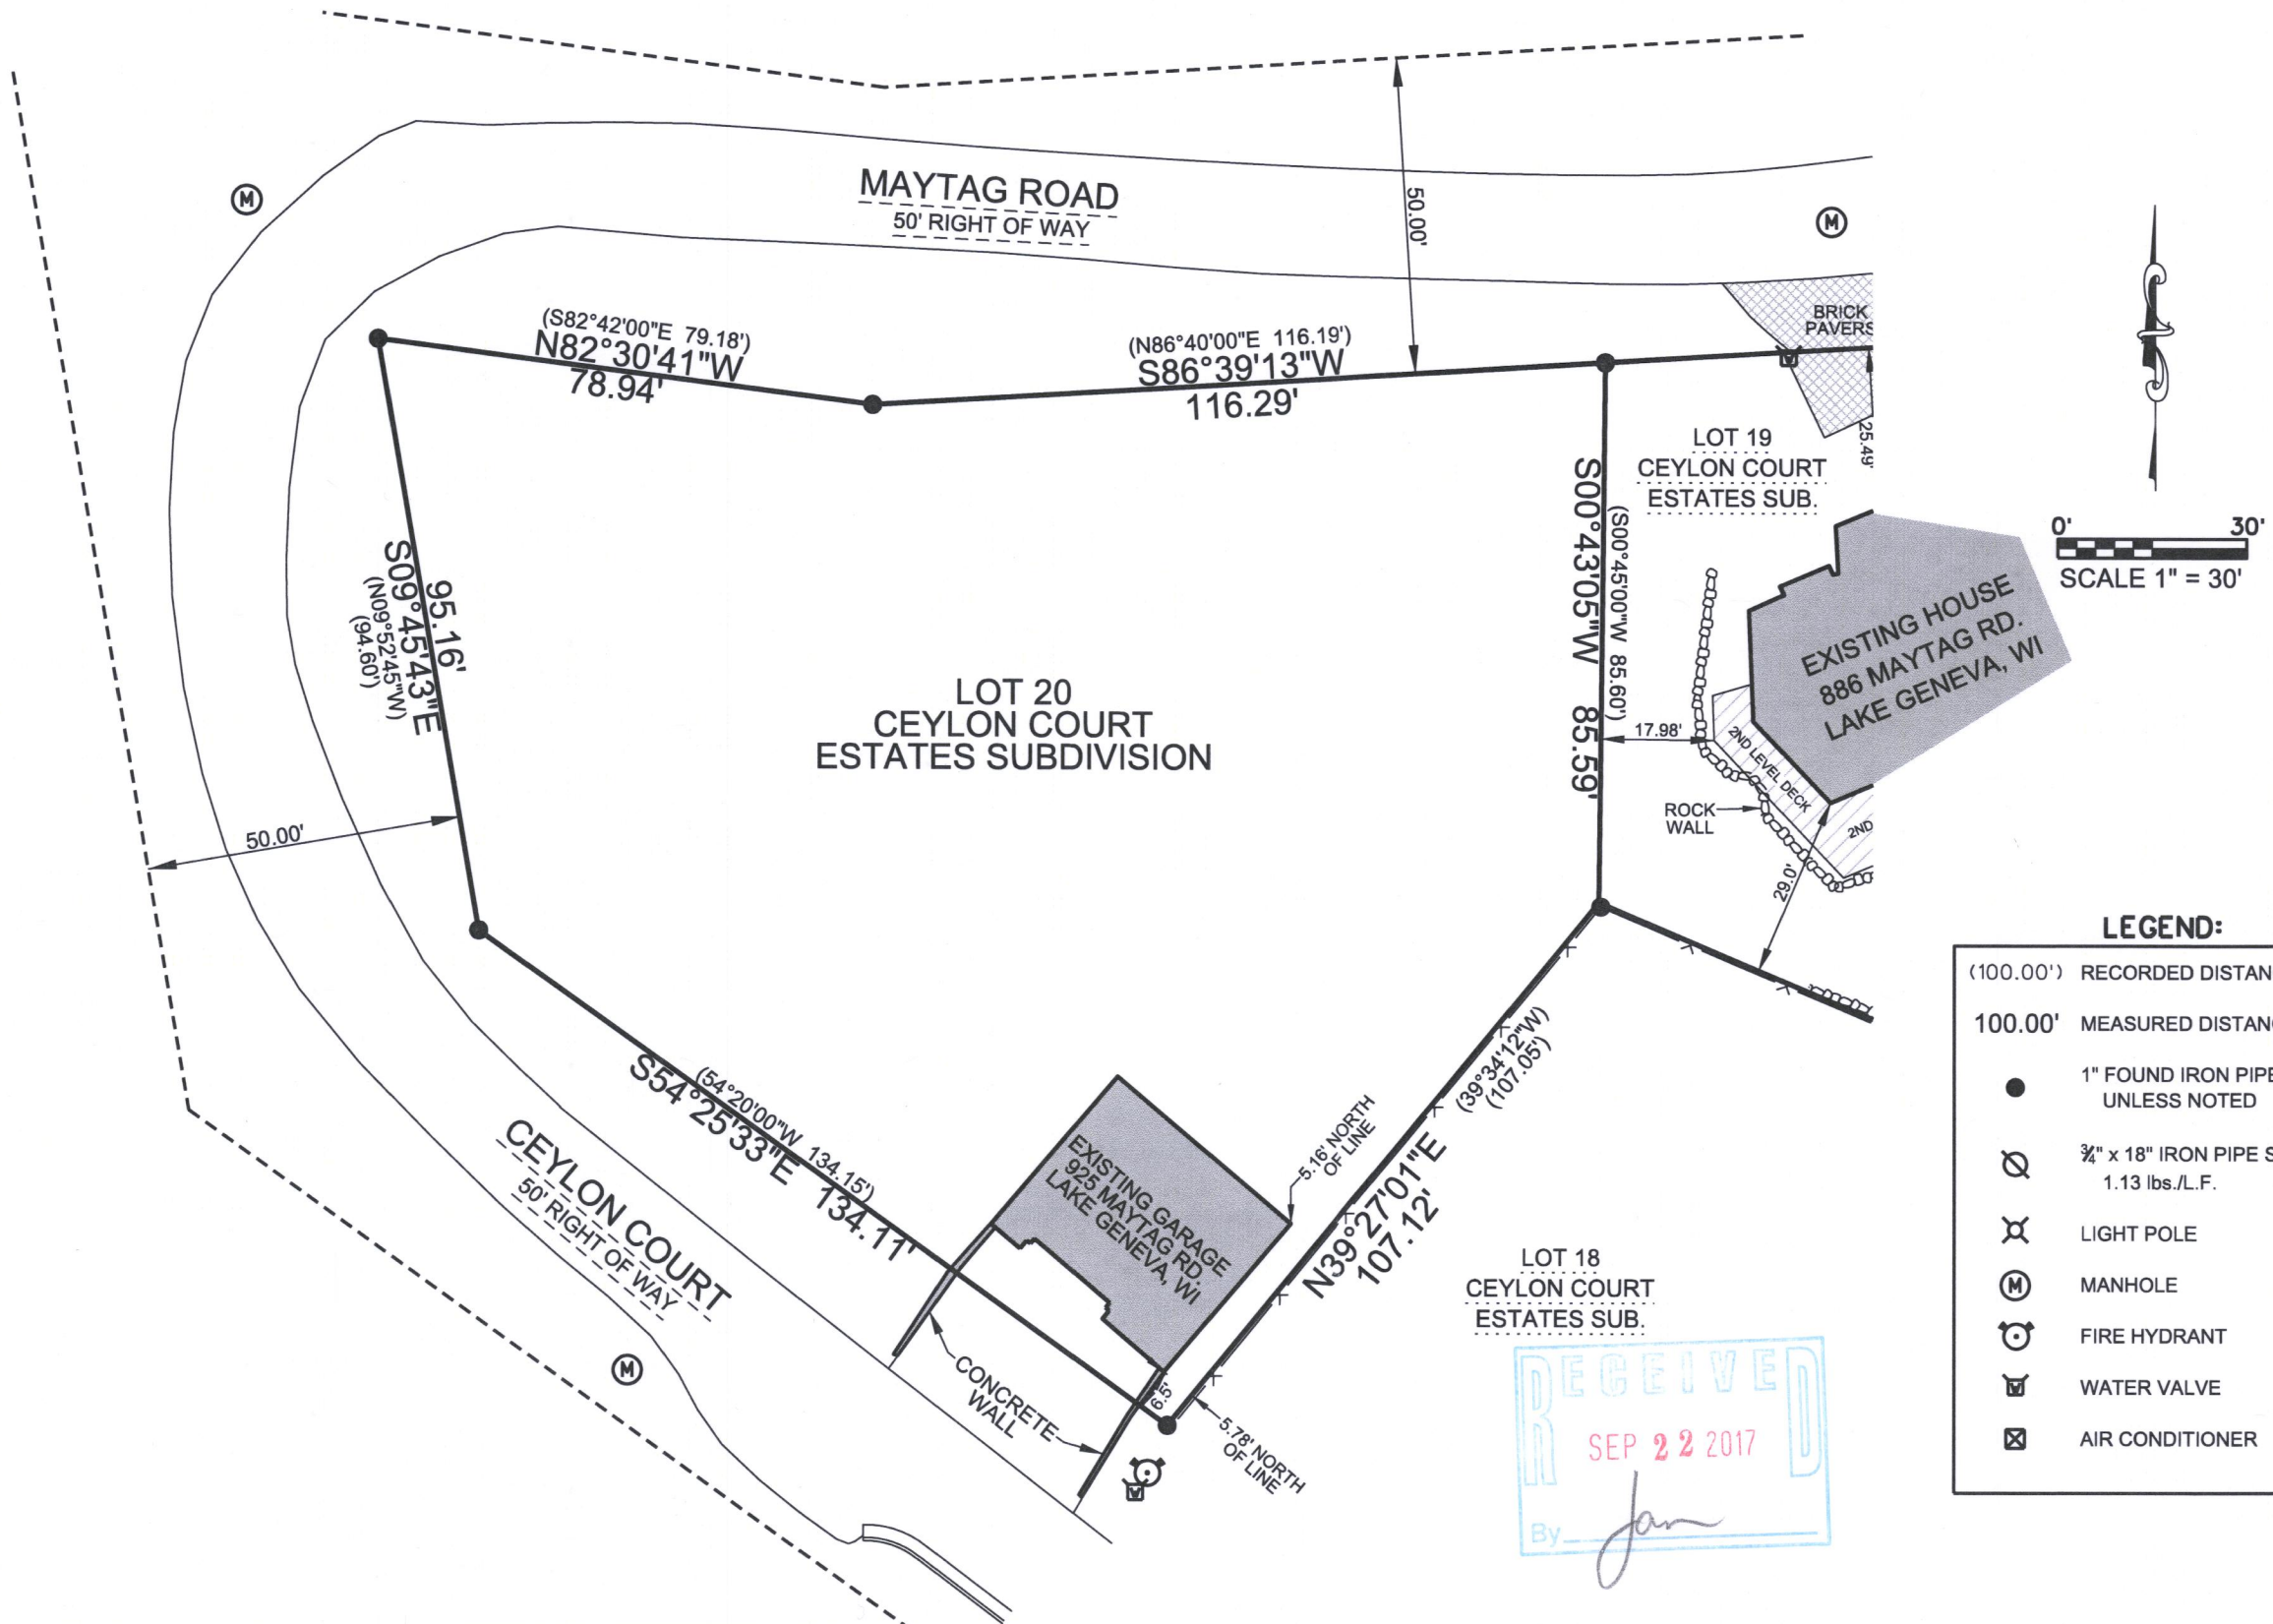

FILE NAME: 2017-074 MAYTAG RD SURVEY LAKE GENEVA.DGN

PLOT DATE: 05/24/2017

V2G JOB*: 2017-074

ZCE-20 007-3425

THIS SURVEY IS MADE FOR THE USE OF THE PRESENT OWNERS OF THE PROPERTY, AND ALSO THOSE WHO PURCHASE, MORTGAGE OR CHARGE TITLE TO WITHIN ONE (1) YEAR FROM DATE HEREOF.

SURV
SURV
KEEFE
JANIS
751 G
LAKE

SUR
123
MU