

71. June 24, Survey,
a strip of land W.
Road, strip 164.4' wide.
164.4 Cemetery to ctr.
159.35' line 1071.71.
5.1 from W. line Oakhill
to center Elkhorn
 $1072.7 + 1142' = 1102.35'$
2

Run line from Mon.
to post at N. Cor.
and measured N. from
350' and set iron
said cor. post and
line cemetery and W.
and set iron stk.
6/25/30 cut brush and re-measured
N. W. Cor. post of Oakhill
re-set stake, change
on West Cemetery line
correction 1.1' East.
Set transit 350' N. on
on ctr. fence post at
and to right or west
350' and made point
Cemetery extended 350'
fence line, measured
350' to W. end of N.

request of J. J. Notter
side Yenne's land Elkhoe
running from W. line Oakhill
of Elkhorn Road

N. line 1142', both
Cemetery or W. line Sect 26
road,

$\times 164.4 = 4.18 \text{ acres}$

60
at N. W. Cor. Sect. 26
Oakhill Cemetery
said N. W. Cor. post
stk. Set iron stk. at
measured S. on W.
line Sect. 26 164.4'

measured line 350' N. from
Cemetery (correct line) and
3" re-set stake 164.4' So.
and W. sect line 25-2-17,

sect line (on stake) sighted
N. W. Cor. of Cemetery
at st. 4 and measured
Measured west on N. line
and set iron stk. on
N. from last point
350' line, tell 3' Not

72

point set for W. end
 Adjusted to make
 length 350' Iron
 Iron stk. at N. W. Cor
 N. side of post.
 Measured northerly on
 from W. end of fence
 Cemetery extended West.
 Measured S. W. from
 sy. tract 840.8' to N.
 and ~~are~~ 34.3' to center
 falls 2' N. of line of
 line of pavement. Said
 is also 185.2' N. of
 that sold to Fenner's
 piece bought of Fenner
 N. line or N. line Cemetery Ex
 S. line is 1072.7'
 350' sy. whose S. 2. Cor
 whose 2 line is on line
 from N. W. Cor. of 350' sy.
 road 2' N. of N. Cemetery


of N. line.
 N. & W. lines agree as to
 stks at all corners.
 cemetery is central at

E. road fence line 16'
 on line of N. line of
 and set iron stk.
 W. end line of 350'
 end 16' line
 of highway (875.3'). Said
 Cemetery extended to ctr.
 point on ctr. line of paved
 line between Fenner and
 brother-in-law.
 is 164.4' wide N. & S.
 is 1142' to ctr. of road

is N. W. Cor. Cemetery and
 between sects 25 & 26,
 parcel S. W. to ctr. of
 line extended 875.1'

72

Fenner & Malsch

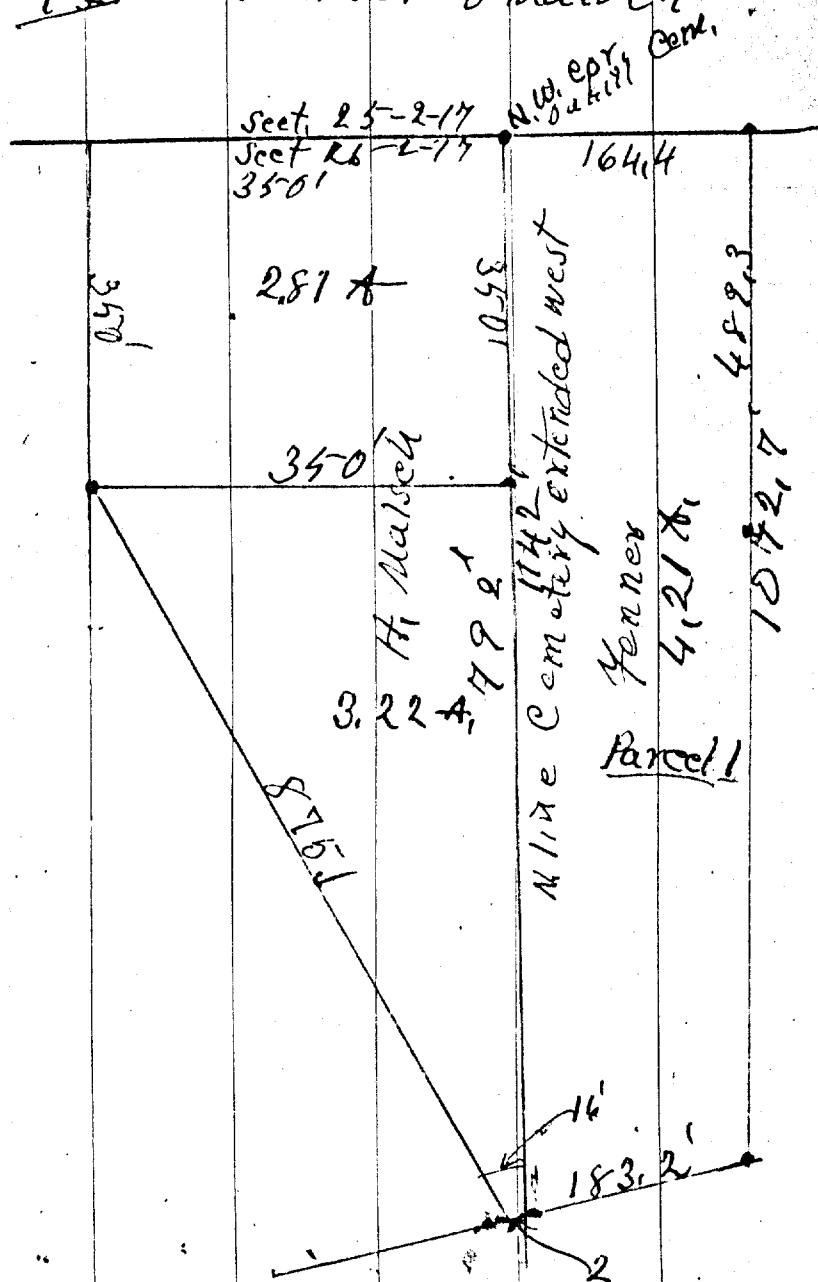

to S. J. Notter.

Description Fenner parcel
 Begin at an iron stk at N.W.
 cor. Oak Hill Cemetery, on
 line between Seets 25 & 26, T.2,
 N. R. 17 E. thence W. in N. line
 Cemetery extended 1142' to
 ctr. of highway, (notch in point)
 thence S. $24^{\circ} 49'$ E. in said
 ctr. line, 183.2' to notch
 in point, thence E. 11. N.
 line Cemetery extended west
 38' to ~~ctr.~~ iron stk. in
 N. line of highway, which
 said point and stk are
 164.4' S. of N. line of Cemetery
 extended, thence in same
 line E. 1072.7' from ctr.
 of road, over 2 iron stks
 to an iron stk in W. line
 of Cemetery, or W. line
 Seet. 25-12-17. thence N.
 in said W. line Seet. 25
 164.4' to point of beginning
 contains 421 A. more or less

7-342-lk

73

Parcel 2 of 1
 Begin at iron sth;
 tery, also on line betw
 R. 17 E, thence N. in
 W. 11 N. line Cemetery
 sth, thence S. parallel
 iron sth, on N. line
 in said N. line extends
 contains 2,81 A.

Parcel
 Begin in line Cemetery
 350' W. of N. W. Cor.
 N. parallel to line
 R. 17 E. 350 to an
 840.8' to an iron
 con. post W. end N. line
 Highway 12, and on to
 34.3' farther; or total
 in ctr. line said road
 2xtd; thence E. in said
 beginning, contains
 to that acreage. 4.21 +
 completed survey

Notter from to, Malsch,
 at N. W. Cor. Oakhill Ceme-
 ten Sects 25 & 26, Town 2 N.
 said section line 350' ^{to iron sth} thence
 Ext. W. 350' to an iron
 to said section 350 to an
 Cemetery extended W. thence
 350' to place of beginning
 more or less,

3,
 Extended W. at an iron sth.
 Oakhill Cemetery, thence
 between Sects 25 & 26, T. 2 N.
 iron sth.; thence S. W.
 sth. ~~840.8'~~ 16' N. W. from
 Cemetery Ext. W. to E. line
 ctr. of point highway 12
 875.1'. thence southeasterly
 2' to N. line Oakhill Cemetery
 N. line 792' to point of
 322. A. more or less
 $281 + 322 = 1024$ A.
 June 25, 1930