

PREPARED FOR
LAKE GENEVA AREA
REALTY



ORDERED BY
LINDA DYER

PLAT OF SURVEY

- OF -

LOT 73 OF THE COLUMBIAN SUBDIVISION, CITY OF LAKE
GENEVA, WALWORTH COUNTY, WISCONSIN.

PATHFINDER SURVEYING
(a NMB Company)
P.O BOX 322
LAKE GENEVA, WI. 53147
WWW.PATHFINDERSURVEYING.NET
262-248-8303

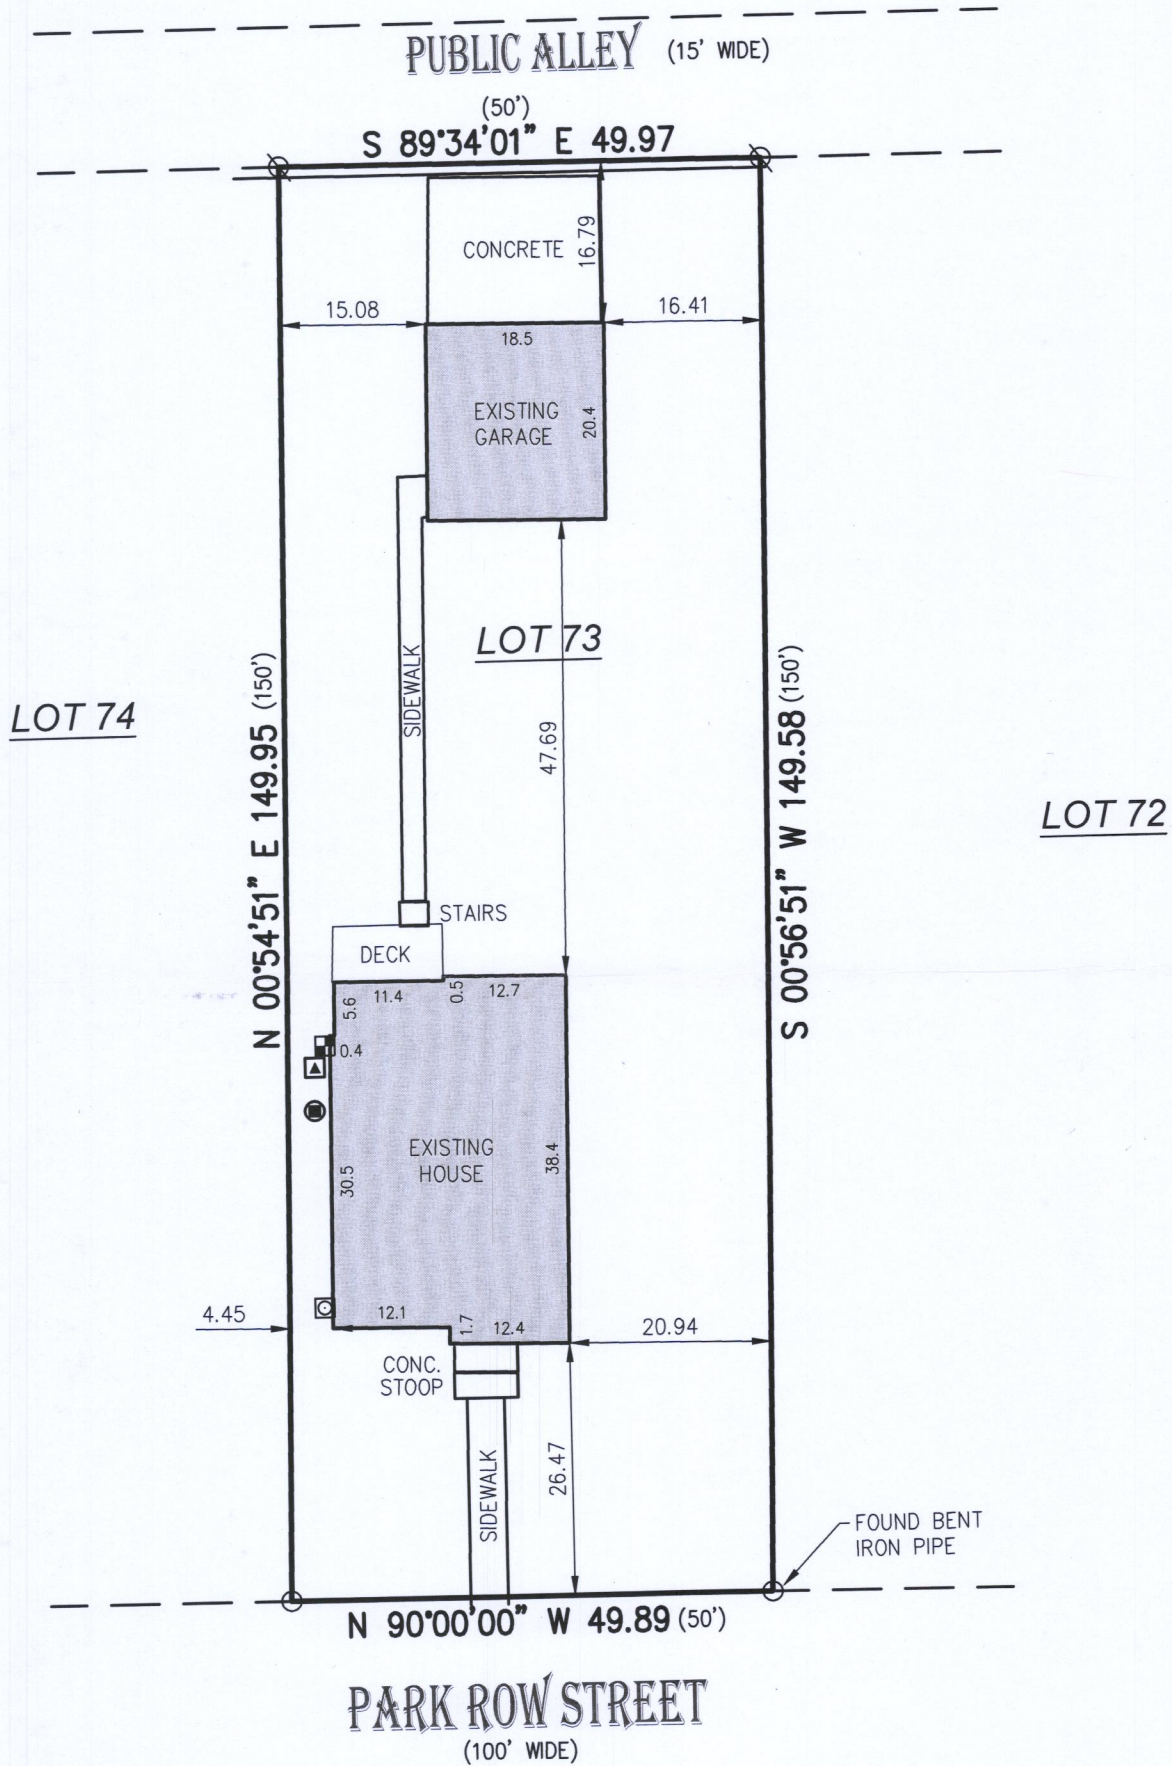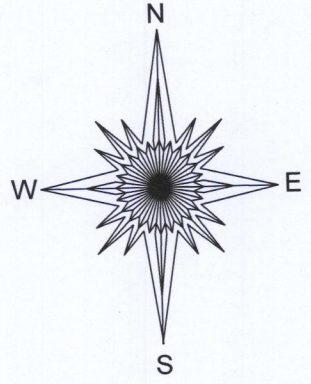


- () = recorded as
■ = electric meter
○ = found iron pipe
□ = gas meter
▲ = hvac
● = concrete lid
⊗ = found gin screw

SCALE 1" = 20'

JOB # 2017.0248.01

TAX ID # ZCL 00061

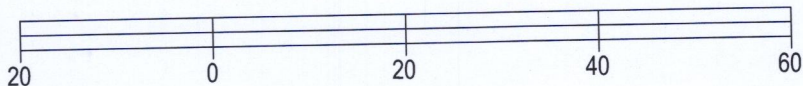


BASIS OF BEARING OF THIS PLAT: THE NORTH LINE OF PARK
ROW STREET ASSUMED TO BEAR N 90°00'00" W.

I hereby certify that I have surveyed the above- described property and the
above map is a true representation thereof and shows the size and
location of the property, its exterior boundaries, the location and dimensions
of all structures thereon, fences, apparent easements and roadways and
visible encroachments if any.

This survey is made for the present owners of the property, and those who
purchase, mortgage, or guarantee the title thereto, within one year from the
date hereof.

DATED THIS 2ND DAY OF NOVEMBER, 2017.

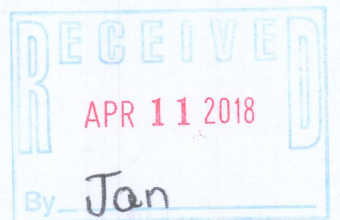

Frank T. Hueller
FRANK T. HUELLER S - 2434
Wisconsin Professional Land Surveyor

ZCL-61

007-3449