

AMBIT LAND SURVEYING
8120-312th Avenue
Wheatland, WI. 53105-8934
Licensed Professionals in
both Illinois & Wisconsin

PLAT OF SURVEY OF


Lot 1 of WALWORTH COUNTY CERTIFIED SURVEY MAP NO. 1347, located in the Southeast Quarter of Section 36, Township 2 North, Range 17 East of the 4th Principal Meridian, City of Lake Geneva, Walworth County, Wisconsin and recorded on March 12, 1984 in Volume 6 of Certified Survey Maps, page 179, as Document 100384 in the office of the Walworth County Register of Deeds.

Parcel Identification Number: ZA 134700001

PHONE: 262-537-4874


FAX: 262-537-4221

EMAIL: ambit@tds.net

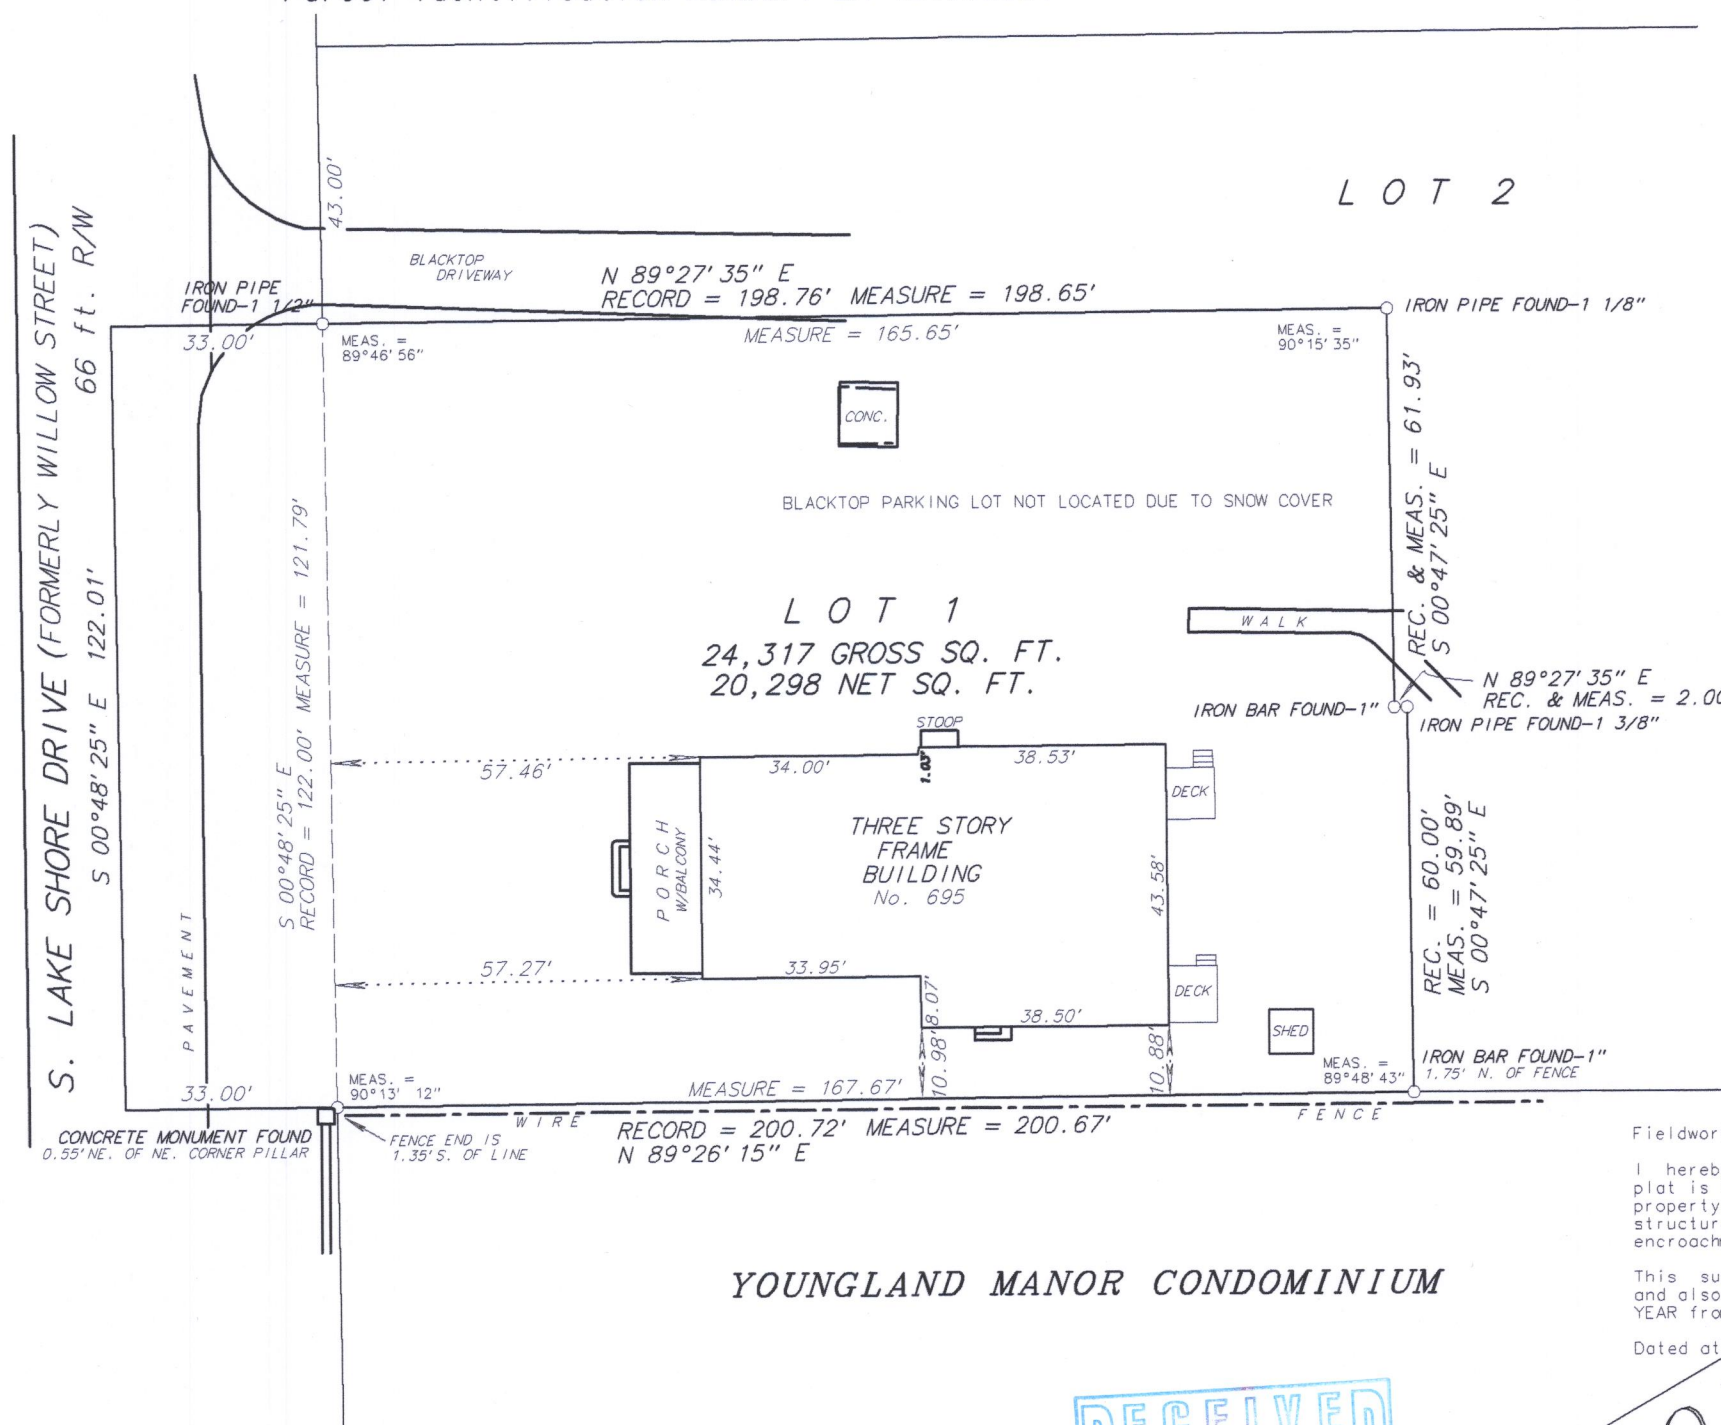

YOUNGLAND MANOR CONDOMINIUM

Fieldwork completed on and date of certification: January 9, 2018
I hereby certify that I have surveyed the above described property and the above plat is a true representation thereof and shows the size and location of the property, its exterior boundaries, the location and dimensions of all visible structures thereon, boundary fences, apparent easements and roadways and visible encroachments, if any.
This survey is made for the exclusive use of the present owners of the property, and also those who purchase, mortgage or guarantee the title thereto within ONE YEAR from the date hereof.
Dated at Bassett, Wisconsin this _____ day of _____ 2018.

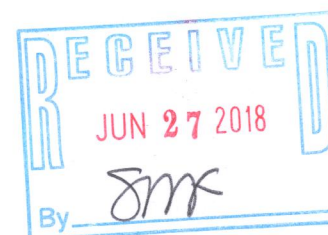

OFFICE COPY

Mark A. Bolender
Wisconsin Professional Land Surveyor - 1784

SCALE: 1 inch = 30 feet

ORDERED BY: K. Lewis/ Lewis & Levinson

JOB NO.: 17276

ZA1347-1

007-3467