



PLAT OF SURVEY
OF LOT 11, BLOCK 23, GENEVA LAKE CRAWFORD
MANUFACTURING COMPANY'S ADDITION TO THE CITY
OF LAKE GENEVA, WALWORTH COUNTY, WISCONSIN.

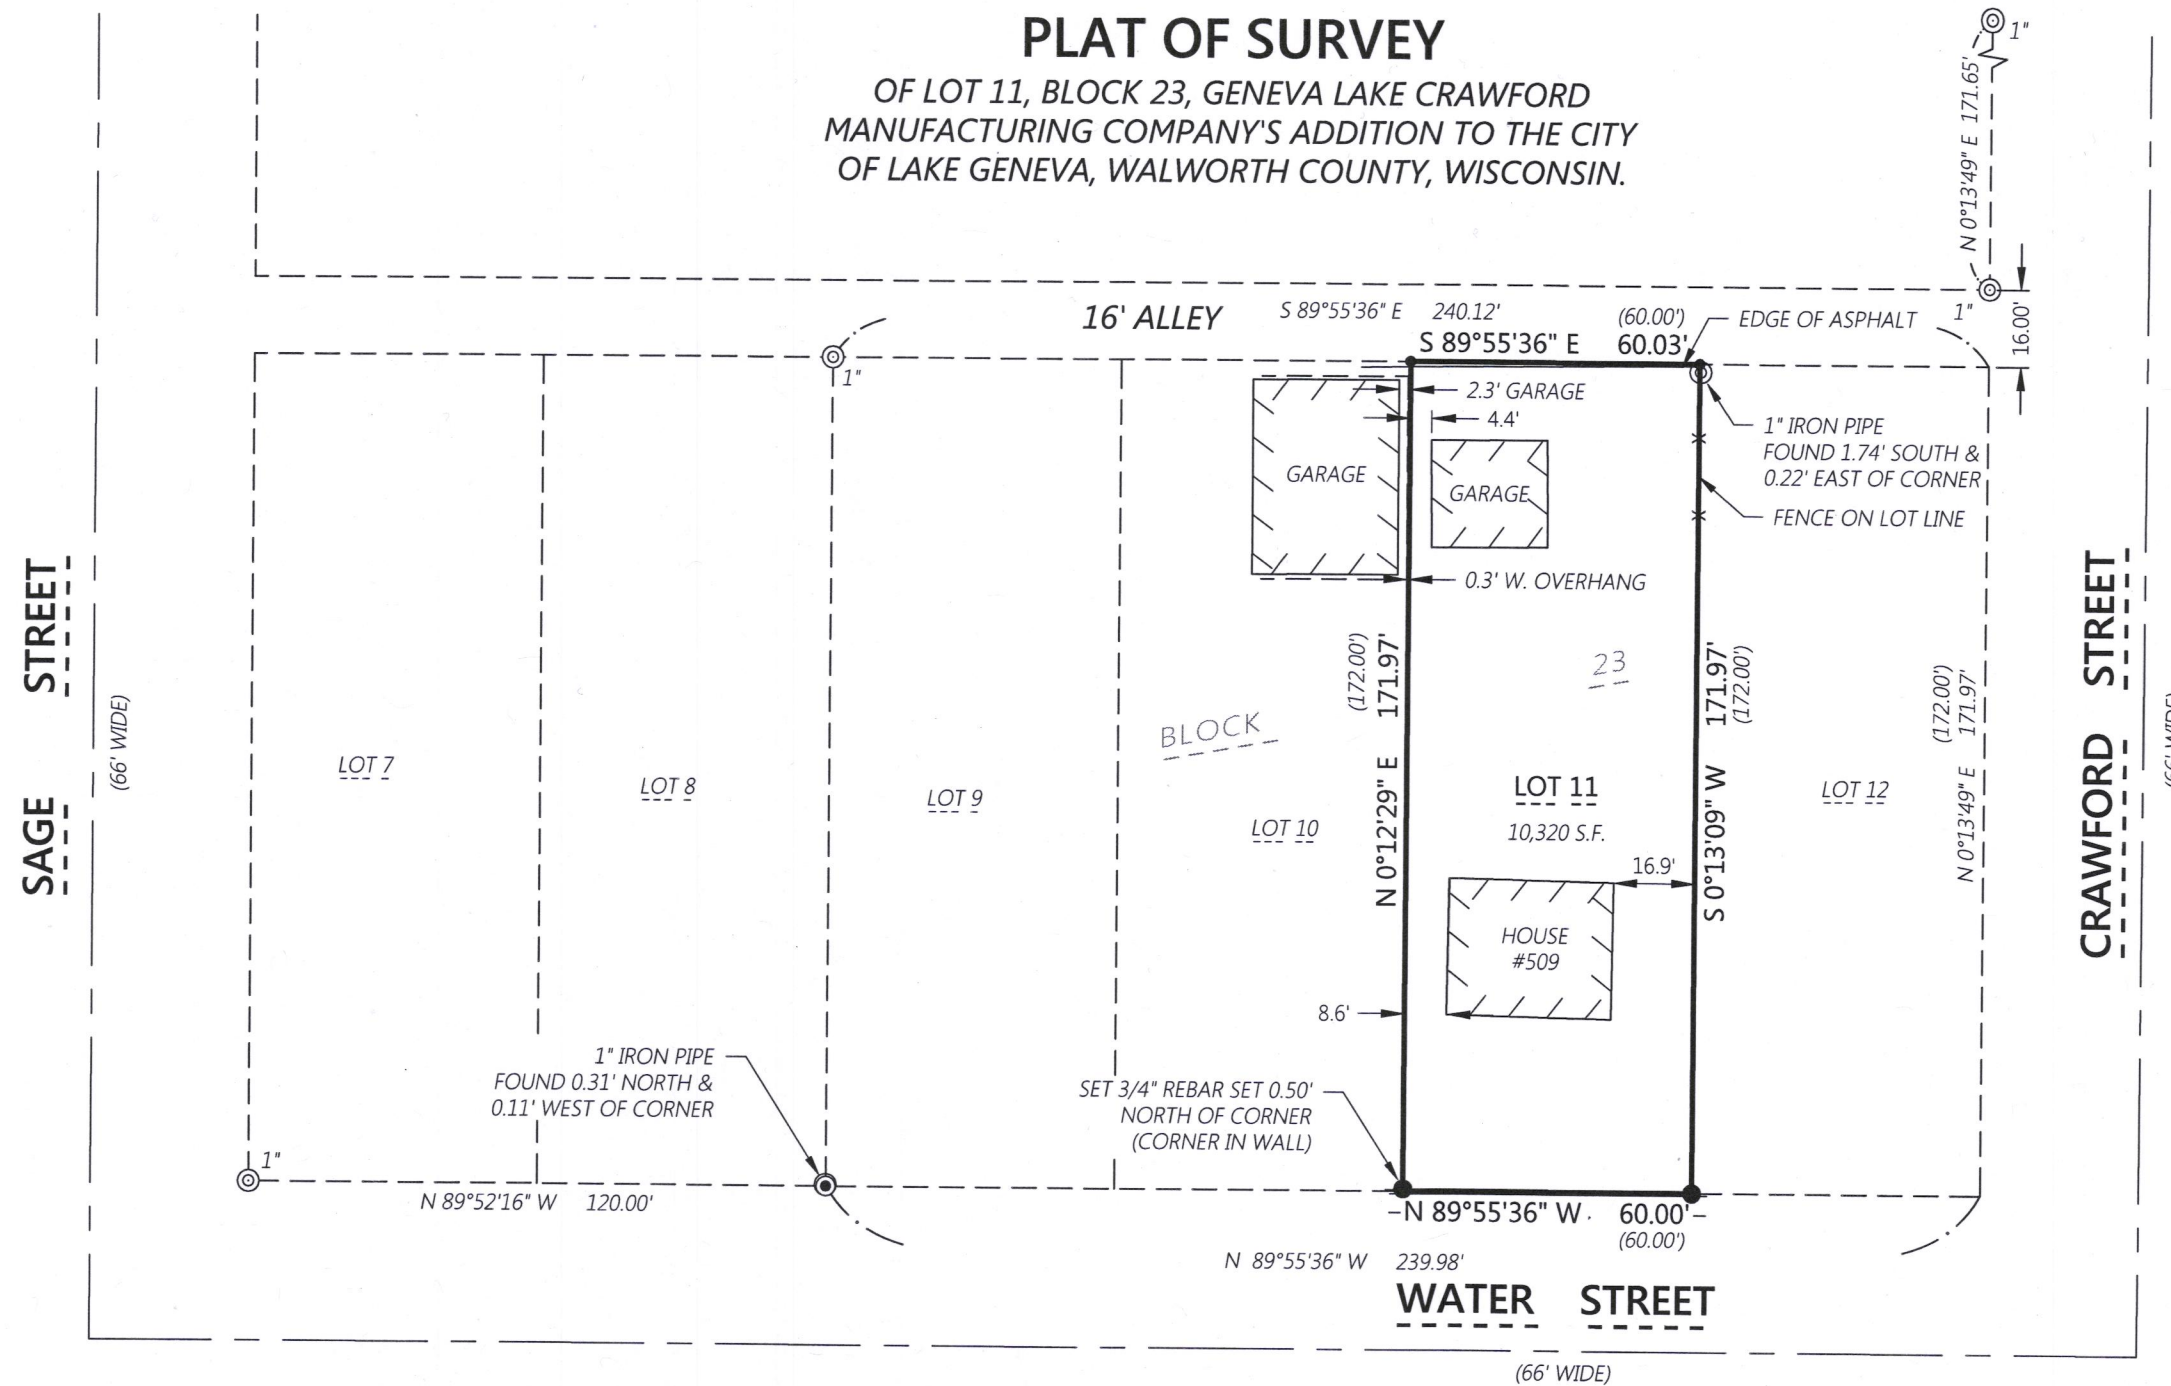

LEGEND

- Iron Rebar Set
3/4" x 24" (1.5 Lbs./Ft.)
- ⊙ Iron Pipe Found
- PK Nail Set
- ⊙ Iron Pipe Found in Concrete
- (XXX.XX) Record Information

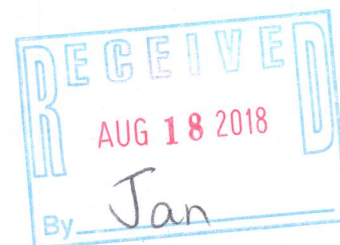

Scale: 1" = 40'

Kristin Belongia

Kristin J. Belongia, P.L.S.
Wisconsin Professional Land Surveyor S-2943

State of Wisconsin } ss
County of Rock

I hereby certify that I have supervised the survey of the property described above and to the best of my knowledge and belief, the plat drawn hereon complies with Chapter A-E 7 of the State of Wisconsin Administrative Code, Minimum Standards for Property Surveys and correctly represents said survey and its location.

Given under my hand and seal this 29th day of June, 2018 at Beloit, Wisconsin.
Last day of field work June 26th, 2018

If the surveyor's signature is not red in color, the plan is a copy that should be assumed to contain unauthorized alterations. The certification contained on this document shall not apply to any copies.