


6/2/27
 Lot 14, Lake Geneva Villa
 found iron stks, N.W.
 L. S. V. Park. from E. end
 laid off piece in N. 2.
 lined in and set iron
 Willow St. line making
 E. line 50' S. line 184.2

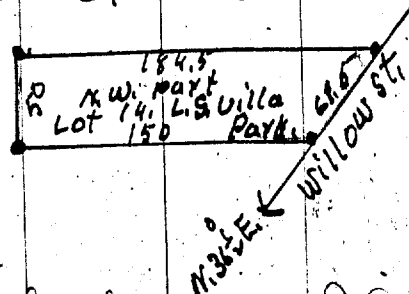

Park.
 N.E. S.E. & S.W. Corners Lot
 Lot 14, above. (Lot 182.3 x 79.2')
 cor. 32 1/2' E + W. by 50' N + S.
 stks at W. points and at
 N. line of tract laid off 150'
 W. line 61.5' Price \$3.50

Was Lot 14 Lake Geneva Villa Park

now Lot 2, 12th, Lake Geneva Villa Park

7-350-Sk