

PREPARED FOR
SOMERSET CONDOS




ORDERED BY
ANGIE JAHNS

PLAT OF SURVEY

- OF -

Units 23, 24 and 25, Somerset Condominium, recorded in Volume
197, Page 323, in the City of Lake Geneva, Walworth County,
Wisconsin.

PATHFINDER SURVEYING
(a NMB Company)
P.O. BOX 322
LAKE GENEVA, WI. 53147
WWW.PATHFINDERSURVEYING.NET
262-248-8303

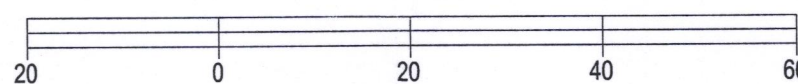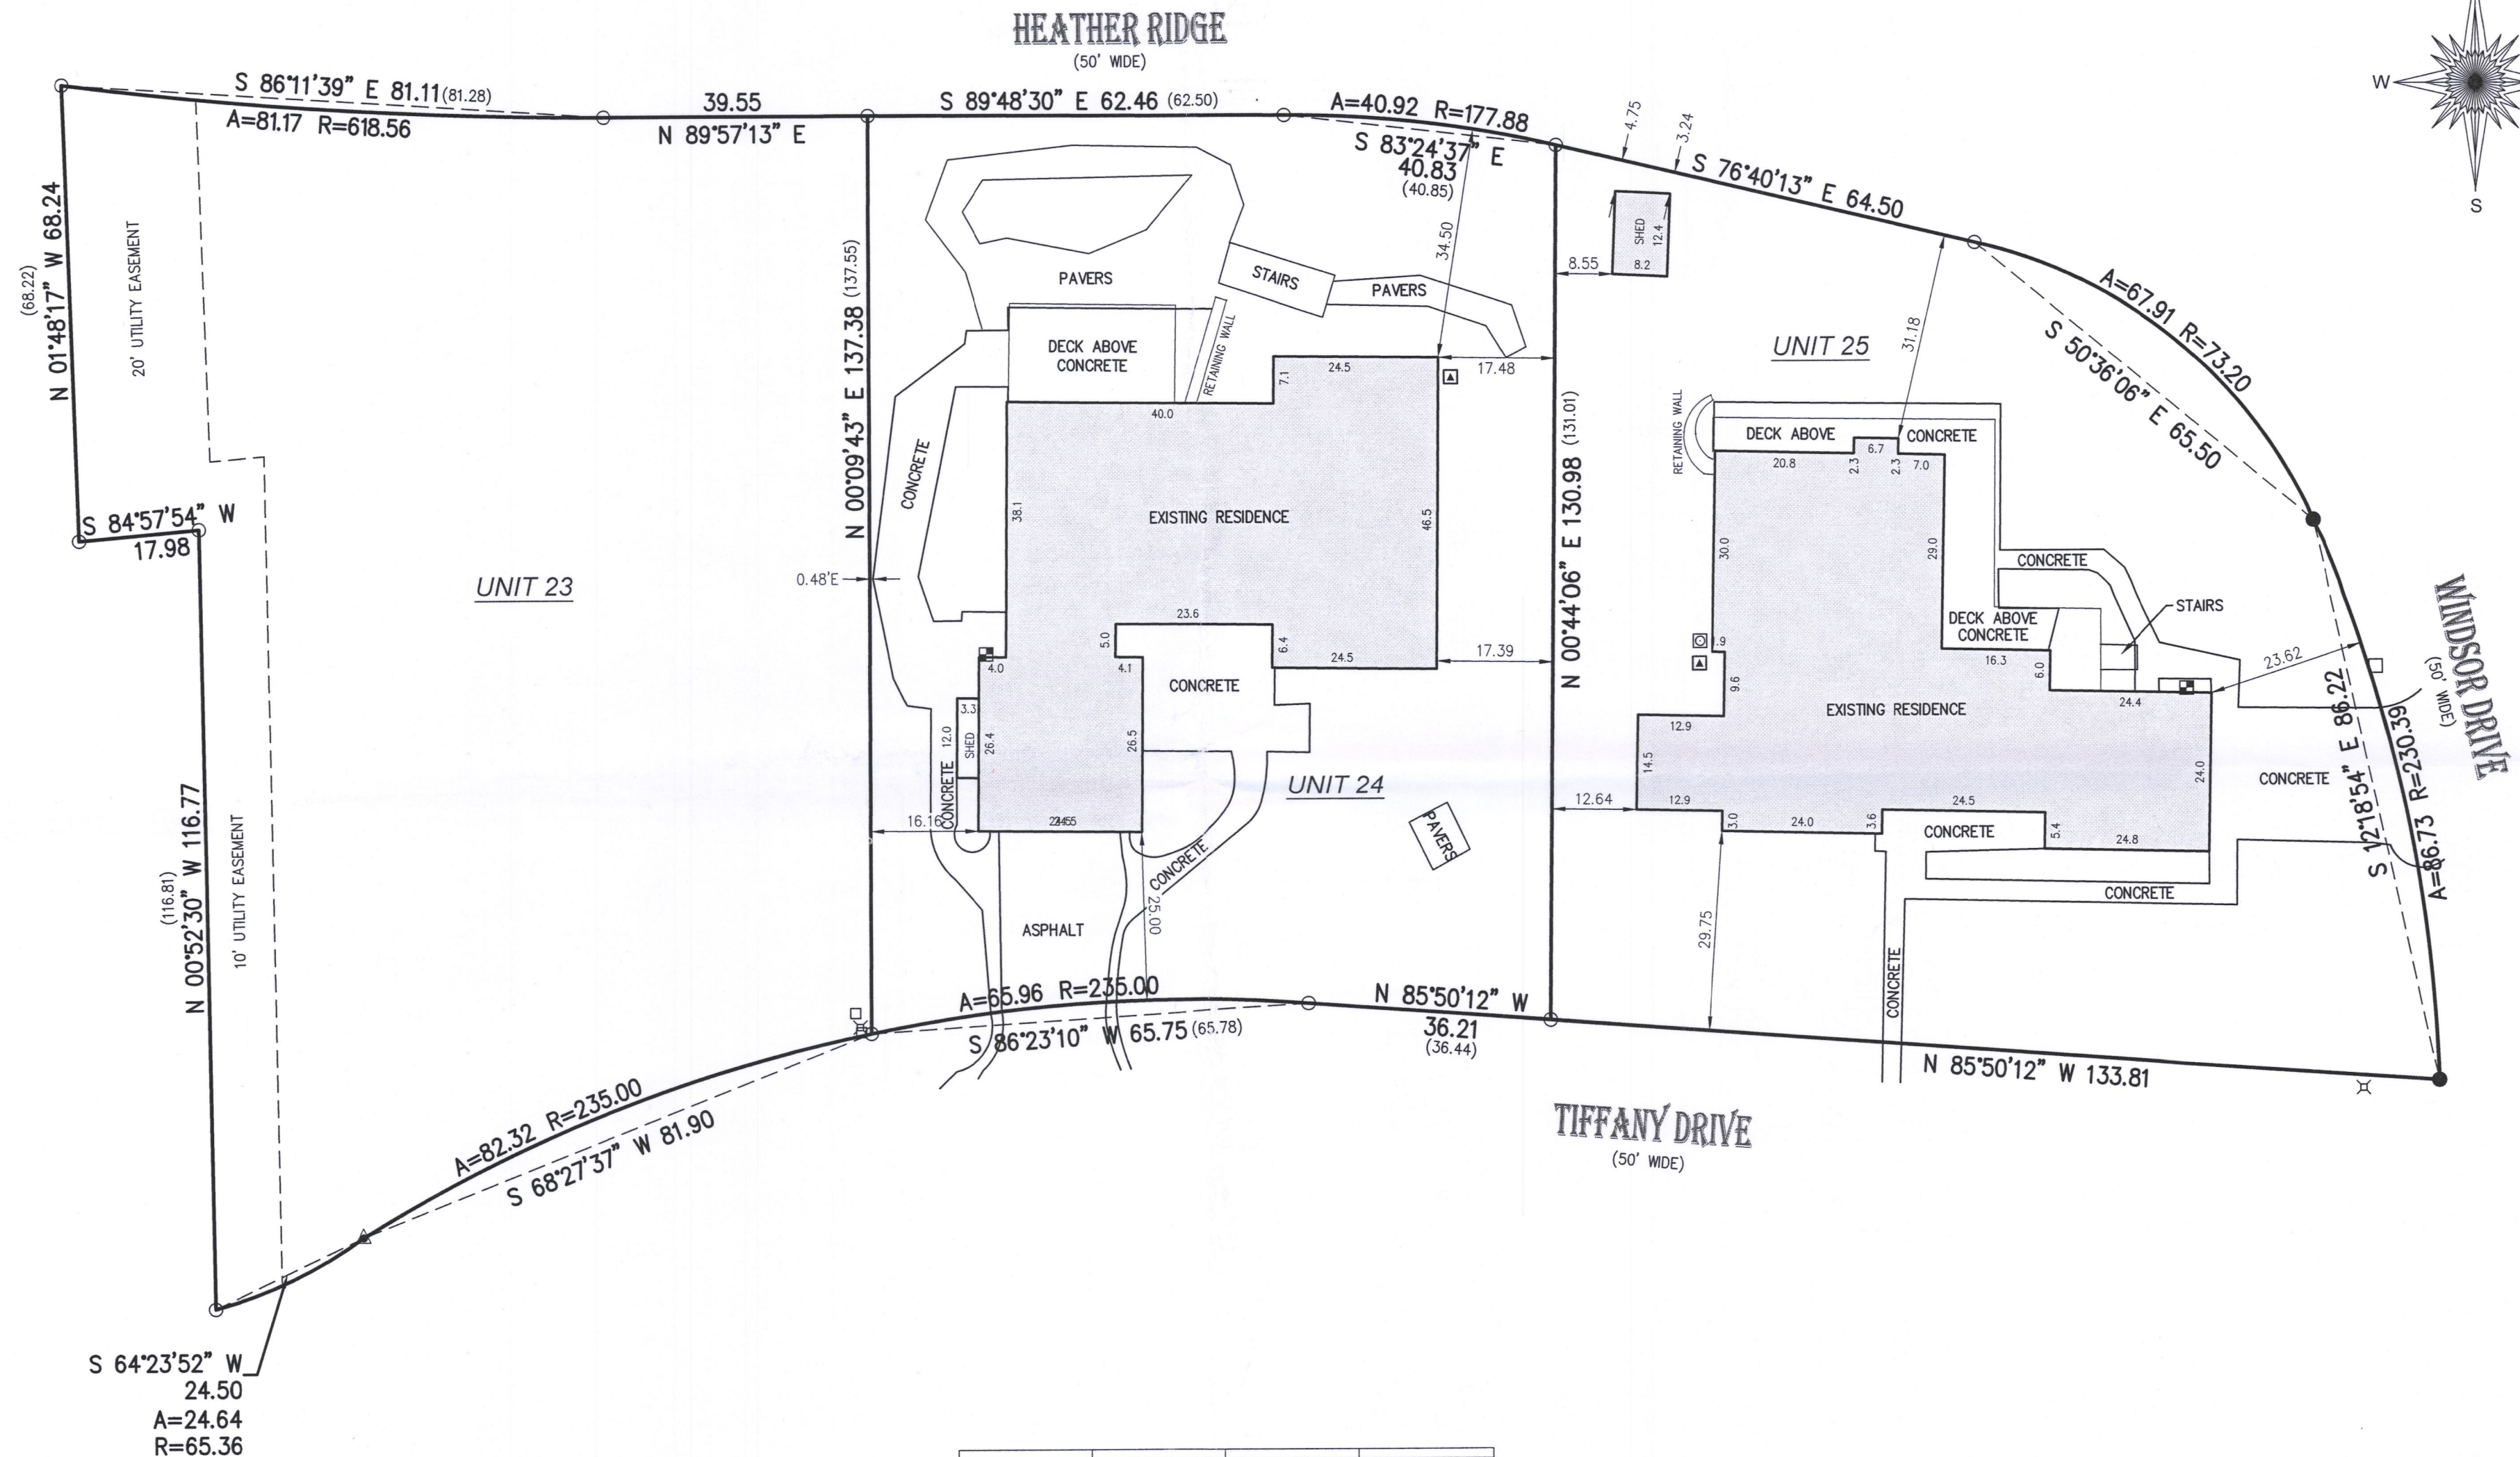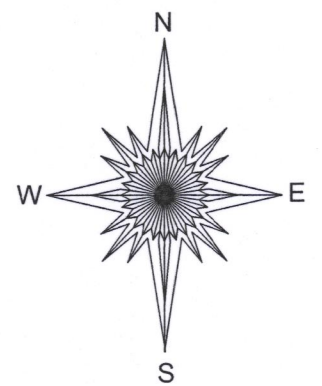


BASIS OF BEARING OF THIS PLAT: THE US STATE PLANE
COORDINATE SYSTEM SOUTH ZONE, NAD 83, WISCONSIN.

I hereby certify that I have surveyed the above- described property and the
above map is a true representation thereof and shows the size and
location of the property, its exterior boundaries, the location and dimensions
of all structures thereon, fences, apparent easements and roadways and
visible encroachments if any to the best of my knowledge and belief.

This survey is made for the present owners of the property, and those who
purchase, mortgage, or guarantee the title thereto, within one year from the
date hereof.

DATED THIS 6th DAY OF AUGUST, 2018.

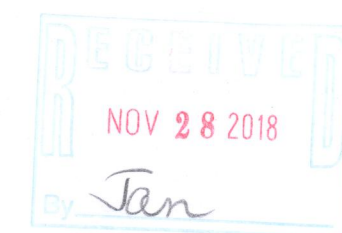

MARK R. MADSEN S - 2271
Wisconsin Professional Land Surveyor

SCALE 1" = 20'

JOB # 2018.0240.01

TAX ID # ZCNS 00023, ZCNS 00024 & ZCNS 00025

ZCNS - 23
ZCNS - 24 007-3521
ZCNS - 25