


41 11/27 1916 surveyed lot for Mrs. L. Burton

Lots 10, 11, & 12 Block 10, Lake Geneva.
 Lot 2 previously surveyed and W. line stakes set. On line with west line lot 2, run line south for W. line lot 11, set stake 16' S. of S.W. Cor. of lot 2, and also at also at S.W. Cor. lot 11, which S.W. Cor. is 123.5' W. of inside E fence on Madison St. and 60' E. of W. line lot 10.
 Measured W. on S. line of alley 60' and set stake for N.W. Cor. lot 10. Fence at this 1.4' E. of line but on line at slat fence south.
 Measured from Waites S.W. Cor. to W. line lot 11. 5.8'. Measured from Waites N.W. Cor. to W. line lot 11. 6.5'.
 Measured E. from S.W. Cor. lot 11 3.5' and set stake.
 Excess is due to W. line Madison St. being too far east making original Burton lots 178.5' on N. line and 175.5' on S. "

42

The sale to E. Waite was 120' E. & W. and 60' N. & S. measured W. from Walker property line as occupied and south from alley 1717' as occupied.

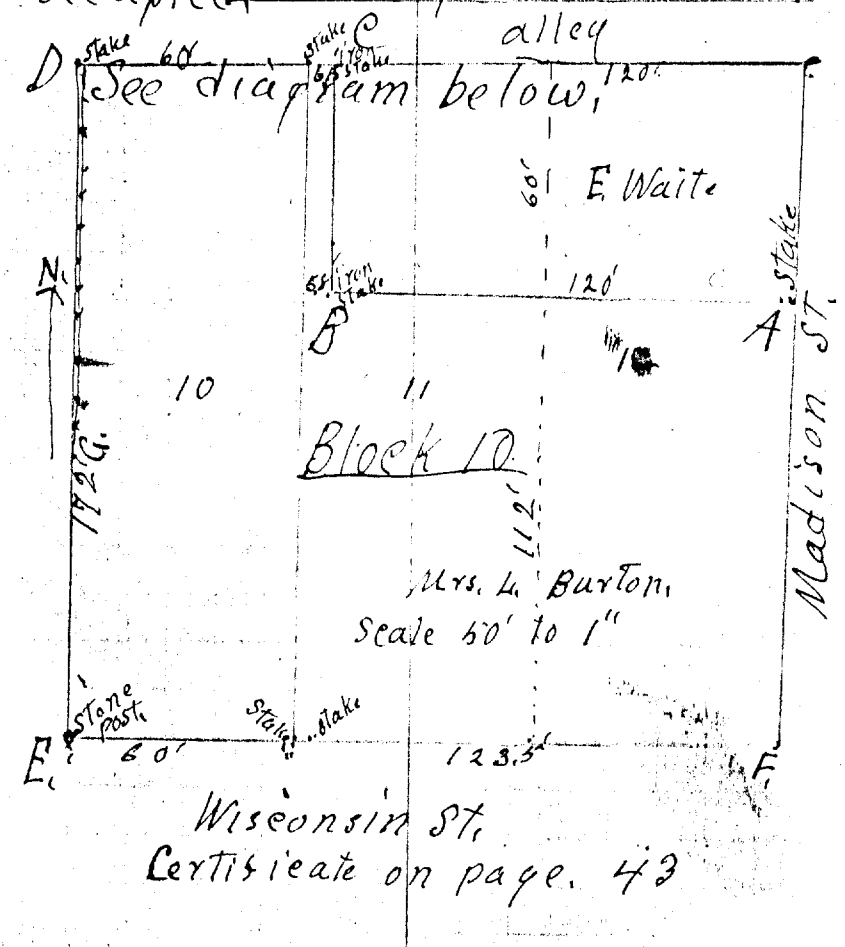

Wisconsin St.
 Certificate on page 43

43

Nov. 25 1716

I have surveyed for Mrs. L. Burton
 Lot 10 Block 10 Lake Geneva
 Wis., and set stakes as indicated
 The E line of occupation being
 E of W. line of Madison St.
 makes lot 12 66.5' wide at N. end
 and 63.5' at S. end
 E. Waiter's lot being previously
 set off 120' W. of line of
 occupation and 60' S. of
 S. alley line makes the
 distance from N. E. Cor. of
 lot 10 to N. W. Cor. of Waiter's
 lot 6.5' and from his S. W.
 Cor. to E line lot 10, 5.8'
 and the S. line of lots 10, 11,
 12 183.5' and the remaining
 Burton lot is the portion ABDEFA
 From A to B the W. fence is E.
 of the line as indicated

J. C. Skeels
 Surveyor

44

Measured W. on S. line of Alley 60' and set stake for N.W. corner Lot 10. Fence at this point is 1.4' E. of line but on line at slat fence south.

Measured from Waites' S.W. corner to W. line Lot 11, 5.8'. Measured from Waites' N.W. corner to W. line Lot 11, 6.5'.

Measured E. from S.W. corner Lot 11, 3.5' and set stake. Excess is due to W. Line Madison St. being too far East, making original Burton lots 178.5' on N. line and 175.5' on South line.

The sale to E. Waite was 120' E. & W. and 60' N. & S. measured West from property line as occupied and south from alley line as occupied.

Certificate.

I have surveyed for Mrs. L. Burton Lot 10, Block 10, Lake Geneva, Wis. and set stakes as indicated. The East line of occupation being E. of W. line of Madison St. makes Lot 12 66.5' wide at N. end and 63.5' at S. end. E. Waites' lot being previously set off 120' W. of line of occupation and 60' south of S. Alley line makes the distance from N.E. cor. of Lot 10 to N.W. corner of Waites lot 6.5' and from his S.W. Corner to E. line Lot 10, 5.8' and the South line of Lots 10, 11 & 12 183.5' and the remaining Burton lot is the portion ABCDEFA. From G to D the W. fence is E of the line as indicated.

