


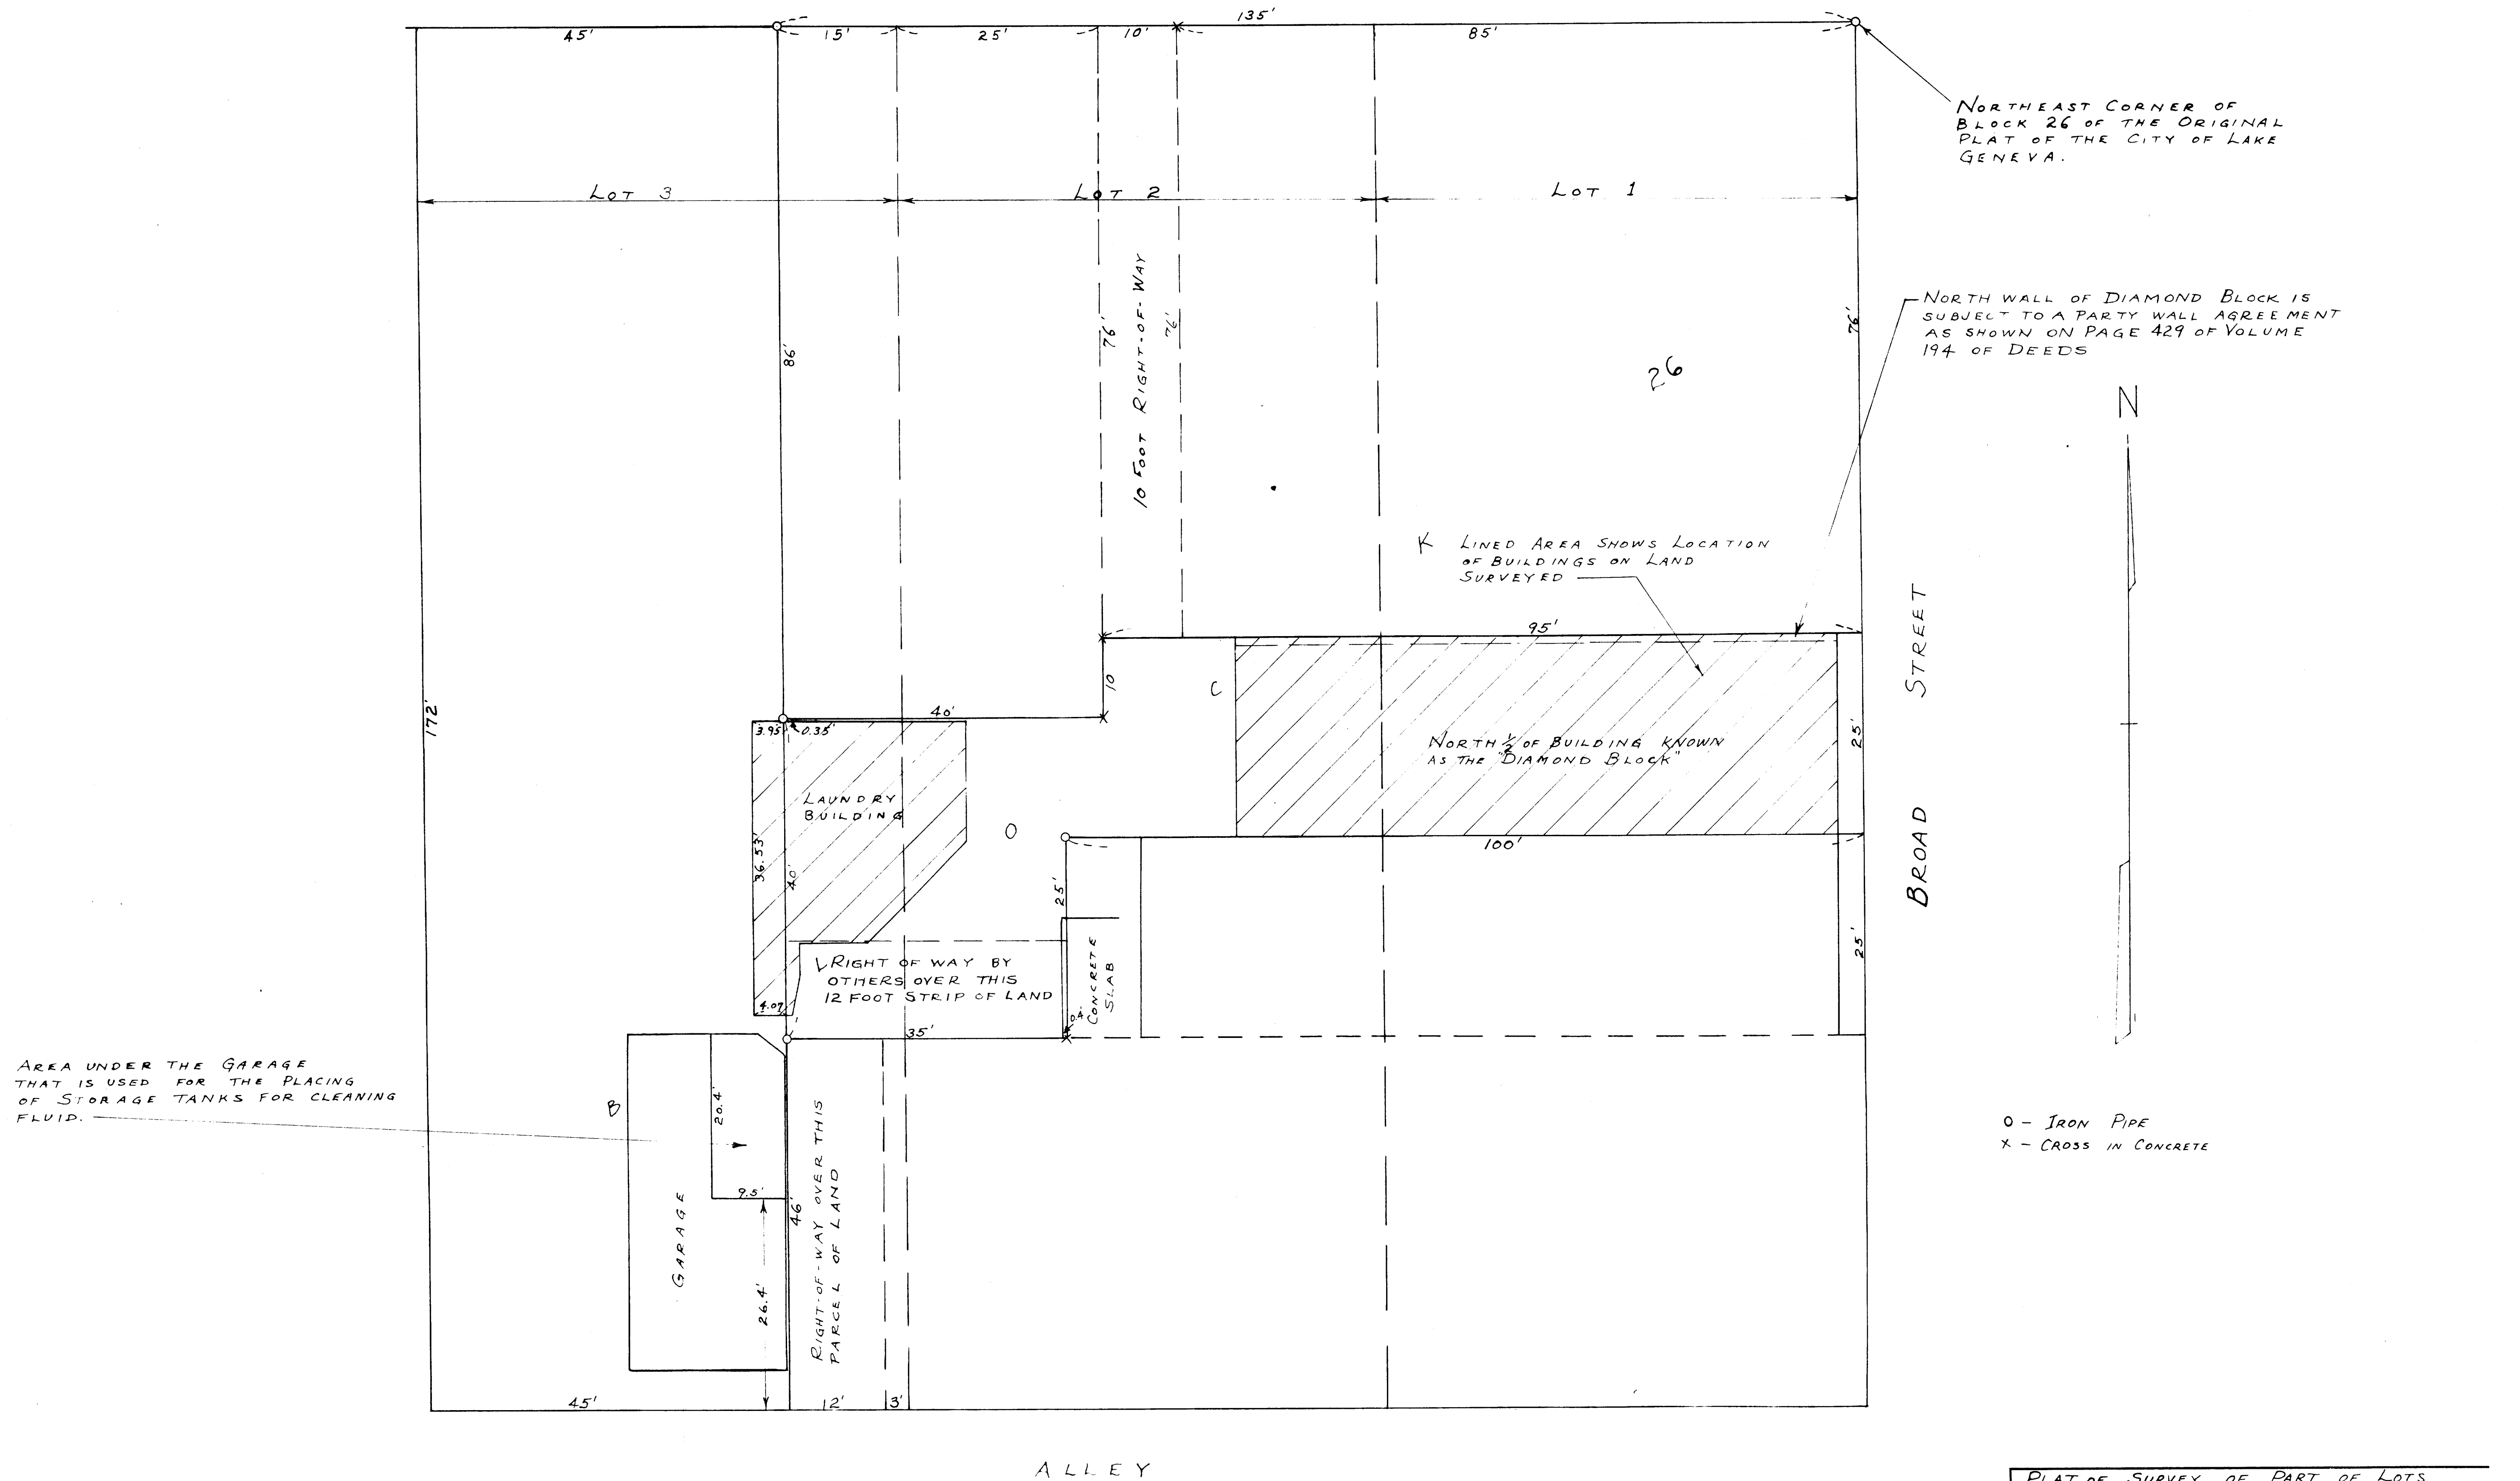

PLAT OF SURVEY OF PART OF LOTS 1, 2 AND 3 OF BLOCK 26 OF THE ORIGINAL PLAT OF THE CITY OF LAKE GENEVA, WATWORTH COUNTY, WISCONSIN	
<i>Lloyd L. Jensen</i> COUNTY SURVEYOR	March 1954 DATE
DRAWN BY	SCALE: 1" = 10'
CHECKED BY	REVISED
APPROVED BY	SHEET NO. OF 7-35J

JENSEN & JOHNSON
CIVIL ENGINEERS
ELKHORN, WIS.