


# PLAT OF SURVEY & TOPOGRAPHIC MAPPING LOTS 31 & 32 OF BLOCK 31 OF LAKE GENEVA MANOR

LOCATED IN PART OF THE SE 1/4 OF THE NE 1/4 OF SECTION 35,  
TOWN 2 NORTH, RANGE 17 EAST, CITY OF LAKE GENEVA,  
WALWORTH COUNTY, WISCONSIN

ASSIGNED THE EASTERLY BOUNDARY OF LOT 32  
S 27°43'30" E

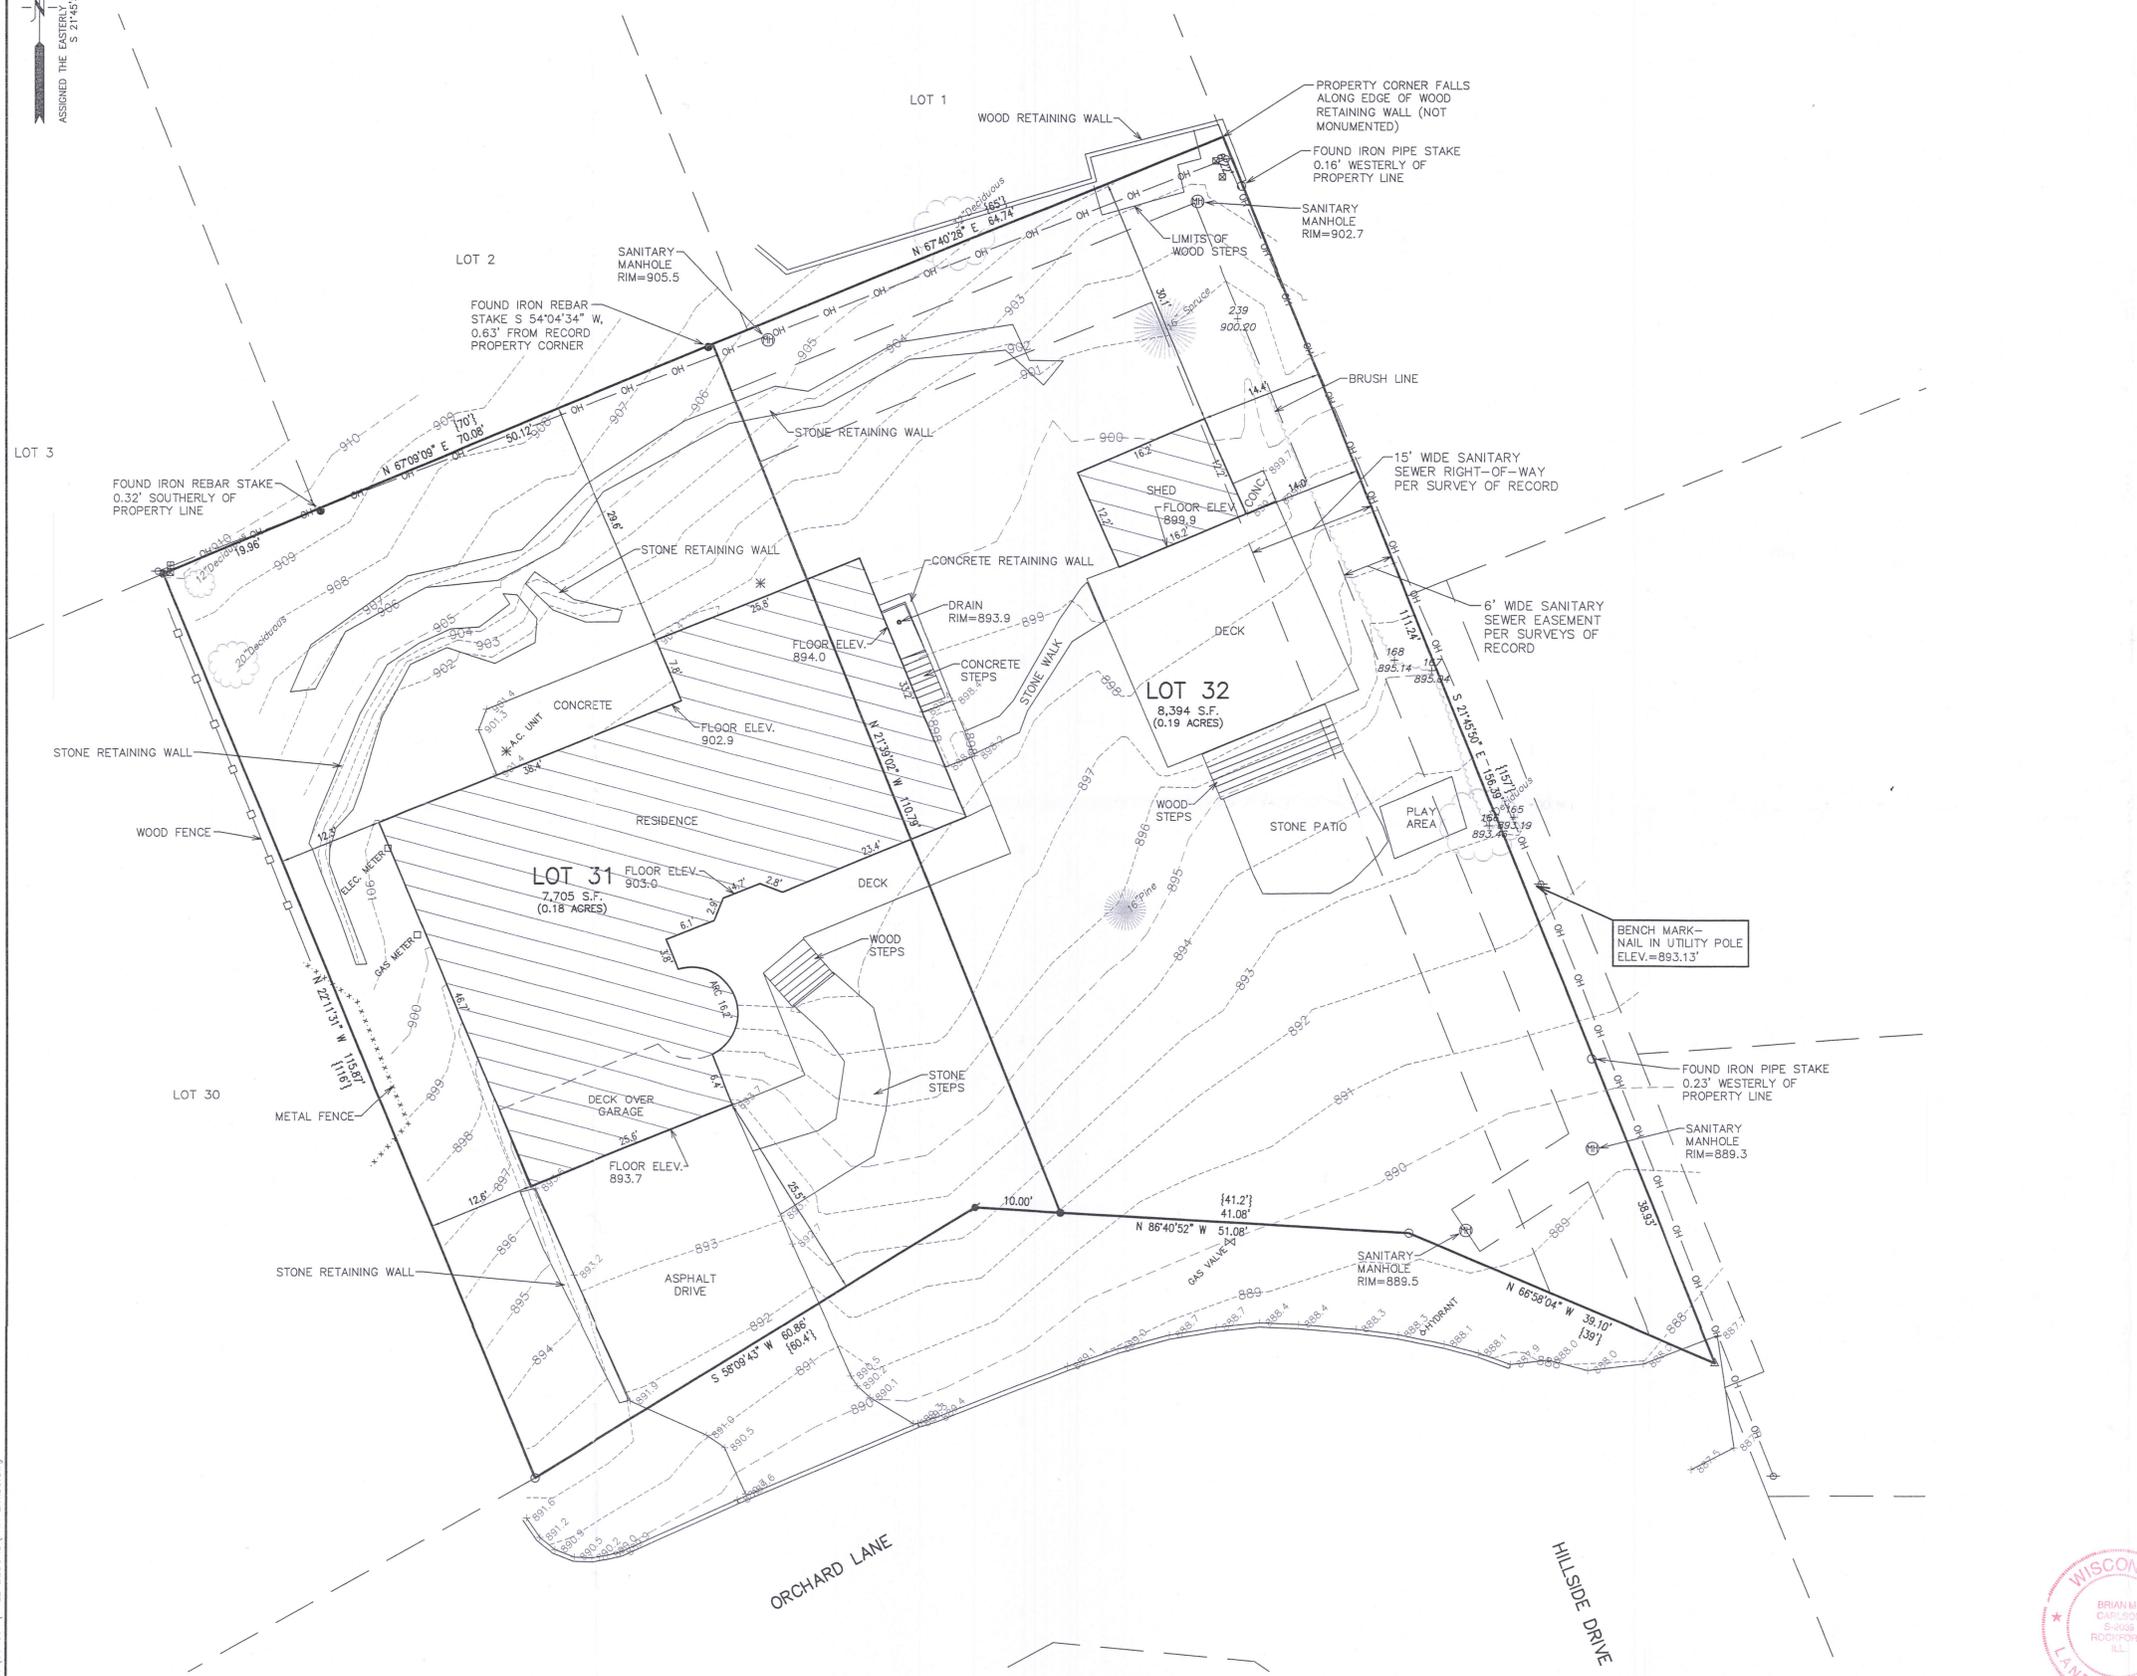

- LEGEND**
- = FOUND IRON PIPE STAKE
  - = FOUND IRON REBAR STAKE
  - △ = FOUND "MAG NAIL" IN PAVEMENT
  - ✦ = SET IRON REBAR STAKE
  - ⊕ = UTILITY POLE LOCATED
  - OH = OVERHEAD WIRES LOCATED
  - ☒ = TELEPHONE UTILITY BOX LOCATED
  - ☒ = ELECTRIC UTILITY BOX LOCATED
  - {XXX} = RECORDED AS

RECEIVED  
APR 16 2019  
By Jan


NOTE: COPIES OF THIS MAP TO WHICH THE FOLLOWING CERTIFICATE WILL APPLY SHOW THE SURVEYOR'S ORIGINAL SEAL AND SIGNATURE IN RED INK. COPIES BY ANY OTHER MEANS MAY HAVE ALTERATIONS WHICH DO NOT REPRESENT THE SURVEYOR'S WORK PRODUCT.

I HEREBY CERTIFY THAT THE ABOVE DESCRIBED PROPERTY HAS BEEN SURVEYED UNDER MY DIRECTION AND THAT THE ABOVE MAP IS A TRUE REPRESENTATION THEREOF AND SHOWS THE SIZE AND LOCATION OF THE PROPERTY AND ITS EXTERIOR BOUNDARIES. THIS SURVEY IS MADE FOR THE USE OF THE PRESENT OWNERS OF THE PROPERTY, AND ALSO THOSE WHO PURCHASE, MORTGAGE, OR GUARANTEE THE TITLE THERETO WITHIN ONE YEAR FROM THE DATE HEREOF.



DATED: 3/28/2019

Brian M. Carlson  
P.L.S. 2039

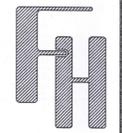

**SURVEY & TOPOGRAPHY**  
1551 ORCHARD LANE  
LAKE GENEVA, WI

WORK ORDERED BY -  
PETER JUERGENS  
N2689 SUNSET BOULEVARD  
LAKE GENEVA, WI 53147

**FARRIS, HANSEN & ASSOCIATES, INC.**  
ENGINEERING - ARCHITECTURE - SURVEYING  
7 RIDGWAY COURT P.O. BOX 437  
ELKHORN, WISCONSIN 53121  
OFFICE: (262) 723-2098 FAX: (262) 723-5886

REVISIONS

PROJECT NO.  
3479.19  
DATE  
03/28/2019  
SHEET NO.  
1 OF 1

X:\Acad\_Soft\Carlson\TITLE\_BLOCKS\PH1A\_24x36.dwg