


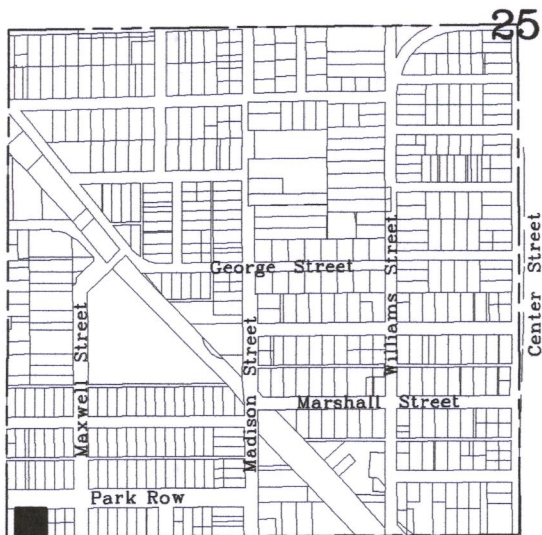

Location Sketch
Southwest 1/4 of Section 25
Town 2 North, Range 17 East
1" = 1000'

ALTA/NSPS Land Title Survey

of

A parcel of land described in Title Commitment No. 918121047 prepared by First American Title Insurance Company, dated December 11, 2018, Revision no. 1, as shown below:

Parcel 1:
Lot 117 and the West 1/2 of Lot 118 of Columbian Subdivision, according to the recorded plat thereof. Said land being in the City of Lake Geneva, Walworth County, Wisconsin.


Together with an easement for driveway purposes 7.5 feet in width, and located in Lot 118, Columbian Subdivision, City of Lake Geneva, Walworth County, Wisconsin, the West line of which is described as follows: Beginning at the midpoint in the North, line of said Lot 118, thence South 105 feet, along the North-South centerline of said Lot 118, to the place of termination.

Parcel 2:
Lot 119 and East 1/2 of Lot 118, Columbian Subdivision, according to the recorded plat thereof. Said land being in the City of Lake Geneva, Walworth County, Wisconsin.

Together with an easement for driveway purposes 7.5 feet in width, and located in Lot 118, Columbian Subdivision, City of Lake Geneva, Walworth County, Wisconsin, the East line of which is described as follows: Beginning at the midpoint in the North line of said Lot 118; thence South 105 feet along the North-South centerline of said Lot 118, to the place of termination.

Schedule B, of Title Commitment No. 9018121047 prepared by First American Title Insurance Company, dated December 11, 2018, Revision no. 1, lists easements and restrictions as shown below:

- Terms and provisions as set forth in a Driveway Agreement recorded in Volume 580 of Records, page 715, as Document No. 238279. EASEMENT SHOWN
- Rights of others in and to and possible charges and assessments as to the maintenance and upkeep of the Easement set forth on Schedule A hereof. EASEMENT SHOWN

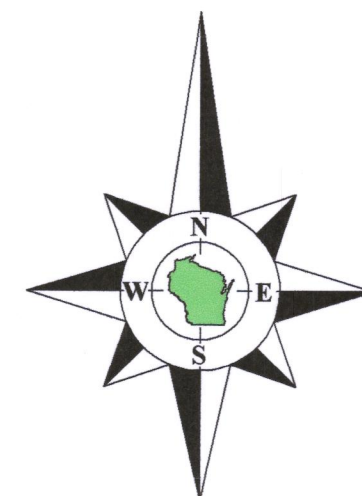

Bearings referenced to the South line of the Southwest 1/4 of Section 25-2-17, recorded as N89°26'03"E in the Wisconsin State Plane Coordinate System, South Zone, (NAD-27).

Coordinates are referenced to the Wisconsin State Plane Coordinate System, South Zone, (NAD-27).

Notes:


- According to Flood Insurance Rate Map (FIRM) No. 55127C0327D for Walworth County, Wisconsin and Incorporated Areas, Effective date: October 2, 2009, this site falls in Zone X: Areas determined to be outside the 0.2% annual chance floodplain.
- There are no regular or handicapped marked parking spaces on this site.
- In regards to Table A item 11, visible utilities are shown. No plans were requested or provided and no diggers hotline marking was requested.

To: John T. Walker
First American Title Insurance



This is to certify that this map or plat and the survey on which it is based were made in accordance with the 2016 Minimum Standard Detail Requirements for ALTA/NSPS Land Title Surveys, jointly established and adopted by ALTA and NSPS, and includes items 1, 2, 3, 4, 7(a), 8, 9, 11, 13 and 16 of Table A thereof.

The field work was completed on January 8, 2019.


January 8, 2019.

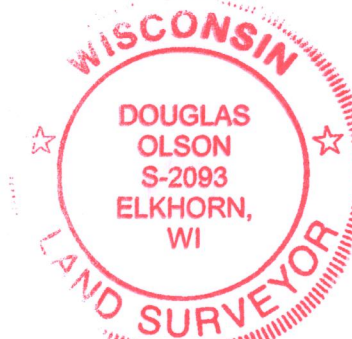

Douglas G. Olson
Wisconsin Professional Land Surveyor - 2093

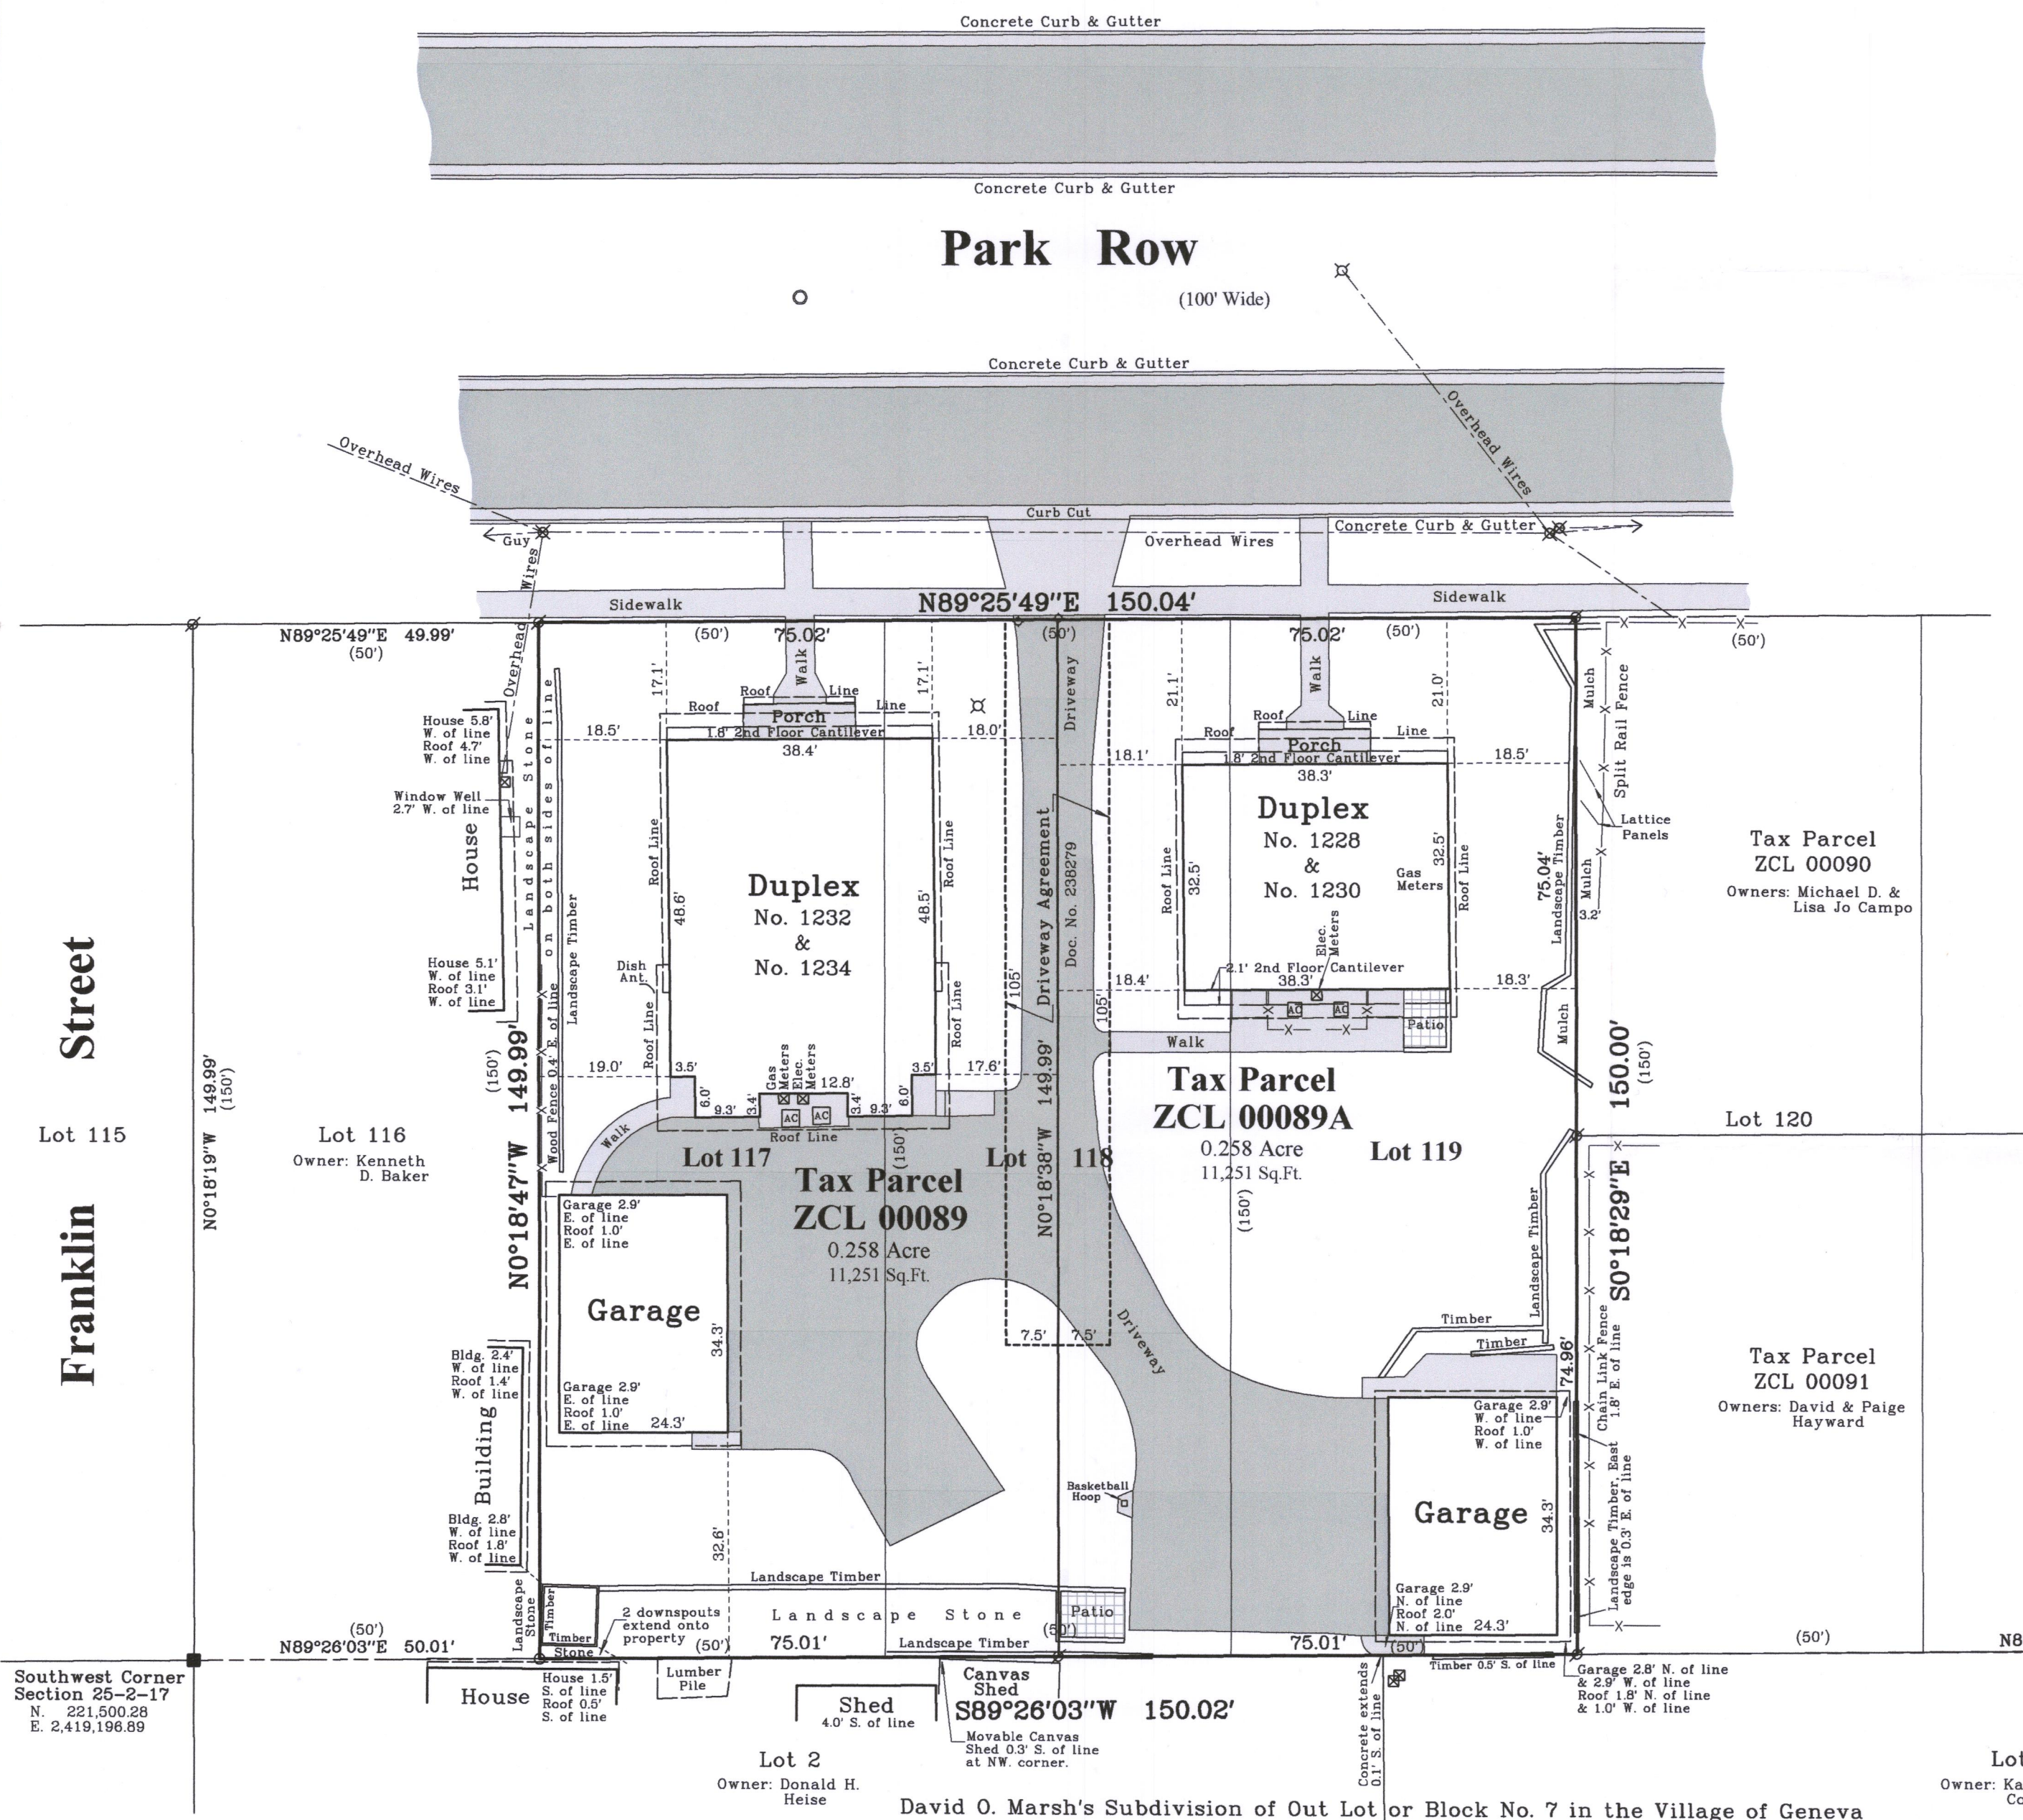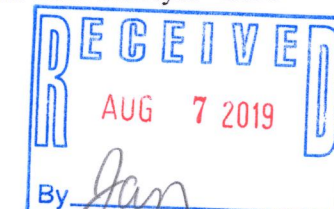

Survey Date: January 8, 2019.
Revisions: No. 1 - Tax Parcel No.

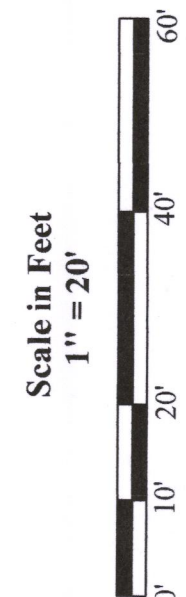

45 South Wisconsin Street | P.O. Box 322
Elkhorn, Wisconsin 53121
Telephone: (262) 723-5434
Facsimile: (262) 723-8044
Email: doug@olsonsurveying.com
Website: www.olsonsurveying.com

OLSON
LAND SURVEYING, LLC
Rural | Residential | Commercial

Legend of Symbols & Abbreviations
North
South
East
West
Bearing
In
Line
Light Pole or Lamp
Utility Pedestal
Manhole
Asphalt Surface
Concrete Surface
Landscape Stone
Found County Section Corner
Found Iron Pipe, 1" dia.
Recorded Information
Light Pole or Lamp
Utility Pedestal
Manhole
Asphalt Surface
Concrete Surface

Sheet 1 of 1 Sheets
Job Reference Number
2018.169

2018.169