


35 April 26-1934
 Survey for Jacob Dale
 The North end of
 Lot B, Geneva Blk,

Begin at an iron stake
 at the intersection of
 the S.W. line of Logan
 Ave. and the West line
 of the Boulevard ~~subdivision~~
 in the S.E. Cor. of the
 of the original plat
 of Geneva Village. Thence
 South to East in the S.W.
 line of Logan Ave 1700 ft
 to an iron stake. Thence
 West 123 ft. to an iron
 stake in the East line of
 the Boulevard and at
 right angles North in and
 East line 208.6' to the
 point of beginning.

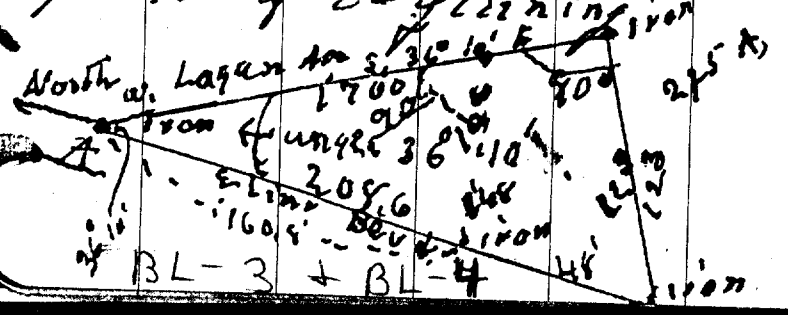

36 See page 34 36

Description
 Begin at an iron stake
 at S.W. line Logan Ave
 S.E. 36-10 E. 1700 ft
 an iron stake. Thence at
 an angled W. along south line
 of an excavation 123' to an
 iron stake. Thence North
 in E line of Blvd 48' to

an iron stake. Thence in
 same line N. 160.6' to pt.
 of beginning. Entire W.
 line is 208.6' from
 inter of S.W. line of Logan
 Ave. to S.W. cor. of this
 subdivision

84550 sq. ft
42460
40990
2125A

J. L. Shulo Reg. Engr
 Bessie M. Palmer Asst

37 Jacob Dale

corrected survey

Boulevard subdivision

April 25

Begin at an iron sth.
at intersection of ~~East~~
half Geneva Blvd subdivision
and West line of Logan
Lake Geneva Wis.

thence South east on
~~East~~ West line of ~~Blvd~~
to Logan Avenue 180'
to an iron sth.

thence at rt angles,
West ~~to~~ 131.8' to an iron
sth in West Line Blvd
sub. thence North, 223.1'

to point of beginning
going over an iron
sth 145.5' N. to an iron
sth thence to point of

beginning containing
127 Acres

Divided into 3 parcels

A the A B & C

A the whole A

see plat G. 174

31. 7/12/26 Survey for Dale

North line Lots 3 & 100.
 (1) North line 405.2
 (2) Line 50' N. 369.05-
 (3) " 100' N. 332.85-
 (4) " 150' N. 296.35-
 (5) " 200' N. 260.45-
 (6) " 288.8 N. 195.5 Sect.
 (7) " 338.8 N. 160. (50 N. of Sect
 (8) " 388.8 N. 123.2 (100 N. " "
 (9) " 438.8 " 88.8 (150 N. " "

With transit, line was
 to apex of triangle
 apex of triangle is 267'
 Distances middle line

Distances W. line { 1-2 50-
 6-7,
 9 to apex 117,
 Distance

Road side { 1 to 61.72, 2-
 5-6 109.3, 6 to
 9 - apex 148.6
 Sect. line to apex

West line - Section
 angle at S. W.

(Set stake at E. line, S. E. Cor. Otto

Brothers,

Boulevard subdivision

3 is N. lot - Otto Young

Divided 202.6, 8 402.6
 " 184.5 8 184.55-
 " 166.45 " 166.40
 " 148.30 " 148.24-
 " 130.25 " 130.20
 " 97.75 " 97.75-

line " not divided

" " " "

run from middle of line (1)

N. of Sect. line

1-2, 53.15, 2-3 53.25, 3-4 53.15-
 4-5 53.15, 5-6 93.9, 6-7 53.15-
 7-8 53.15, 8-9 53.15
 2-3 50 3-4 50 4-5 50. 5-6 88.8
 50. 7-8 50 8-9 50

117, 9 line to apex 148.6
 on road, section line to apex

3, 61.72 3-4 61.72 4-5 61.72
 7 61.72 7-8 61.72, 8-9 61.72

331.70'
 line to apex 267'

Cor. of lot 101, 90° 15'
 (14 lots,