


PLAT OF SURVEY

LOT 64 OF BOULEVARD SUBDIVISION BEING PART OF THE NE 1/4 OF SECTION 1, TOWNSHIP 1 NORTH, RANGE 17 EAST OF THE 4th PRINCIPAL MERIDIAN AND PART OF THE SE 1/4 OF SECTION 36, TOWNSHIP 2 NORTH, RANGE 17 EAST OF THE 4th PRINCIPAL MERIDIAN, CITY OF LAKE GENEVA, WALWORTH COUNTY, WISCONSIN.

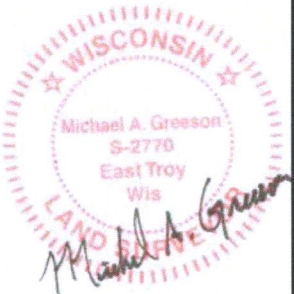

THIS SURVEY IS MADE FOR THE USE OF THE PRESENT OWNERS OF THE PROPERTY, AND ALSO THOSE WHO PURCHASE, MORTGAGE OR GUARANTEE TITLE TO WITHIN ONE (1) YEAR FROM DATE HERETO.

I, MICHAEL A. GREESON P.L.S. #2770, HEREBY CERTIFY THAT THIS SURVEY WAS MADE IN ACCORDANCE WITH THE MINIMUM STANDARDS FOR PROPERTY SURVEYS (CHAPTER A-E 7) FOR THE STATE OF WISCONSIN AND HAS BEEN PREPARED UNDER MY DIRECTION AND CONTROL AND IS CORRECT TO THE BEST OF MY KNOWLEDGE AND BELIEF.


SURVEY MADE FOR:
Patti Bradamore
W6580 N. Walworth Rd
Walworth, WI 53184

DATE	ITEM
10/26/2018	ORIGINAL SURVEY

V²G

SURVEYING, LLC

123 WOLF RUN - SUITE 4
MUKWONAGO, WI 53149
(262) 378-5097

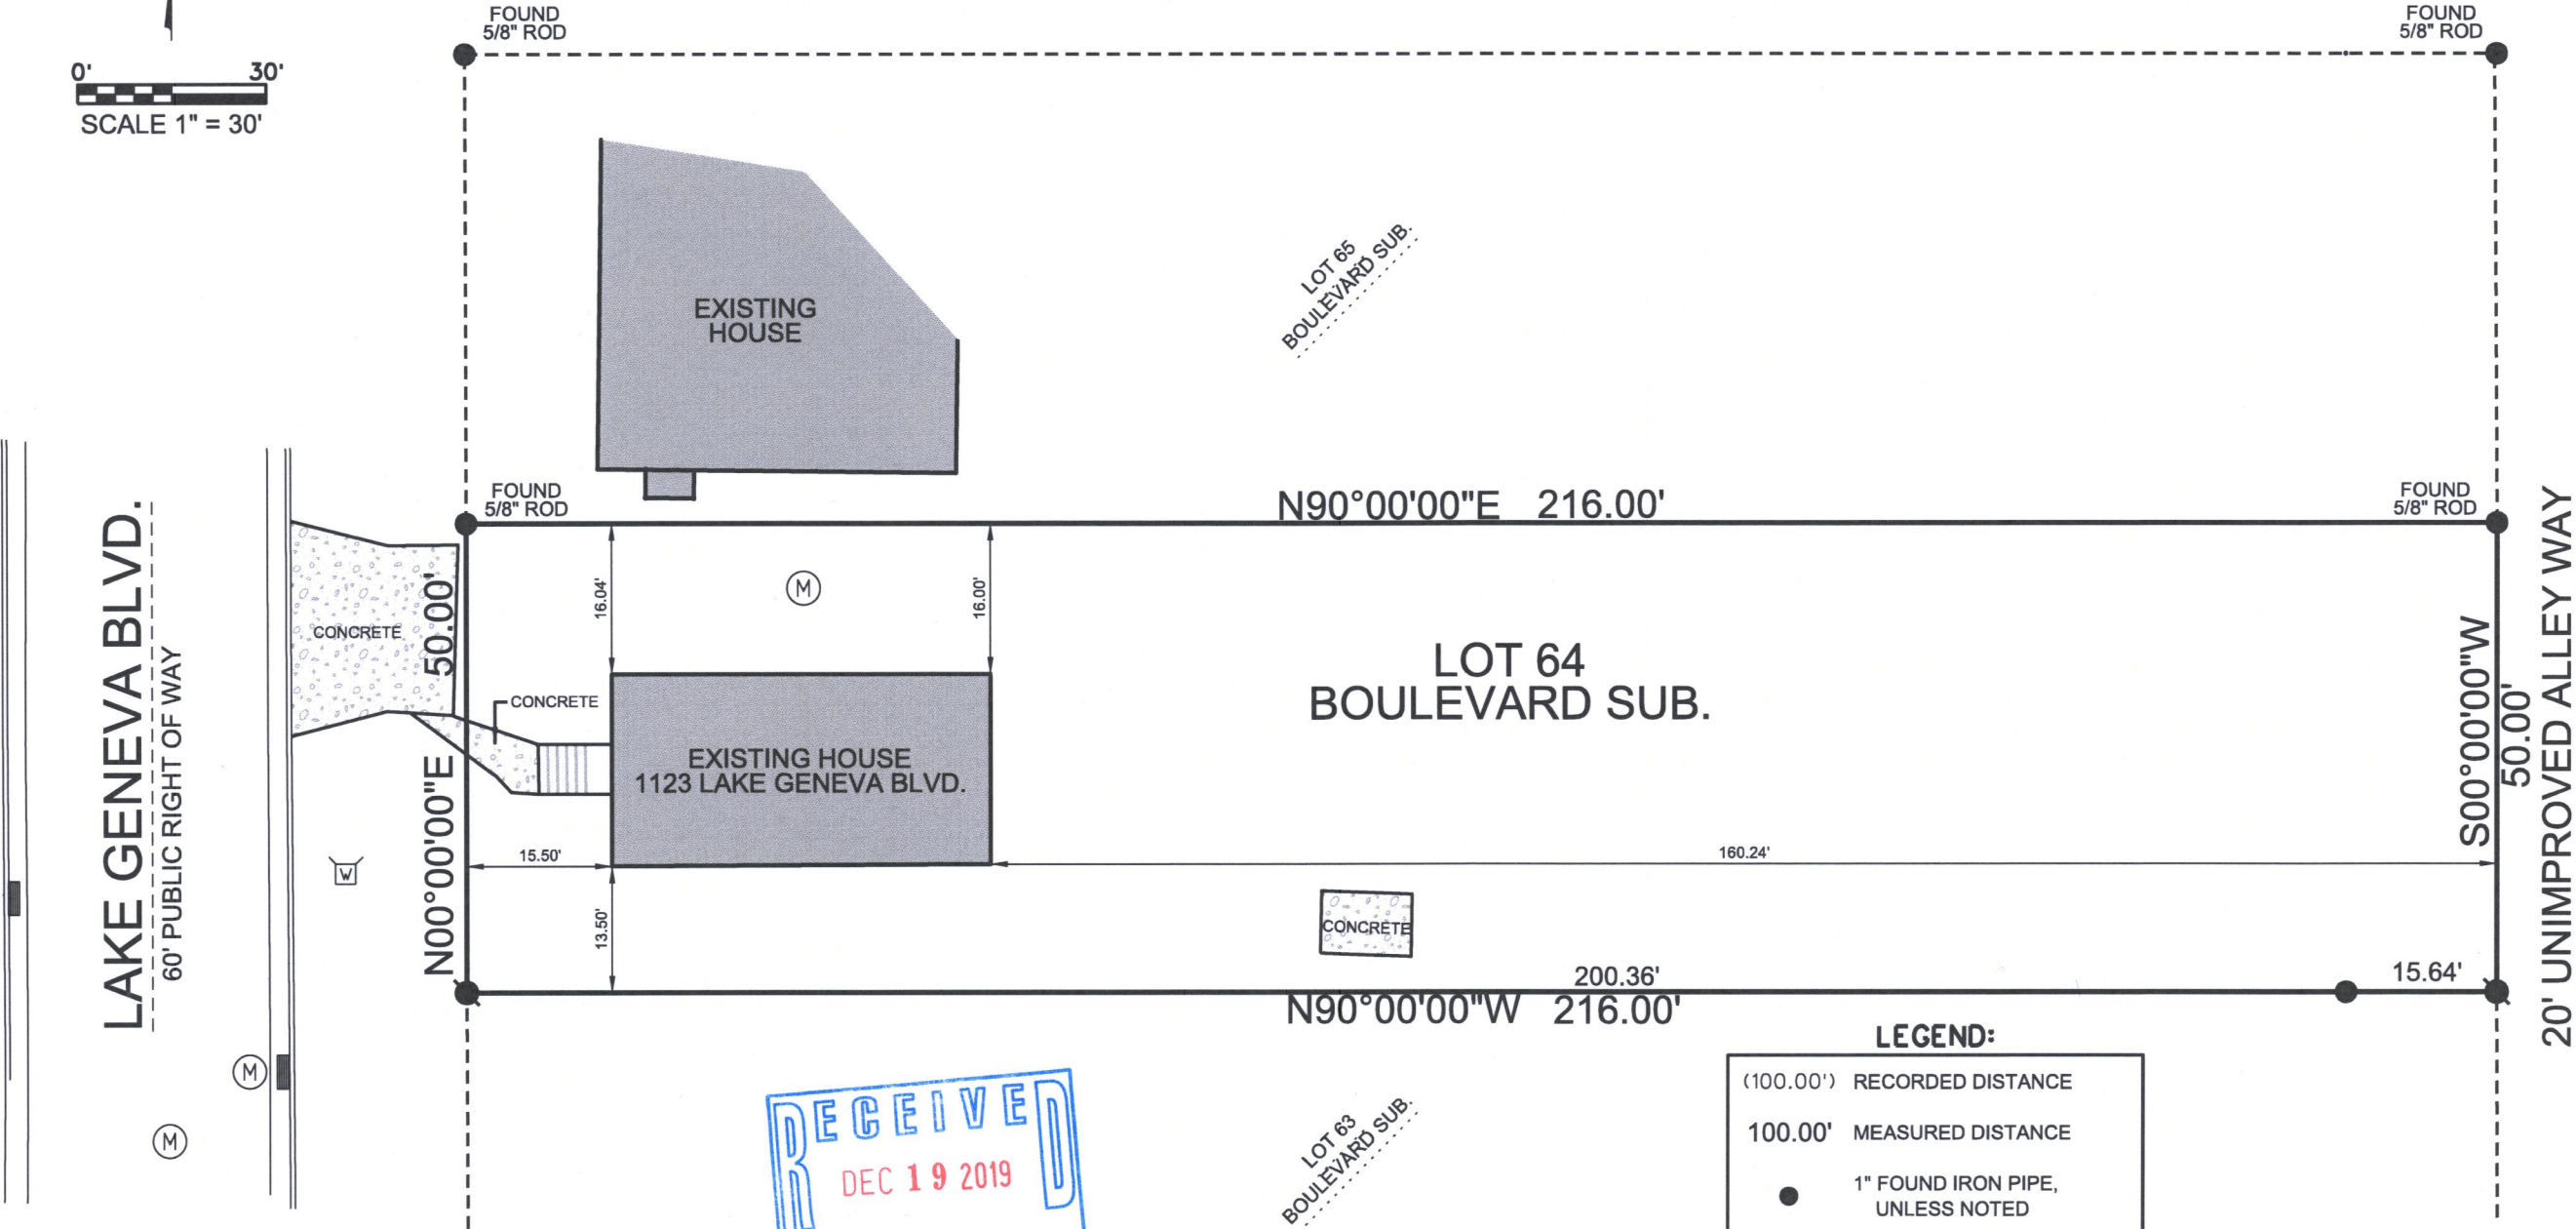

RECEIVED
DEC 19 2019
By *Jan*

LEGEND:

- (100.00') RECORDED DISTANCE
- 100.00' MEASURED DISTANCE
- 1" FOUND IRON PIPE, UNLESS NOTED
- 5/8" x 18" IRON ROD SET, 1.50 lbs./L.F.
- (M) MANHOLE
- W WATER VALVE/BOX
- STORM INLET

NOTE:
NO TITLE COMMITMENT OR RESULTS OF A TITLE SEARCH WERE FURNISHED TO V2G SURVEYING, LLC., PERTAINING TO THIS SURVEY. THIS PLAT OF SURVEY MAY NOT REFLECT EASEMENTS OF RECORD, ENCUMBRANCES, RESTRICTIONS, OWNERSHIP TITLE EVIDENCE, OR OTHER FACTS THAT AN ACCURATE AND CURRENT TITLE SEARCH MAY DISCLOSE.