

REGISTERED PROFESSIONAL LAND SURVEYOR
LAKE GENEVA, WISCONSIN

LAKE GENEVA, WISCONSIN

2

20

—

10' ALLEY

60 23 60

BLOCK

11

12

WARREN STREET 80' WIDE

GENEVA STREET 80' WIDE


φ — IRON PIPE FOUND
 ○ — IRON PIPE PLACED
 ● — CONCRETE MONUMENT
 x — SPIKE

I, HAROLD H. KOLB, DO HEREBY CERTIFY THAT I HAVE SURVEYED THE PROPERTY HEREON DESCRIBED ACCORDING TO THE OFFICIAL RECORDS AND THAT THE PLAT HEREON IS A CORRECT REPRESENTATION OF THE LOT LINES.

Harold H. Hall

HAROLD H. KOLB
WISCONSIN REGISTERED LAND SURVEYOR. S-187

DATE September 1, 1977

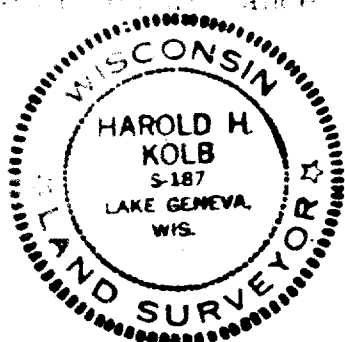

OP-196

7-368