


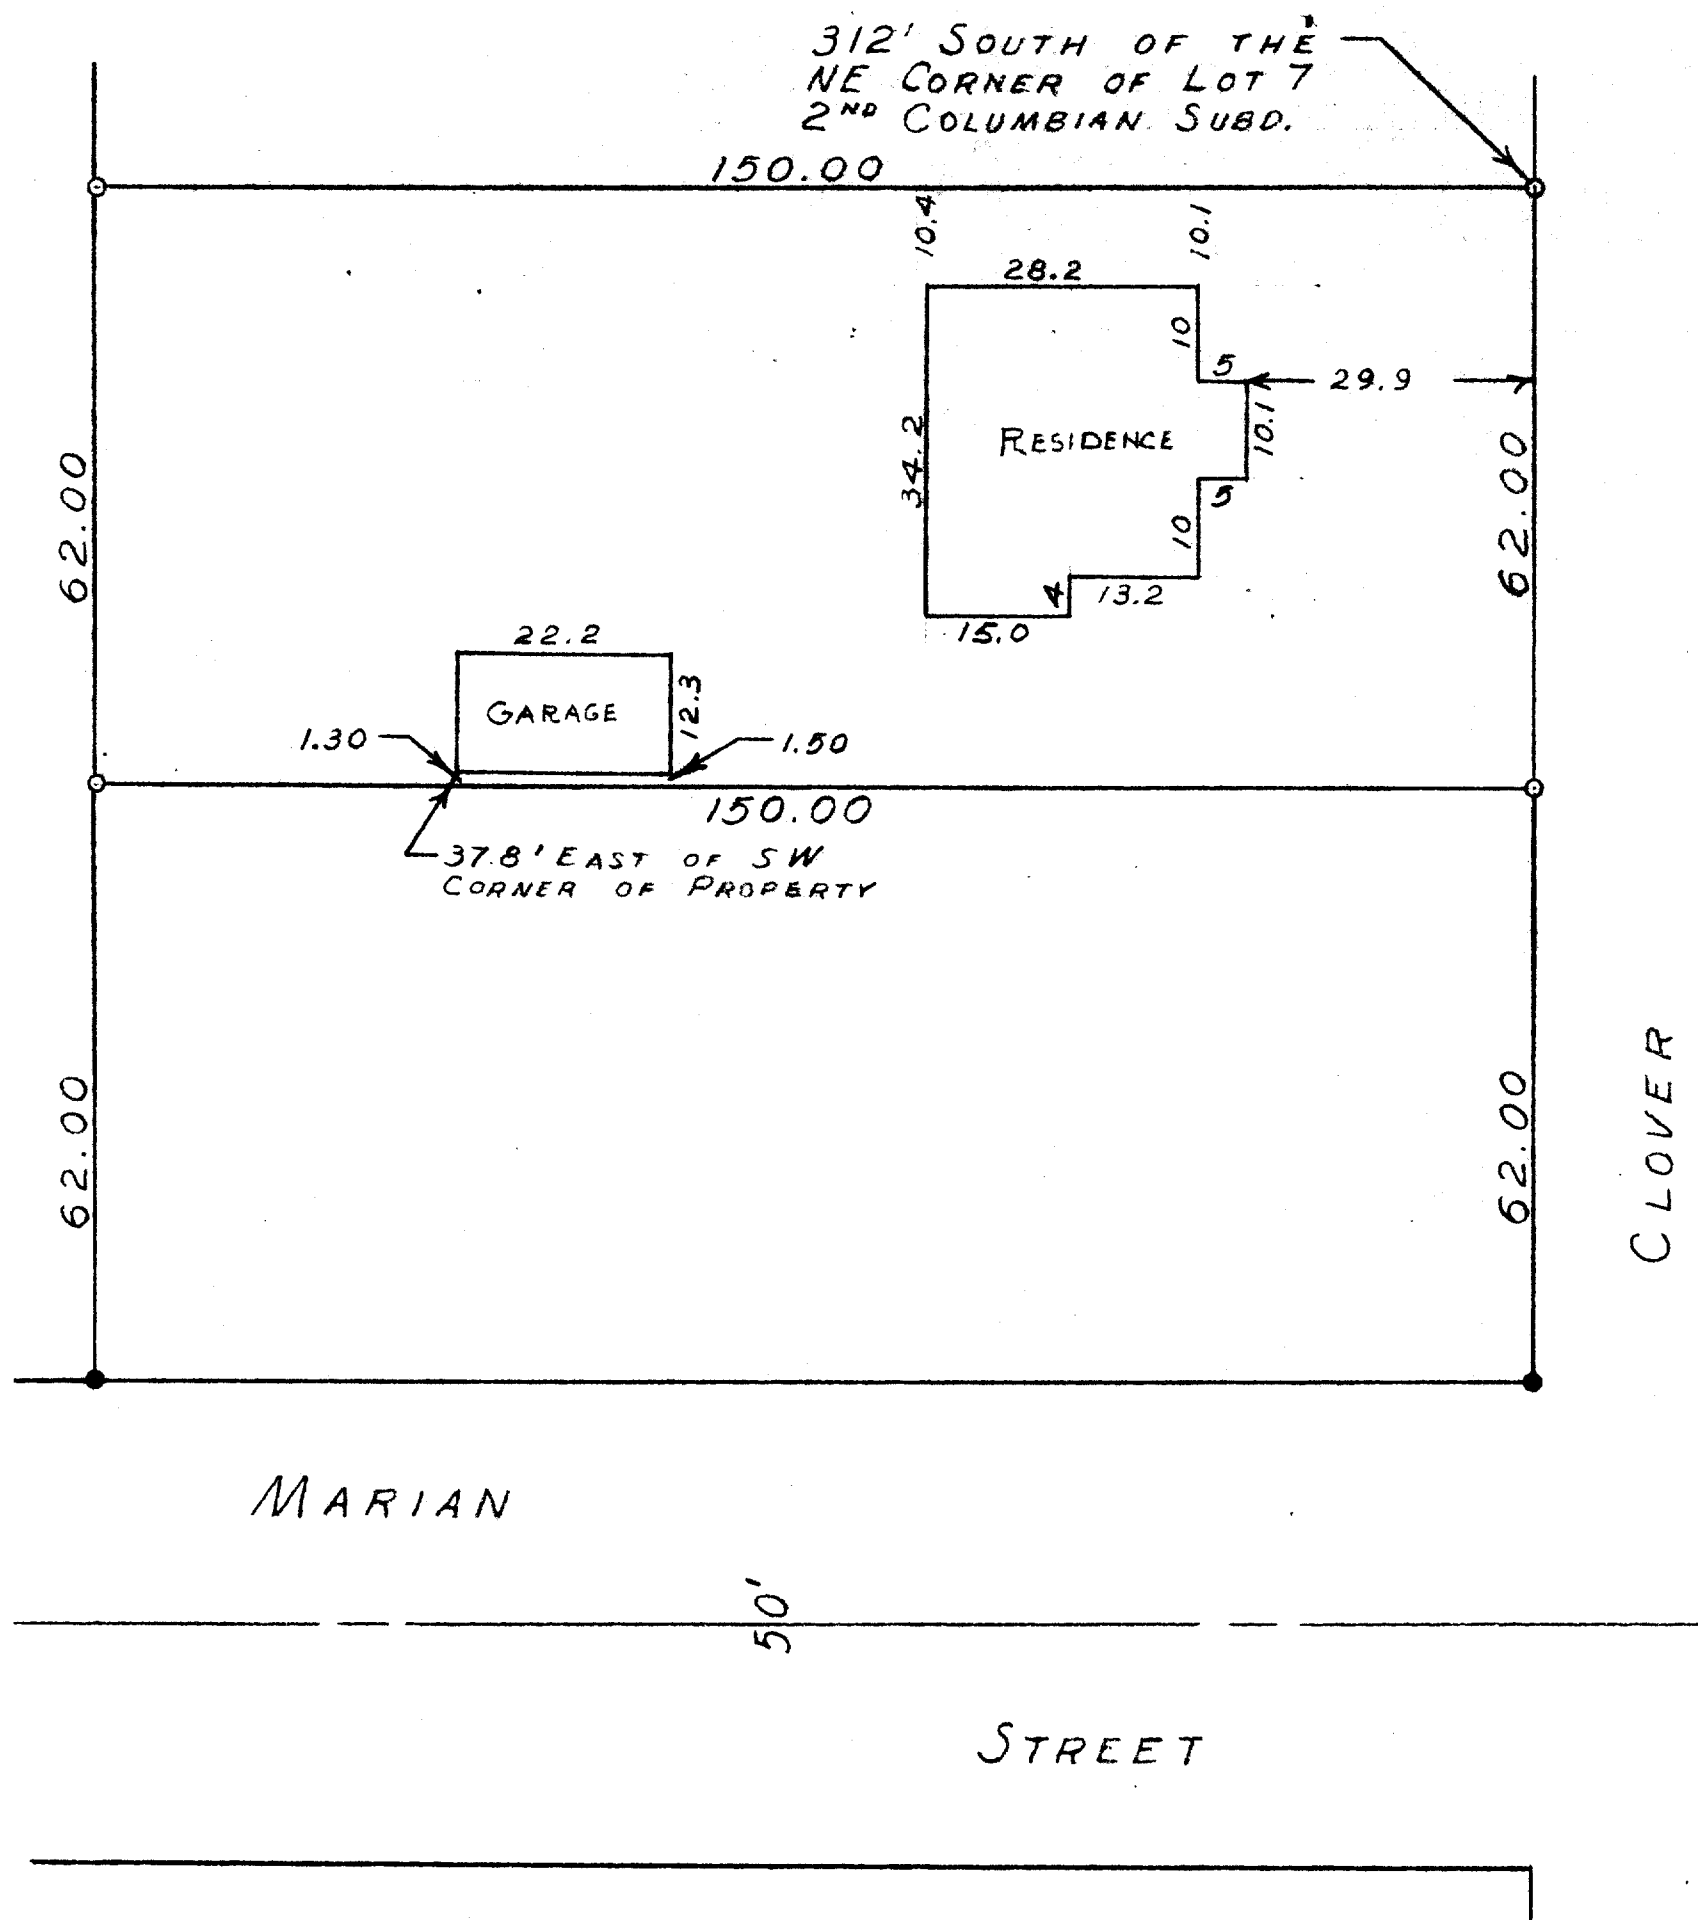

SCALE 1" = 20'
O = IRON PIPE
● = CONC. MON.

STATE OF WISCONSIN)
COUNTY OF WALWORTH) SS

I, GEORGE T. DUNHAM, DO HEREBY CERTIFY THAT I HAVE SURVEYED THE
PROPERTY DESCRIBED AS FOLLOWS:

A PARCEL OF LAND LOCATED IN LOTS 8 AND 9 OF THE 2ND COLUMBIAN
SUBDIVISION, CITY OF LAKE GENEVA, WALWORTH COUNTY, WISCONSIN,
DESCRIBED AS FOLLOWS, TO-WIT: BEGINNING AT A POINT LOCATED 312.00
FEET SOUTH OF THE NORTHEAST CORNER OF LOT 7 OF SAID 2ND
COLUMBIAN SUBDIVISION; THENCE WEST 150.00 FEET; THENCE SOUTH
62.00 FEET; THENCE EAST 150.00 FEET; THENCE NORTH 62.00 FEET
TO THE PLACE OF BEGINNING

AND THAT THE PLAT SHOWN ABOVE IS A CORRECT REPRESENTATION OF THE
PROPERTY LINES AND THE LOCATION OF THE BUILDINGS THEREON.
AUGUST 7, 1956

George T. Dunham
GEORGE T. DUNHAM, SURVEYOR
DELAVER, WISCONSIN

7-37

CL2-5C CL2-5D