

PLAT OF SURVEY



LOCATION: Dodge Street, Lake Geneva, Wisconsin

LEGAL DESCRIPTION:

Lot 6 of **CERTIFIED SURVEY MAP NO. 4789**, being a re-division of Lot 4 of C.S.M. No. 4770, being part of the Northwest 1/4 of the Northeast 1/4 of Section 35, Town 2 North, Range 17 East, in the City of Lake Geneva, Walworth County, Wisconsin.

July 17, 2020

Survey No. 111352-B

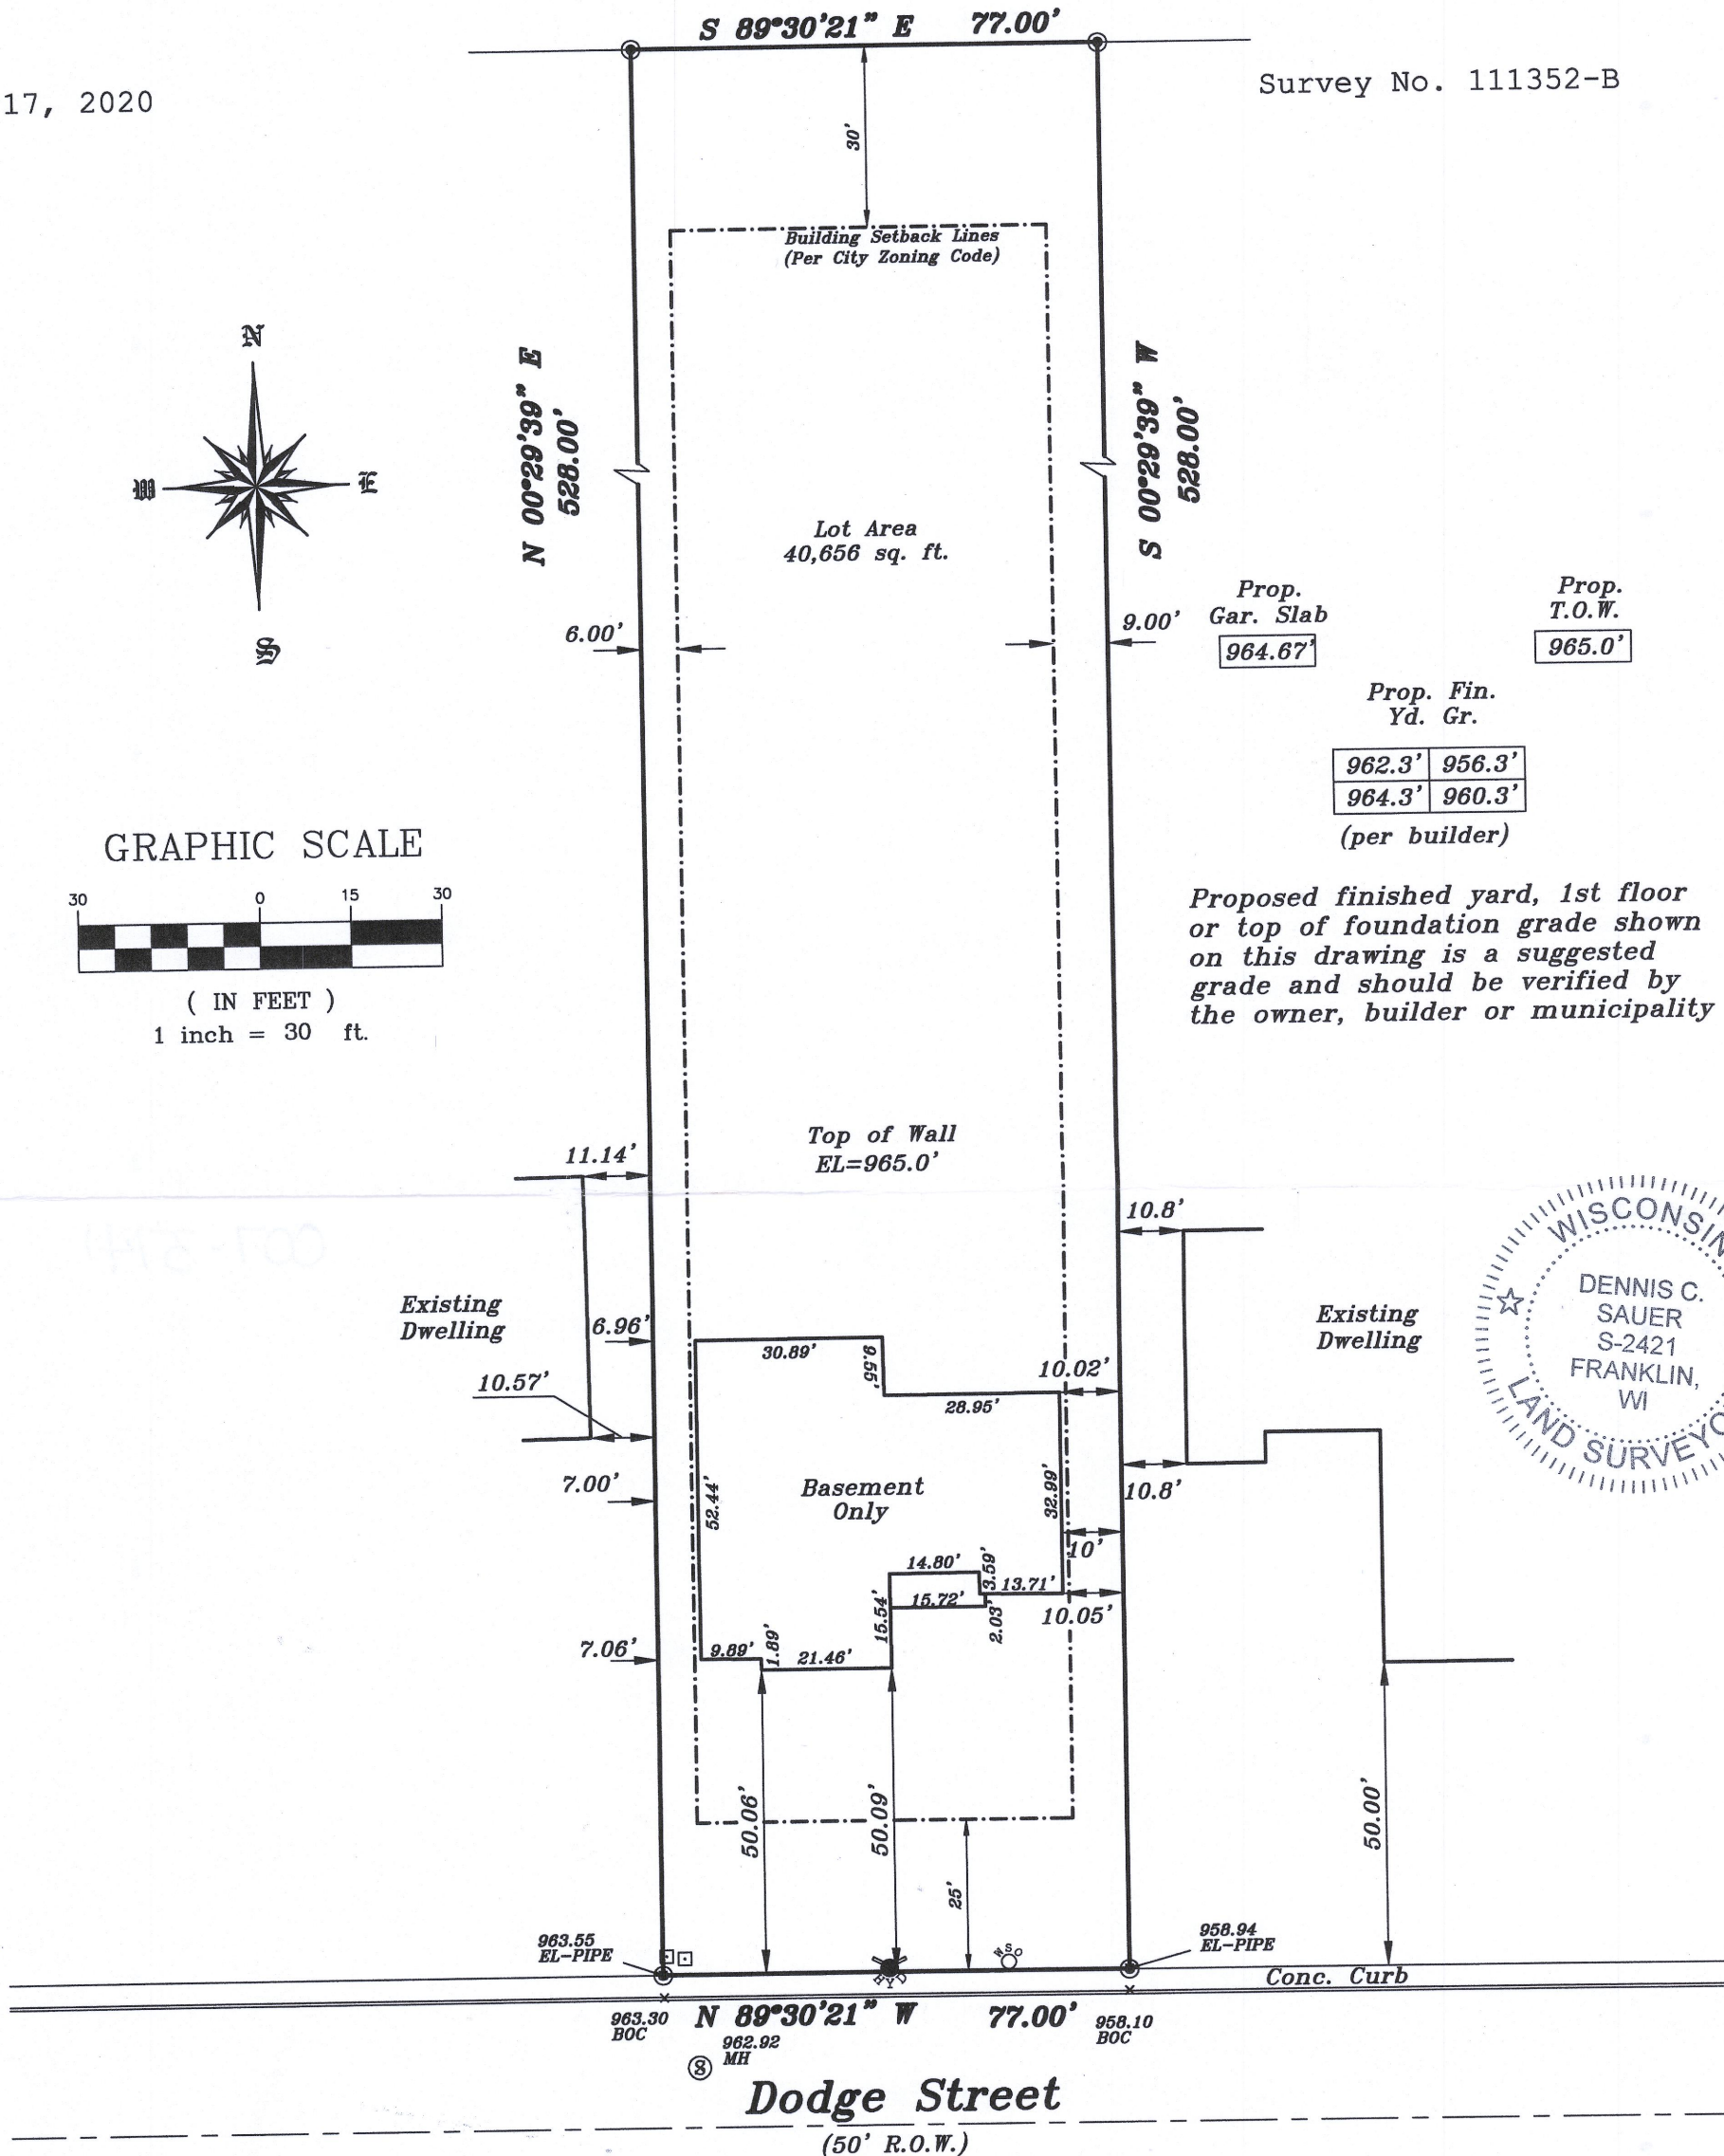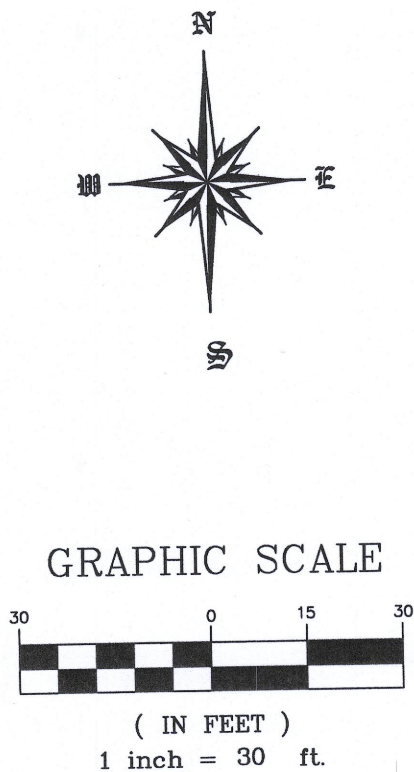

METROPOLITAN SURVEY SERVICE, INC.
PROFESSIONAL LAND SURVEYORS AND CIVIL ENGINEERS
9415 West Forest Home Avenue, Suite 202
Hales Corners, Wisconsin 53130
PH. (414) 529-5380 FAX (414) 529-9787
email address: survey@metropolitansurvey.com
● — Denotes Iron Pipe Found
○ — Denotes Iron Pipe Set



I HEREBY CERTIFY THAT I HAVE SURVEYED THE ABOVE DESCRIBED PROPERTY AND THAT THE ABOVE MAP IS A TRUE REPRESENTATION THEREOF AND SHOWS THE SIZE AND LOCATION OF THE PROPERTY. ITS EXTERIOR BOUNDARIES, THE LOCATION OF ALL VISIBLE STRUCTURES AND DIMENSIONS OF ALL PRINCIPAL BUILDINGS THEREON, BOUNDARY FENCES, APPARENT EASEMENTS AND ROADWAYS AND VISIBLE ENCROACHMENT, IF ANY.

THIS SURVEY IS MADE FOR THE EXCLUSIVE USE OF THE PRESENT OWNERS OF THE PROPERTY, AND ALSO THOSE WHO PURCHASE, MORTGAGE, OR GUARANTEE THE TITLE THERETO WITHIN ONE (1) YEAR FROM THE DATE HEREOF.

SIGNED

Dennis C. Sauer
Professional Land Surveyor S-2421

007-3741

ZA4789-6