


NORTH 30' STREET

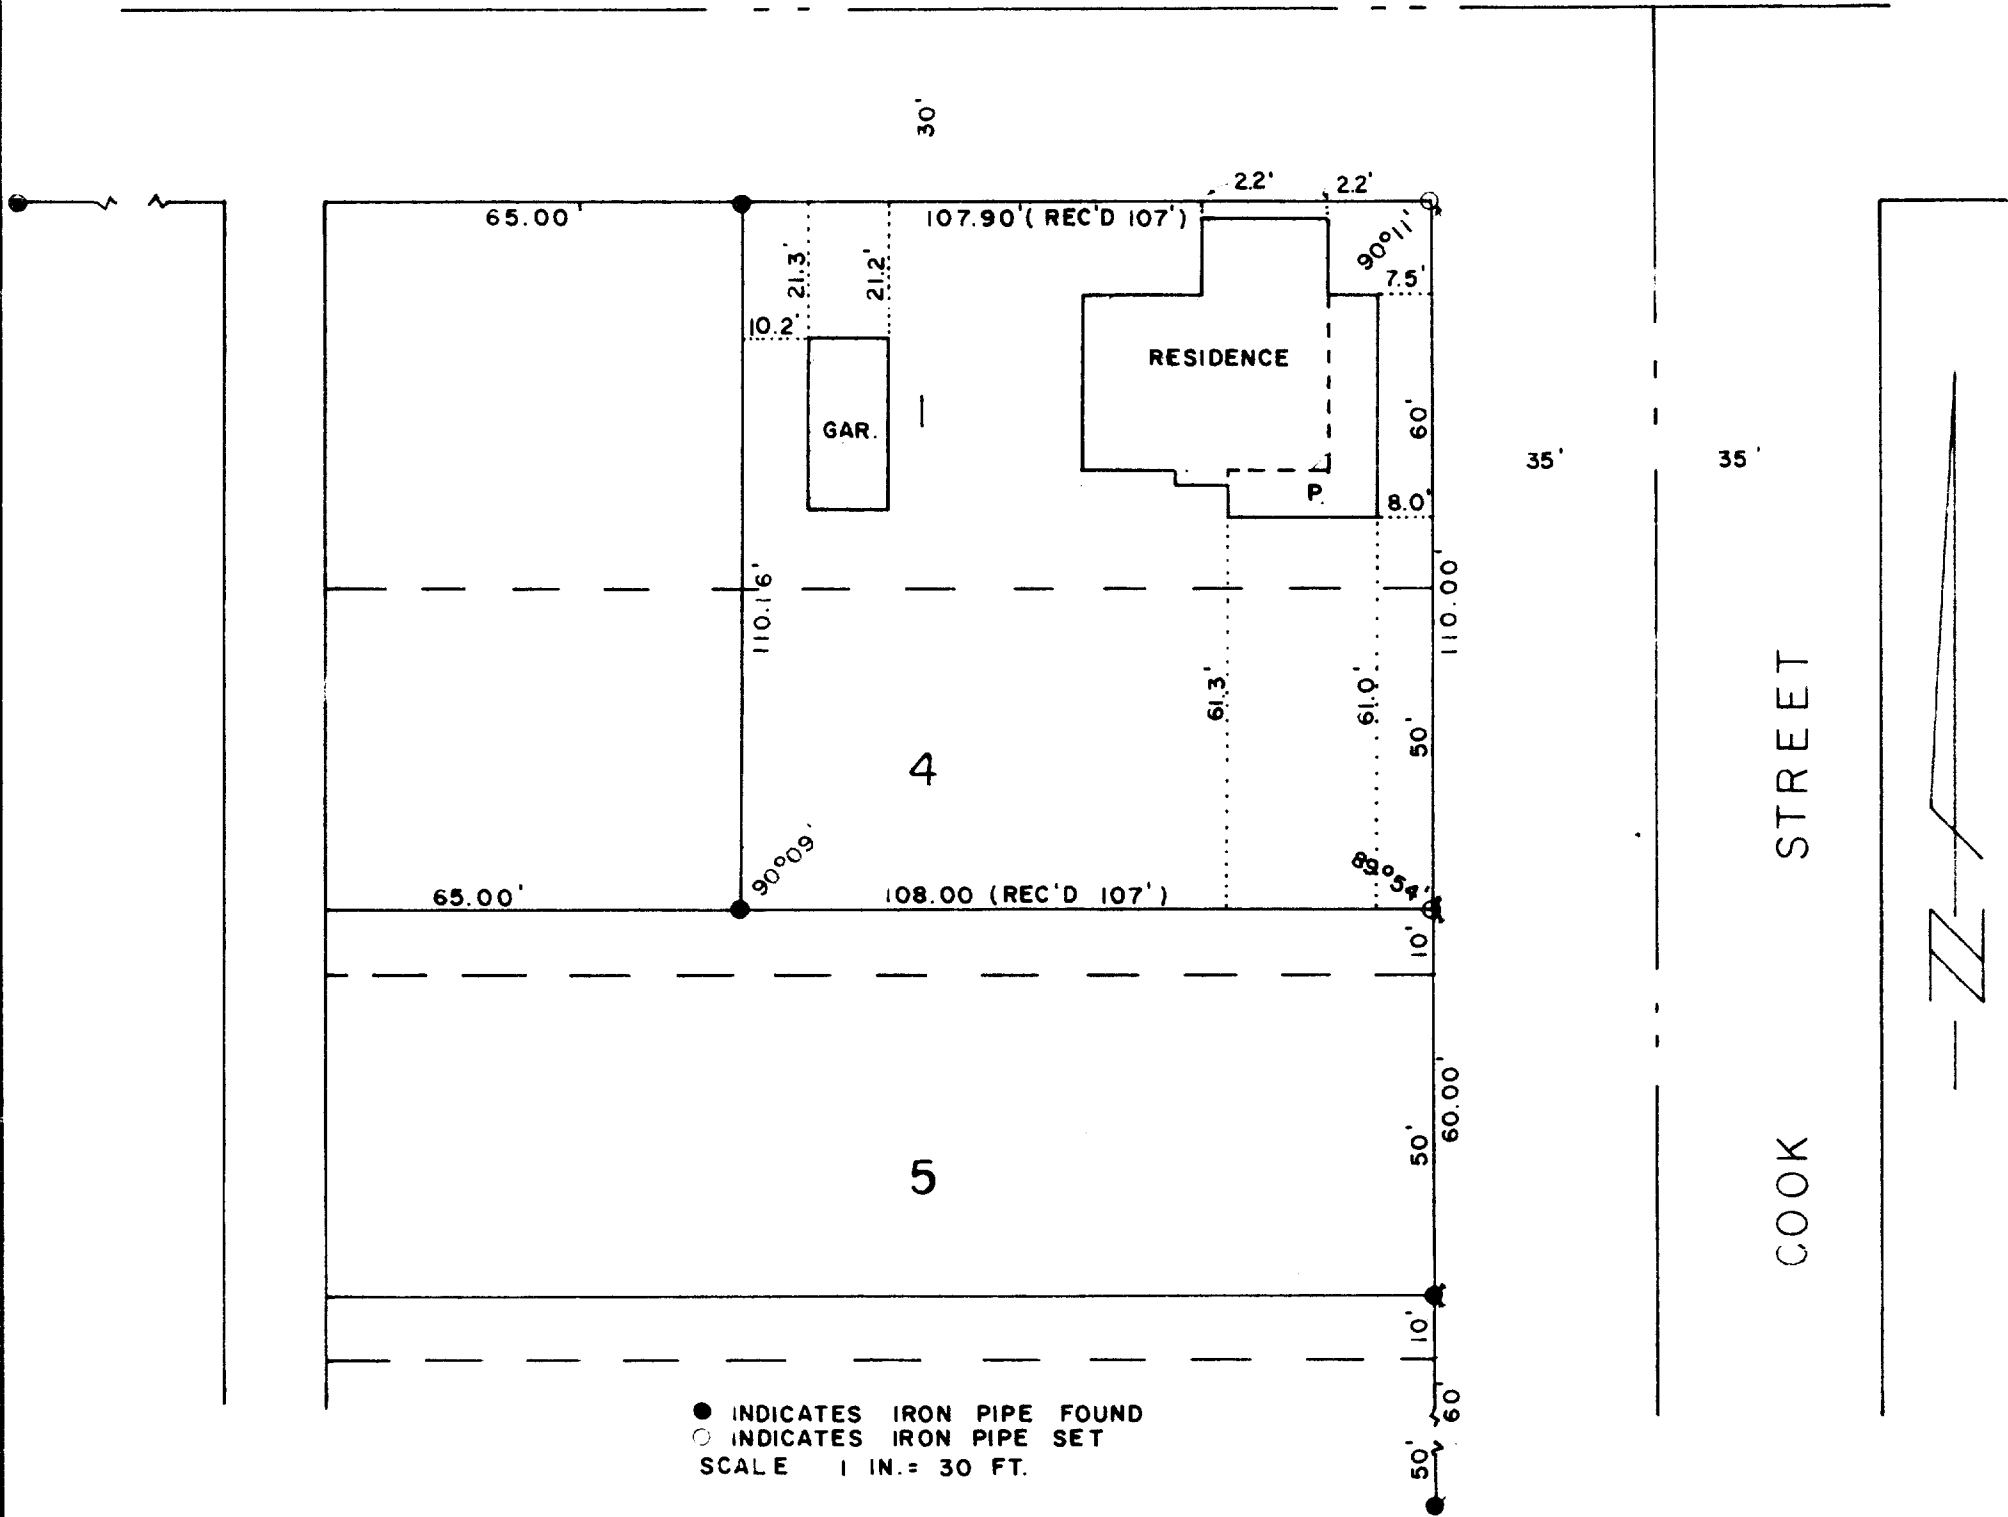

PLAT OF SURVEY OF


The East 107 feet of Lot 1, Block 4, and the East 107 feet of the North 50 feet of lot 4, Block 4 Of Goodsell's Subdivision of Blocks 3 and 4 of the Original Plat of the City of Lake Geneva, Walworth County, Wisconsin.

CERTIFICATE

I, James F. Biagi, surveyor, do hereby certify that I have surveyed the lands hereon described, and that the improvements are as hereon shown.

December 6, 1971

James F. Biagi RLS 272

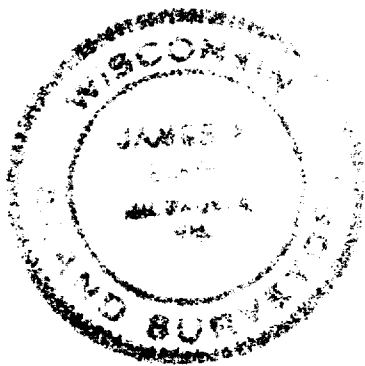

Part of lots 1 and 4 of Block 4 of Goodsell's Subdivision of Blocks 3 and 4, Lake Geneva		
SCALE	DRAWN BY	
1"=30'	ALE	
REVISED		
DATE	APPROVED BY	DRAWING NUMBER
12/6/71	JFB	218-71