


Plat of Survey

of

Lot 10 of Geneva Woods,

a subdivision located in the Northwest 1/4 of the Northeast 1/4 of Section 1, Town 1 North, Range 17 East, City of Lake Geneva, Walworth County, Wisconsin.

Surveyed for: **RE/MAX Plaza**
101 Broad Street
Lake Geneva, Wisconsin. 53147

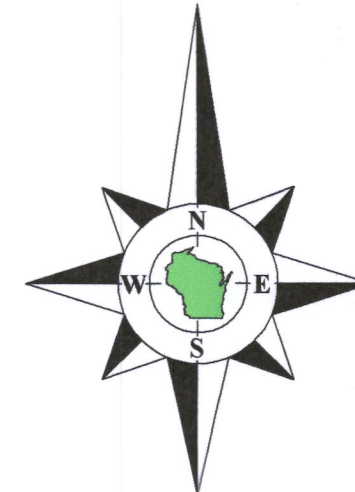

Bearings referenced to the North line of Oakwood Lane,
recorded as S89°42'09"E on the plat of Geneva Woods.

Tax Parcel
ZYUP 00100D

Tax Parcel
ZYUP 00100B

Expansion Area B
Summerhaven Condominium

Scale in Feet
1" = 20'




Survey Date: September 3, 2020.
Revisions:

45 South Wisconsin Street | P.O. Box 322
Elkhorn, Wisconsin 53121
Telephone: (262) 723-3434
Facsimile: (262) 723-8044
Email: doug@olsonsurveying.com
Website: www.olsonsurveying.com

OLSON
LAND SURVEYING, LLC
Rural | Residential | Commercial


Legend of Symbols & Abbreviations
North
N
South
S
East
E
West
W
In Bearings
Degrees
Minutes
Seconds
In Distances
Feet
Inches
Found Iron Pipe, 2" dia.
Found Iron Pipe, 1" dia.
Found Iron Rod, 3/4" dia.
Set Iron Pipe, 1" dia.
Recorded Information
Concrete Hydrant
Manhole
Asphalt Surface
Concrete Surface
Brick Pavers

Sheet 1 of 1 Sheets
Drawing Name
Job Reference Number
2020.117
2020.117

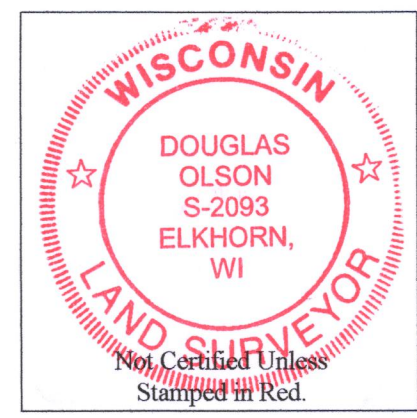

Notes:

- 1) This Plat of Survey is not certified unless signed and sealed in red ink.
- 2) This survey is subject to Wisconsin lien laws. This Plat of Survey is the notice of intent to file lien. Lien waiver required.
- 3) The Survey Date shown on this Plat of Survey is the completion date of the field work.

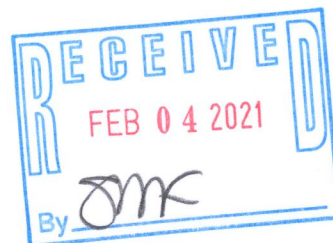


Copyright ©2020 by Olson Land Surveying, LLC.

All rights reserved. No part of this survey plat may be reproduced or transmitted in any form by any means - graphic, electronic, or mechanical, including photocopying, tracing, or information storage and retrieval systems - without permission in writing from Douglas G. Olson, Olson Land Surveying, LLC.

I hereby certify that I have surveyed the above described property in compliance with Chapter A-E 7 of the Wisconsin Administrative Code and that the map hereon is correct to the best of my professional knowledge and belief and shows the size and location of the property, its exterior boundaries, the location and dimensions of all visible structures thereon, boundary fences, apparent easements and roadways and visible encroachments, if any.

This survey is made for the exclusive use of the present owners of the property, and also those who purchase, mortgage or guarantee title thereto, within one year from the date hereof.

Douglas G. Olson
Wisconsin Professional Land Surveyor - 2093

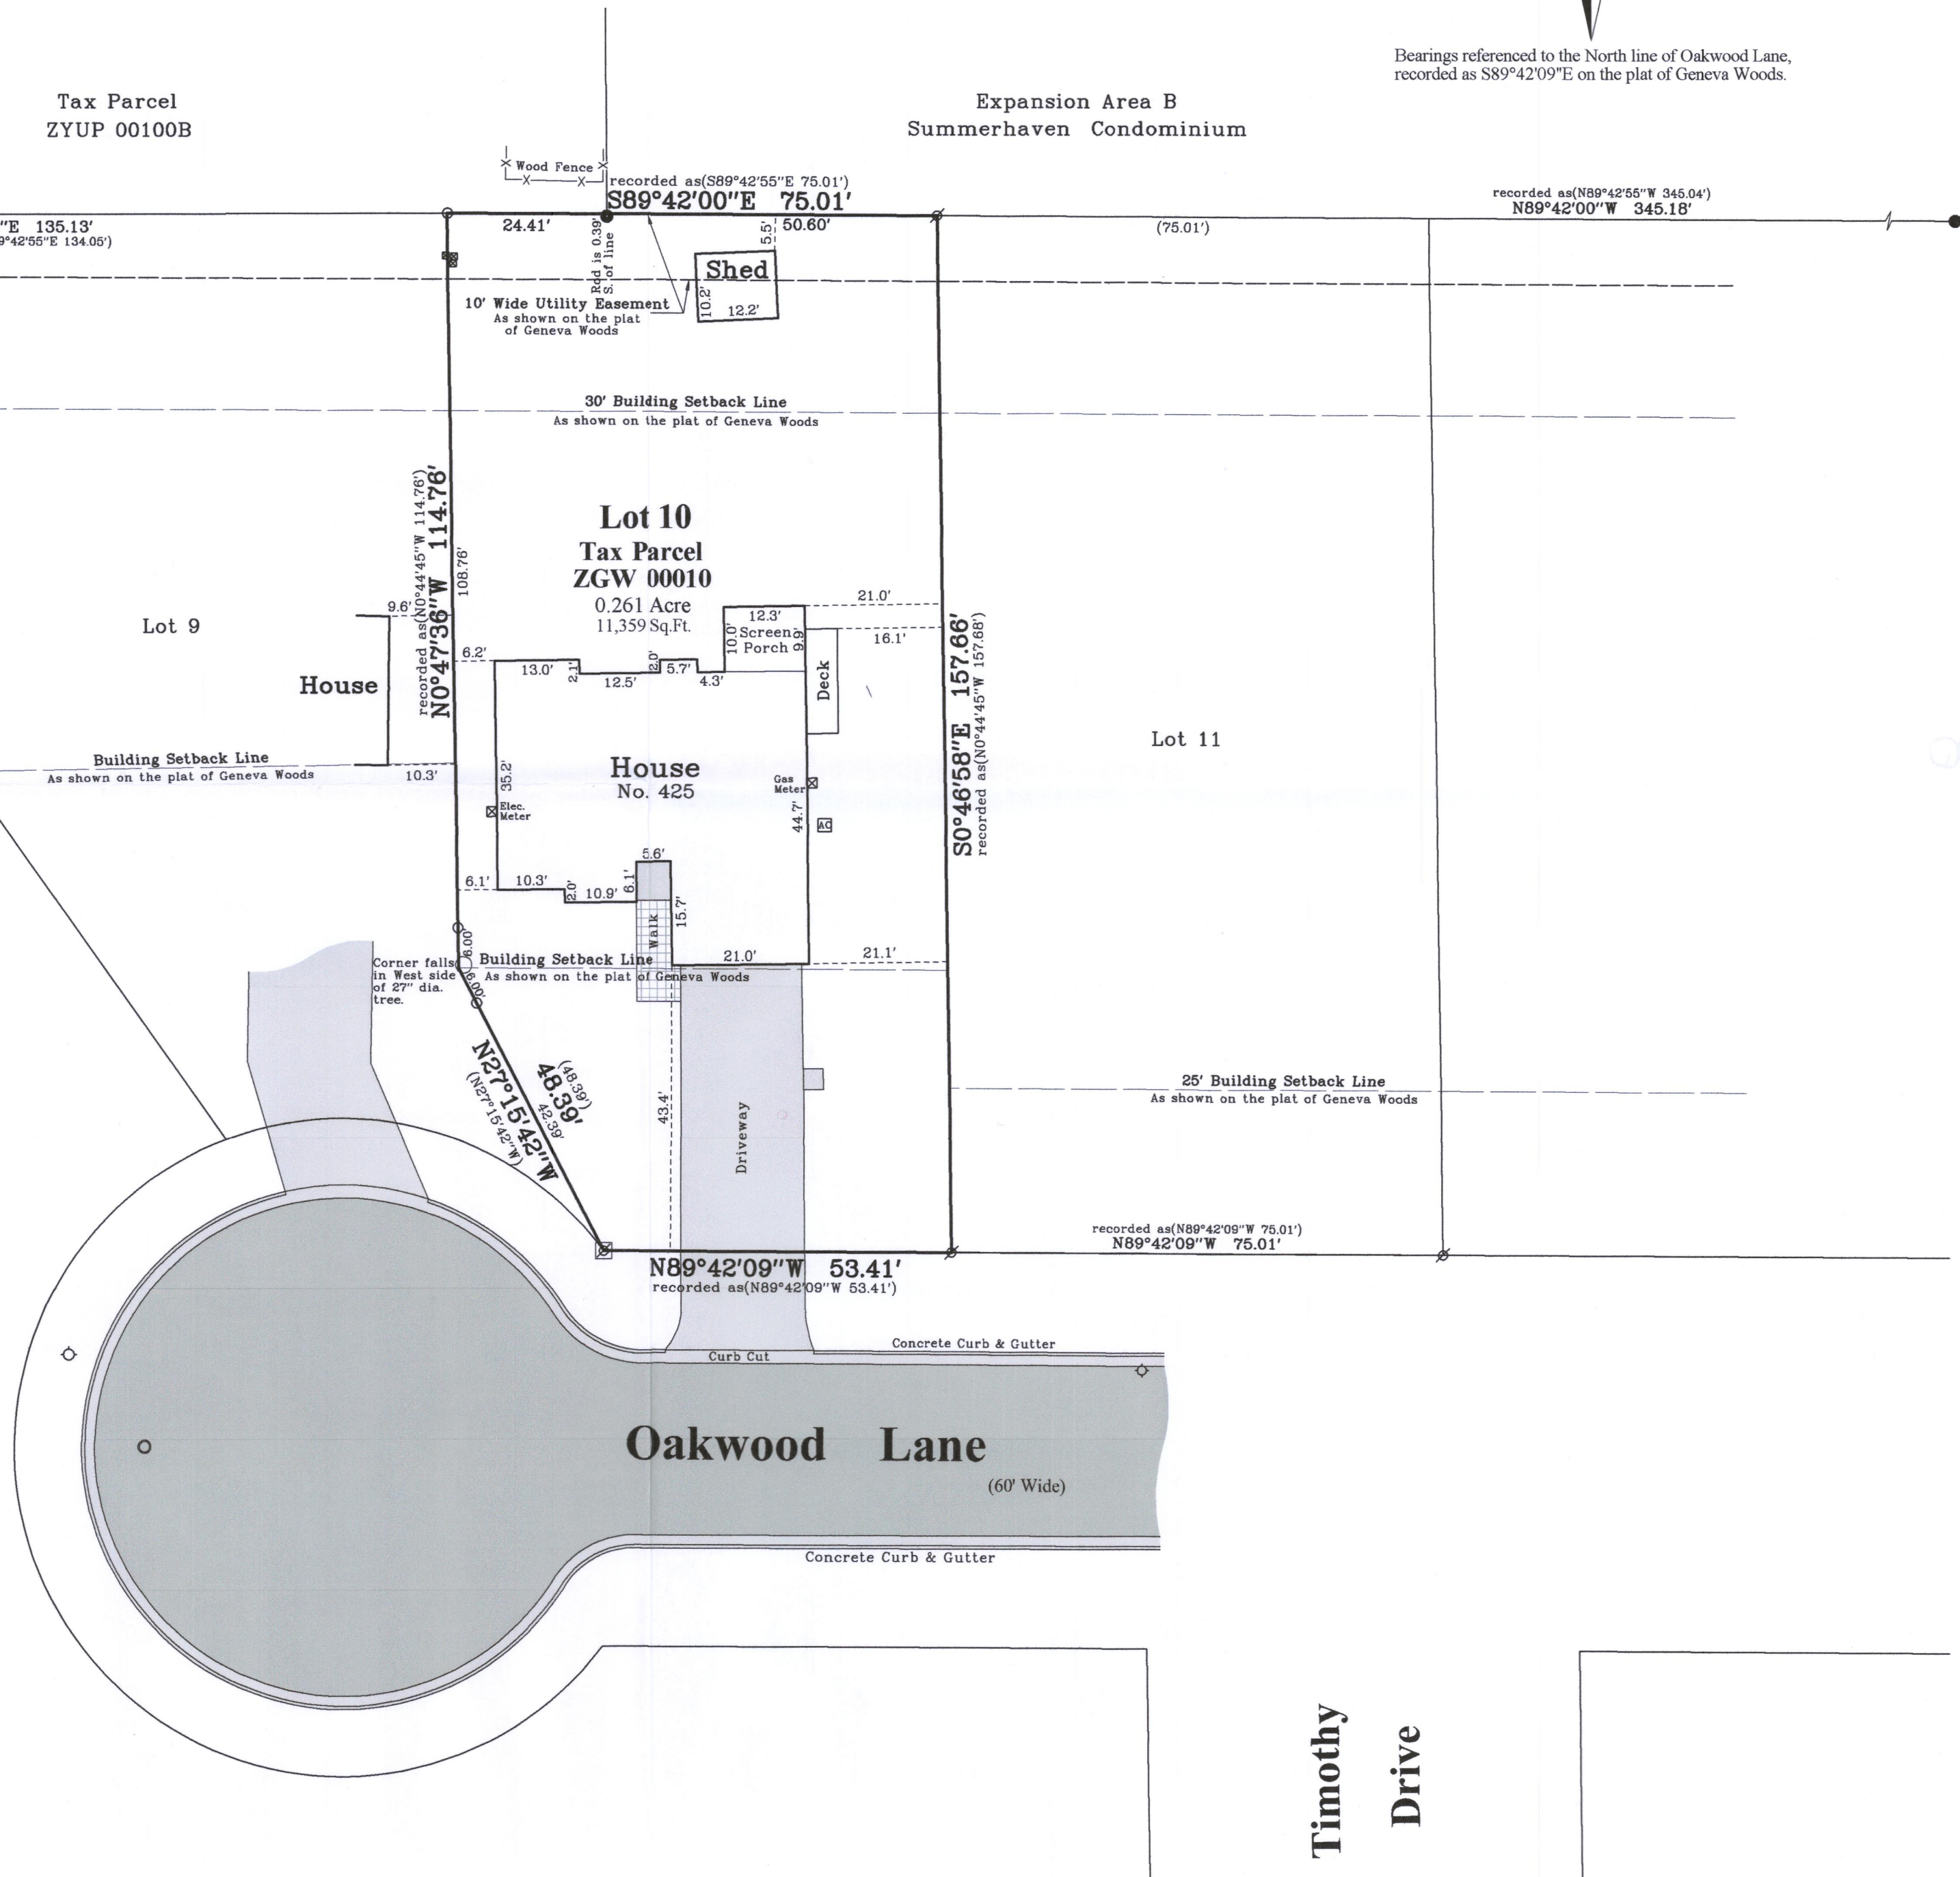

ZGW-10

007-3806