


A PARCEL OF LAND LOCATED IN THE NORTHWEST 1/4 OF THE
NORTHWEST 1/4 OF SECTION 35 IN TOWNSHIP 2 NORTH, RANGE 17
EAST, IN THE CITY OF LAKE GENEVA, WALWORTH COUNTY, WISCONSIN.



	FOUND 1" IRON PIPE
	SET MAG NAIL
	EXISTING BUILDING
	EXISTING DRIVEWAY
	EXISTING CONCRETE
	UTILITY POLE
	UTILITY PEDESTAL
	WATER SHUTOFF

LOT 16 IN THE DAVID O. MARSH SUBDIVISION OF BLOCK 7 OF THE ORIGINAL PLAT OF THE CITY OF LAKE GENEVA, RECORDED AS DOCUMENT NO. C003S10A AT THE WALWORTH COUNTY REGISTER OF DEEDS.

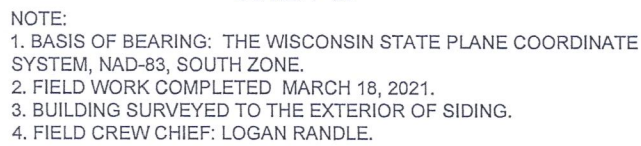

DATE: 03/24/2021 JOB No. 21338
SHEET 1 OF 1 JBM

007-3886