


Plat of Survey

of


Lot 4 of Barbara Jean Estates,

a subdivision located in the Northwest 1/4 of the Northeast 1/4 of Section 1, Town 1 North, Range 17 East, City of Lake Geneva, Walworth County, Wisconsin.

Surveyed for: Richard & Jen Glauser
601 Sue Ann Drive
Lake Geneva, Wisconsin. 53147

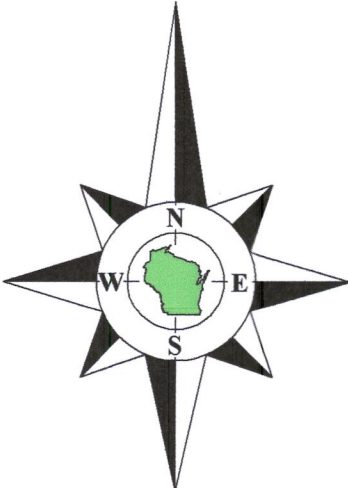


Bearings referenced to the North line of Sue Ann Drive,
recorded as N89°29'27"E on the plat of Barbara Jean Estates.

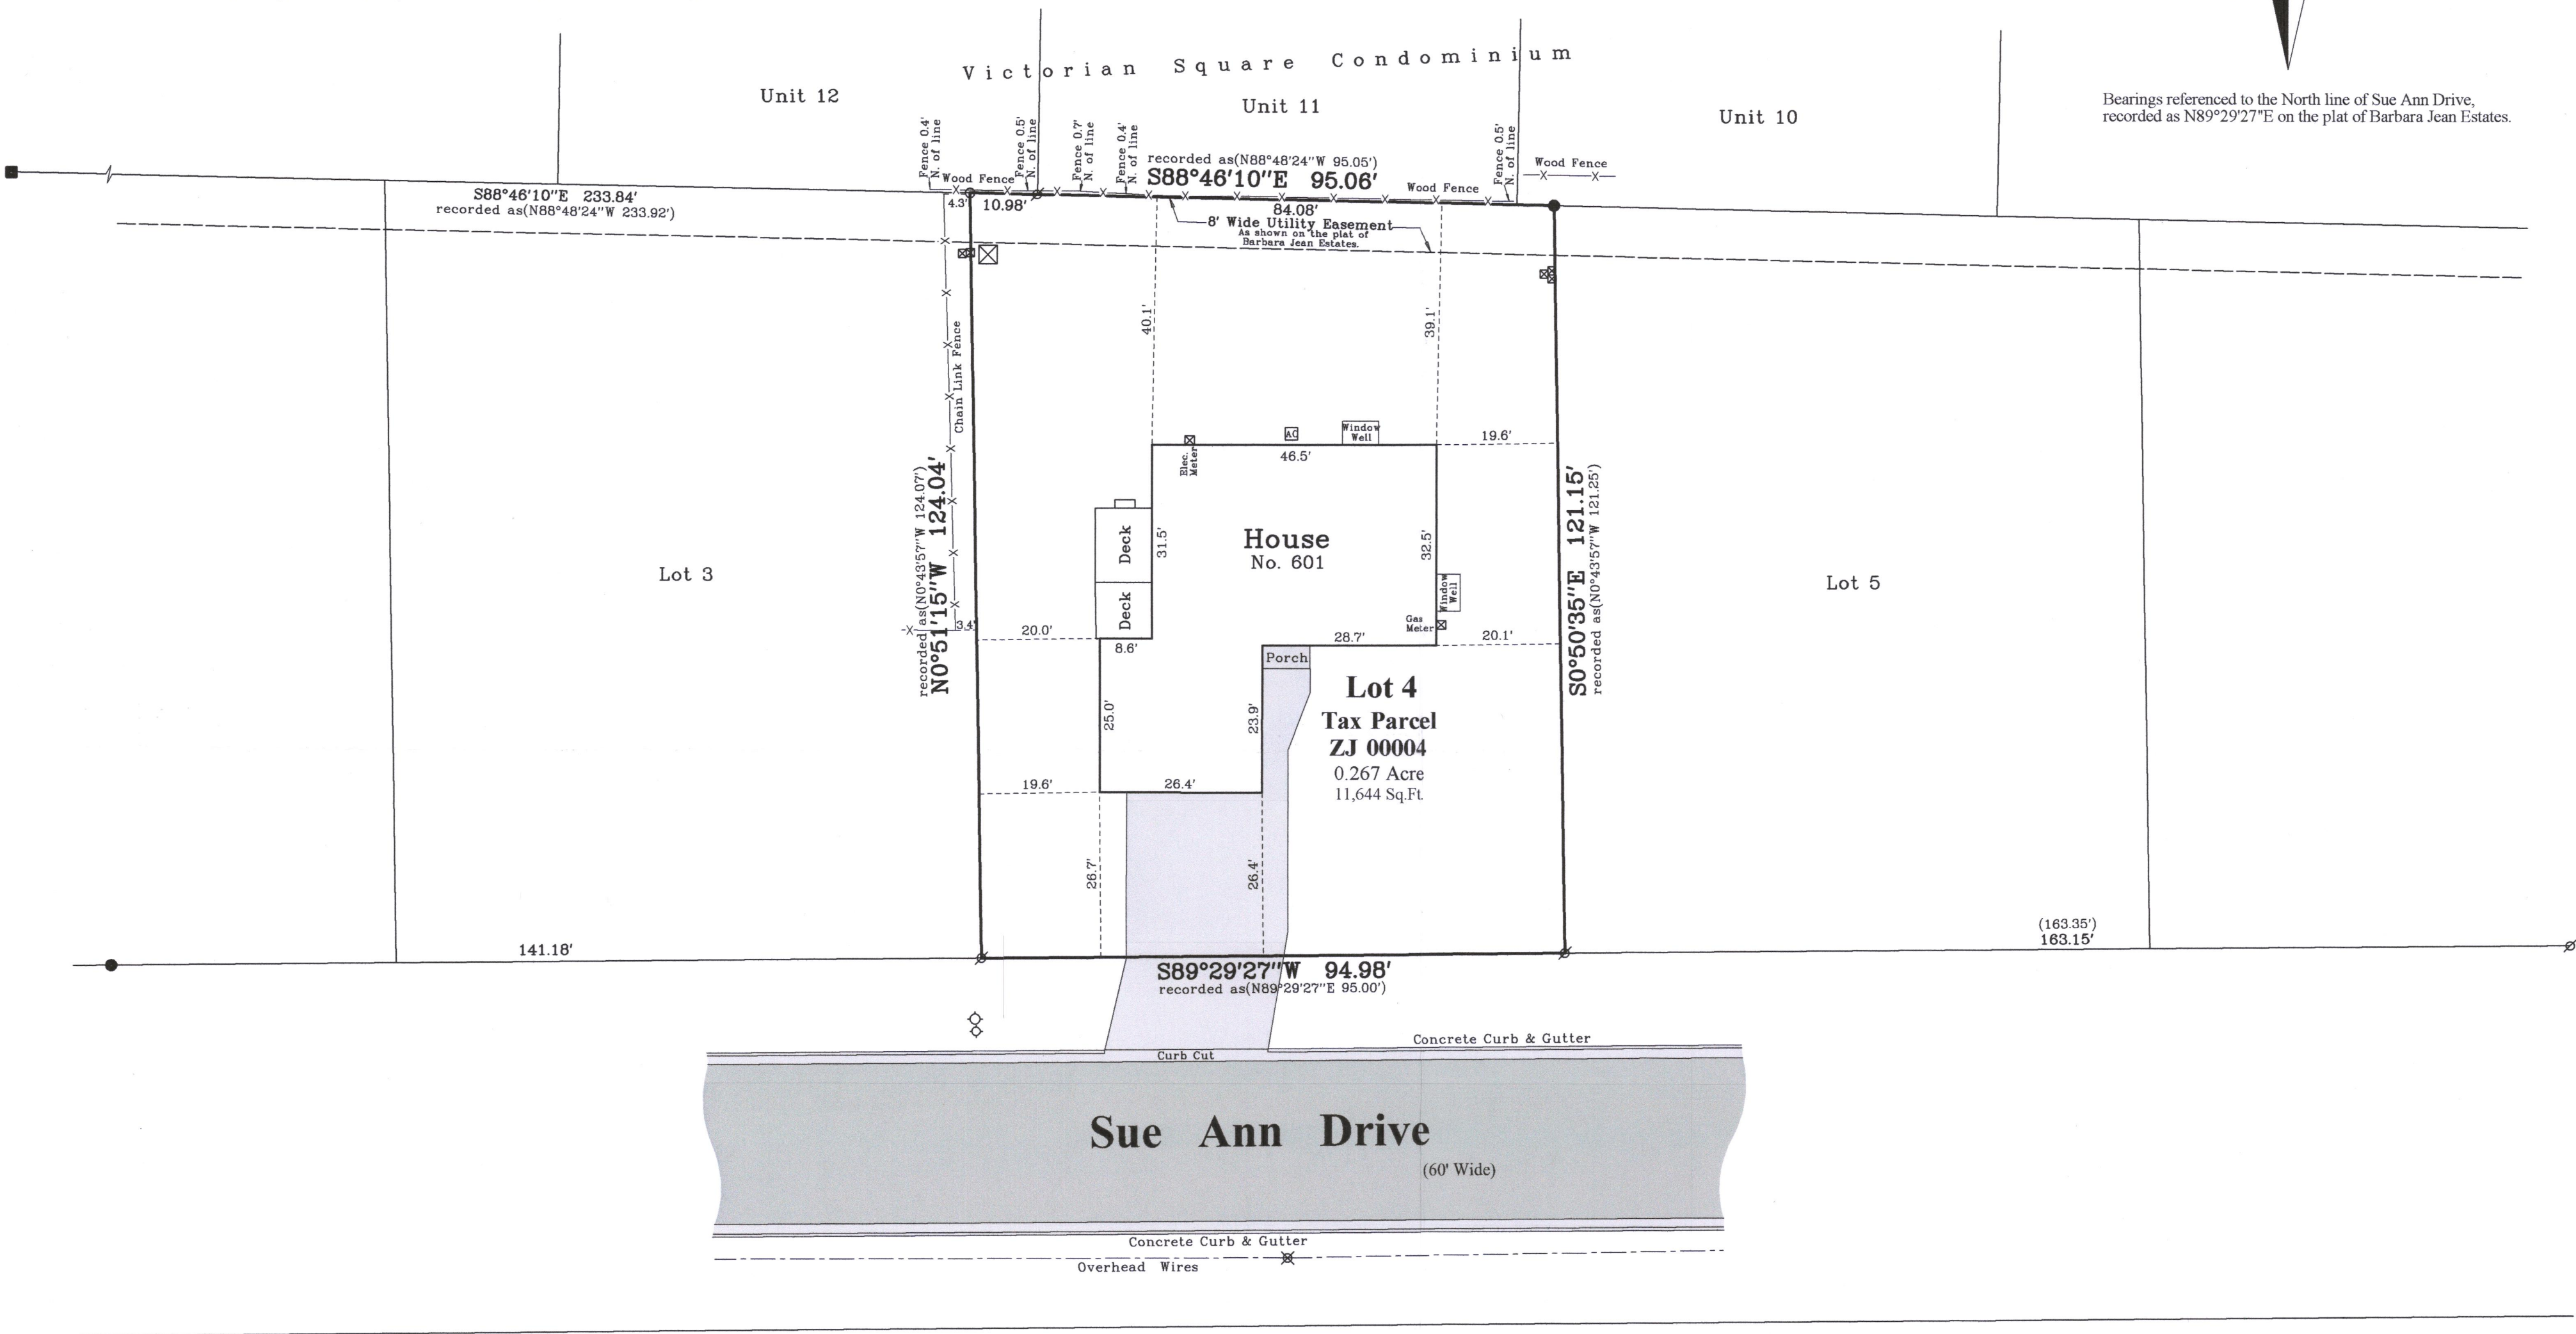

Survey Date: April 15, 2021.
Revisions:




45 South Wisconsin Street | P.O. Box 322
Elkhorn, Wisconsin. 53121
Telephone: (262) 723-3434
Facsimile: (262) 723-8044
Email: doug@olsonsurveying.com
Website: www.olsonsurveying.com

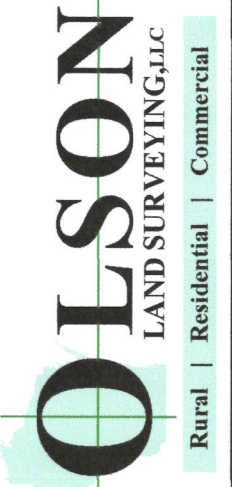


Legend of Symbols & Abbreviations

Found Concrete Monument	North
Found Iron Pipe	South
Set Iron Pipe, 1" dia.	East
Recorded Information	West
Utility Pole or Pedestal	Bearings
Water Valve	Degrees
Fire Hydrant	Minutes
Asphalt Surface	Seconds
Concrete Surface	Inches

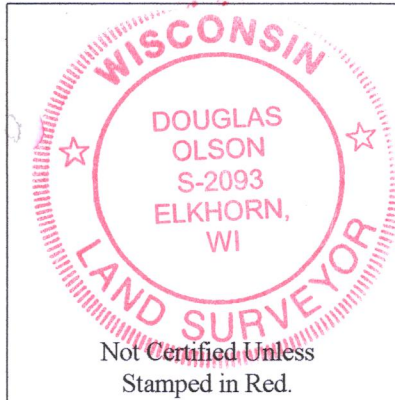

- Notes:
- 1) This Plat of Survey is not certified unless signed and sealed in red ink.
 - 2) This survey is subject to Wisconsin lien laws. This Plat of Survey is the notice of intent to file lien. Lien waiver required.
 - 3) The Survey Date shown on this Plat of Survey is the completion date of the field work.

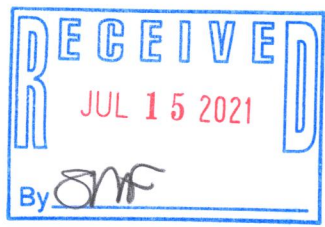

Copyright ©2021 by Olson Land Surveying, LLC.

All rights reserved. No part of this survey plat may be reproduced or transmitted in any form by any means - graphic, electronic, or mechanical, including photocopying, tracing, or information storage and retrieval systems - without permission in writing from Douglas G. Olson, Olson Land Surveying, LLC.

I hereby certify that I have surveyed the above described property in compliance with Chapter A-E 7 of the Wisconsin Administrative Code and that the map hereon is correct to the best of my professional knowledge and belief and shows the size and location of the property, its exterior boundaries, the location and dimensions of all visible structures thereon, boundary fences, apparent easements and roadways and visible encroachments, if any.

This survey is made for the exclusive use of the present owners of the property, and also those who purchase, mortgage or guarantee title thereto, within one year from the date hereof.

Douglas G. Olson
Wisconsin Professional Land Surveyor - 2093