


POINT DESCRIBED AS BEING
LOCATED 243' EAST OF AND
133' NORTH OF THE SW CORNER
OF SUBLLOT 15 OF LARGE LOT
4 OF THE ORIGINAL PLAT
OF THE VILLAGE (NOW CITY) OF
LAKE GENEVA, WALWORTH
COUNTY, WISCONSIN

ROADWAY

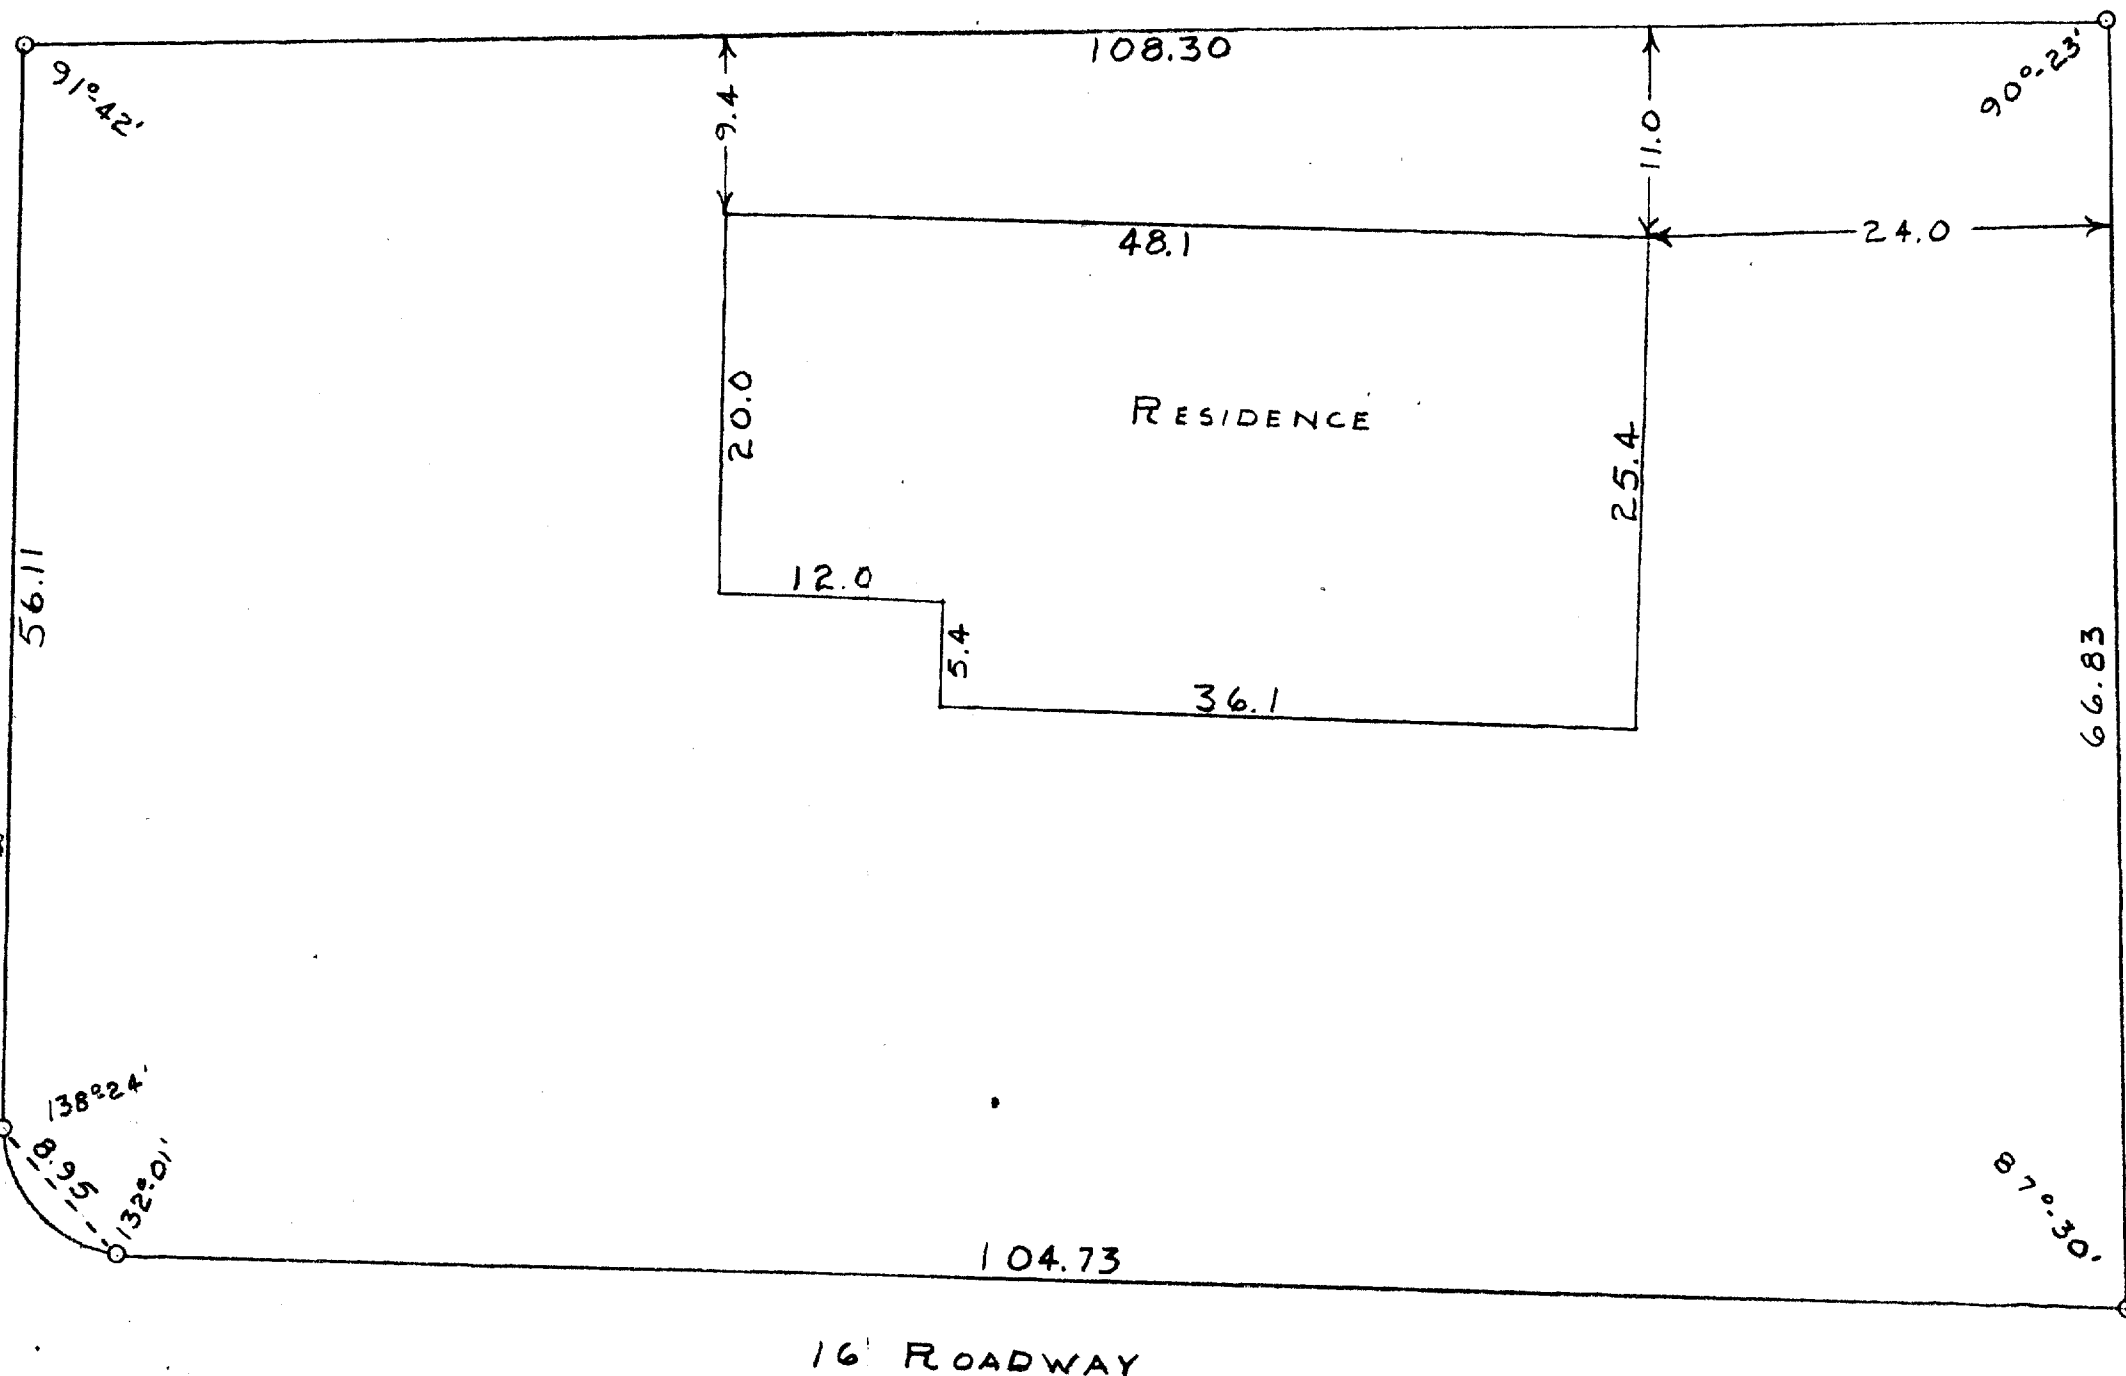

SCALE 1"=10'
0=IRON ROD OR
IRON PIPE

STATE OF WISCONSIN)⁵⁵
COUNTY OF WALWORTH)

I, GEORGE T. DUNHAM, DO HEREBY CERTIFY THAT I HAVE SURVEYED THE
PROPERTY DESCRIBED AS FOLLOWS:

A PARCEL OF LAND LOCATED IN SUBLLOT 15 OF LARGE LOT 4 OF THE ORIGINAL
PLAT OF THE VILLAGE (NOW CITY) OF LAKE GENEVA, WALWORTH COUNTY, WISCONSIN,
DESCRIBED AS FOLLOWS, TO-WIT: BEGINNING AT A POINT LOCATED 243 FEET EAST AND
133 FEET NORTH OF THE SOUTHWEST CORNER OF SAID SUBLLOT 15; THENCE NORTH
56.11 FEET TO A STAKE; THENCE EAST 108.30 FEET TO A STAKE; THENCE SOUTH 66.83 FEET
TO A STAKE; THENCE WESTERLY ALONG THE NORTH LINE OF A 16 FOOT ROADWAY 104.73
FEET TO A STAKE; THENCE WESTERLY, NORTHWESTERLY, AND NORTHERLY ALONG THE
ARC OF A CURVE WITH A 70 FOOT RADIUS TO A POINT LOCATED 8.95 FEET NORTHWESTERLY
OF THE LAST MENTIONED POINT AND THE PLACE OF BEGINNING.

AND THAT THE PLAT SHOWN ABOVE IS A CORRECT REPRESENTATION OF THE PROPERTY LINES
AND OF THE IMPROVEMENTS LOCATED THEREON
JAN. 31, 1957

George T. Dunham
GEORGE T. DUNHAM, SURVEYOR
DELAVER, WISCONSIN