


LAKELAND SURVEYORS LLC
236 STH 50
SUITE B
DELAVAN, WI 53115
262-475-9567
lakelandsurveyors@outlook.com

PLAT OF SURVEY
- OF -



PREPARED FOR:
MILANKO DJURDJULOV

Lot number Twelve (12) in Block Three (3) of Wheeler's Addition to the Village of Geneva (now City of Lake Geneva) Walworth County, Wisconsin, According to a plat thereof of record in the Office of the Register of Deeds Office in and for said Walworth County.

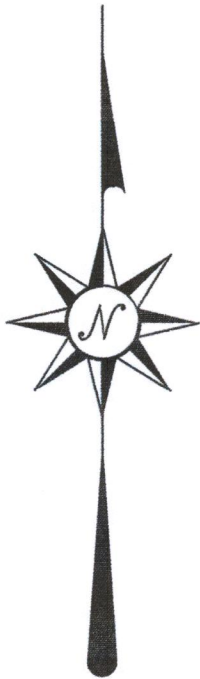

BASIS OF BEARING: THE US STATE PLANE COORDINATE SYSTEM
WISCONSIN SOUTH ZONE NAD (83)

- (XXX) = RECORDED AS
- = FOUND IRON PIPE
 - = SET IRON PIPE
 - = FOUND IRON REBAR
 - ▲ = SET PK NAIL
 - ⋈ = UTILITY POLE
 - DP — = OVERHEAD UTILITY LINES
 - ▣ = UTILITY PEDESTAL
- SCALE 1" = 20'
- JOB NO. 2021-006
- TAX ID # ZWH 00014

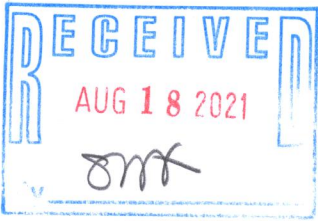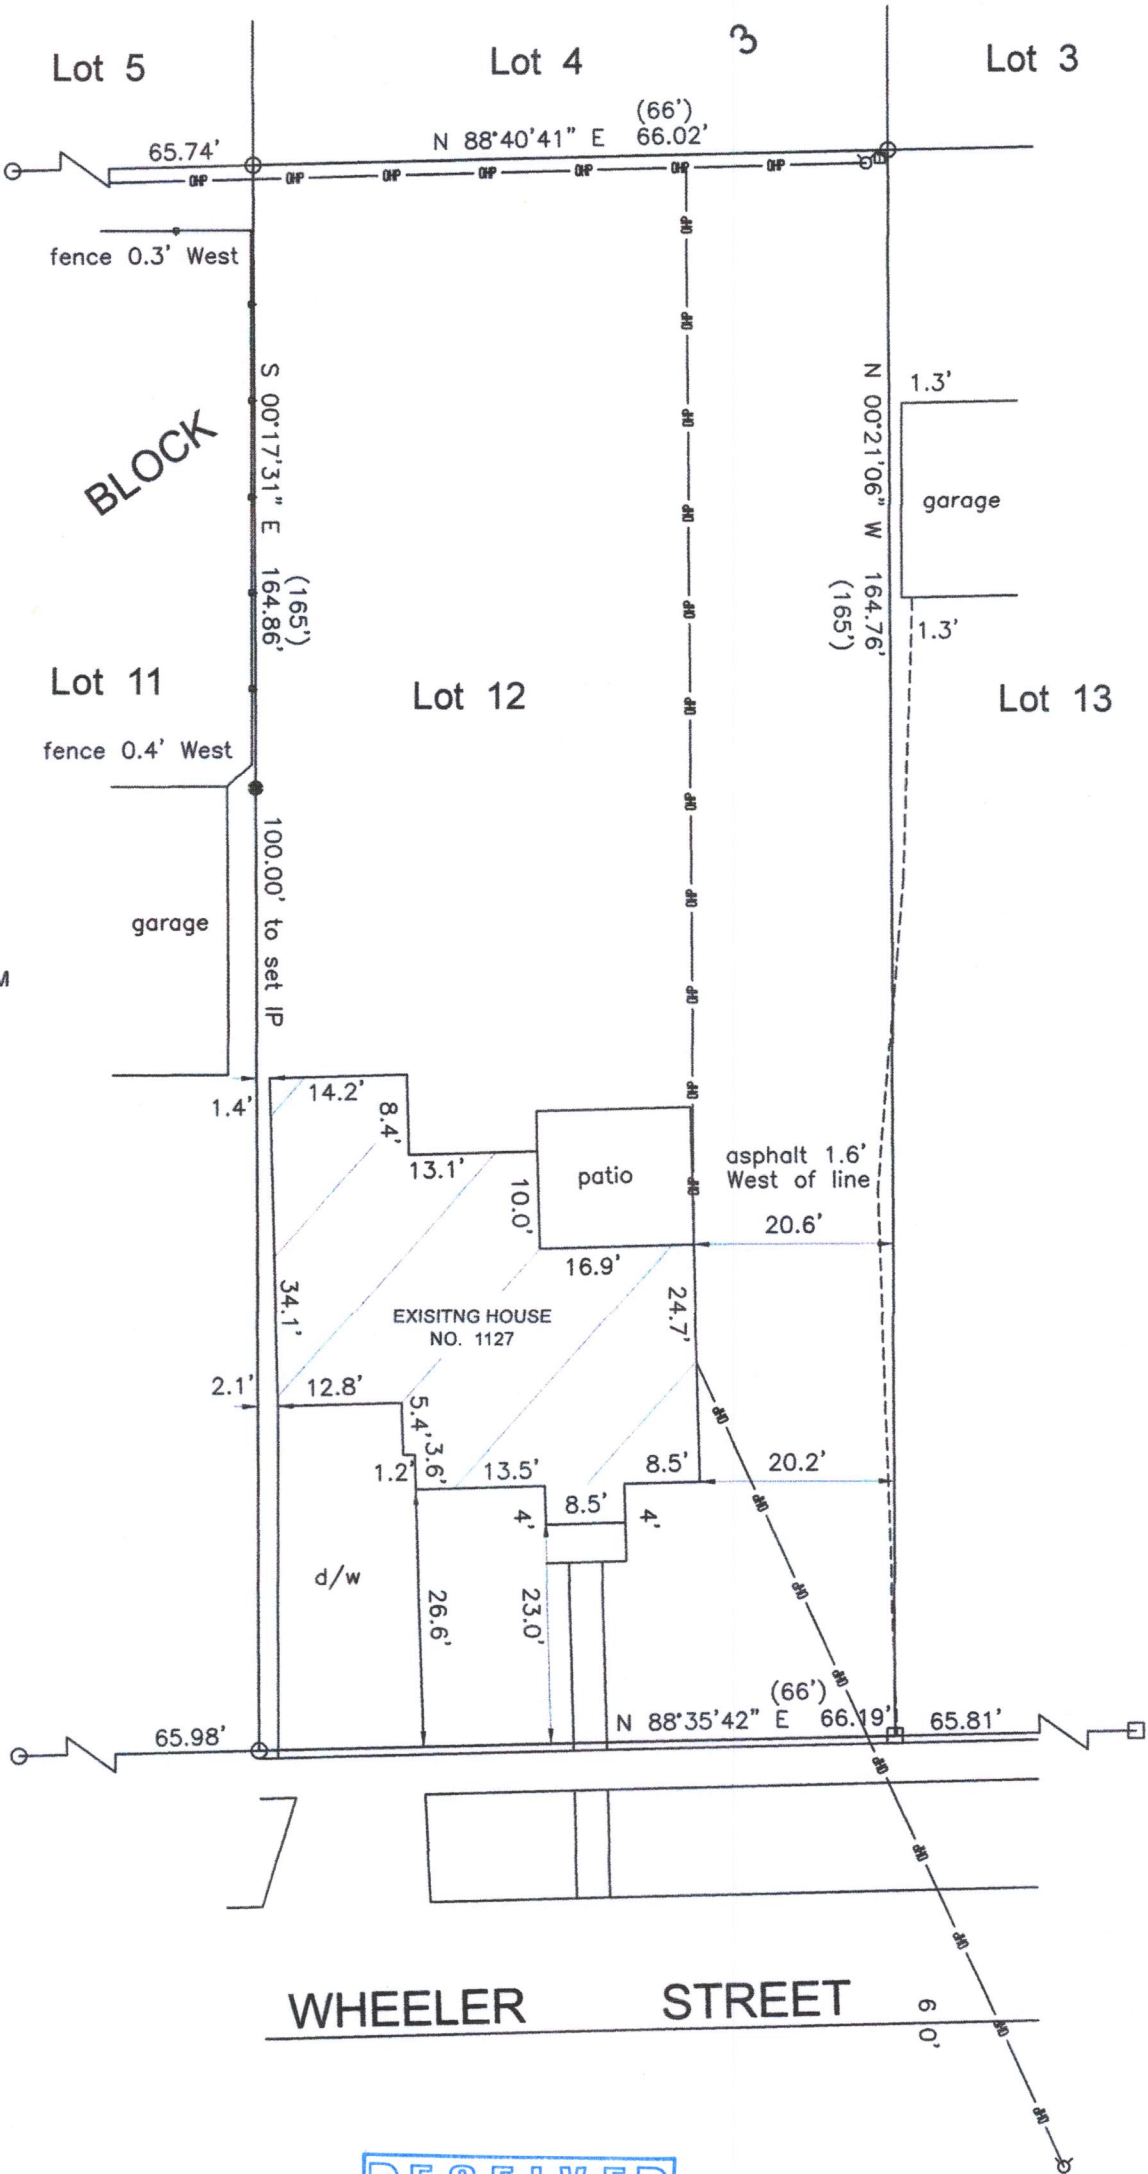

I HEREBY CERTIFY THAT I HAVE SURVEYED THE ABOVE DESCRIBED PROPERTY AND THE ABOVE MAP IS A TRUE REPRESENTATION THEREOF AND SHOWS THE SIZE AND LOCATION OF THE PROPERTY, ITS EXTERIOR BOUNDARIES, THE LOCATION AND DIMENSIONS OF ALL STRUCTURES THEREON, FENCES, APPARENT EASEMENTS, ROADWAYS, AND VISIBLE ENCROACHMENTS, IF ANY.

THIS SURVEY IS MADE FOR THE PRESENT OWNERS OF THE PROPERTY, AND THOSE WHO PURCHASE, MORTGAGE, OR GUARANTEE THE TITLE THERETO WITHIN ONE YEAR FROM THIS DATE HEREOF.

DATED THIS 30TH DAY OF MARCH 2021

Steven L Schmidt
STEVEN L SCHMIDT S - 2813
Wisconsin Professional Land Surveyor

ZWH-14

007-3902