


BROAD — (100' WIDE) — *STREET*

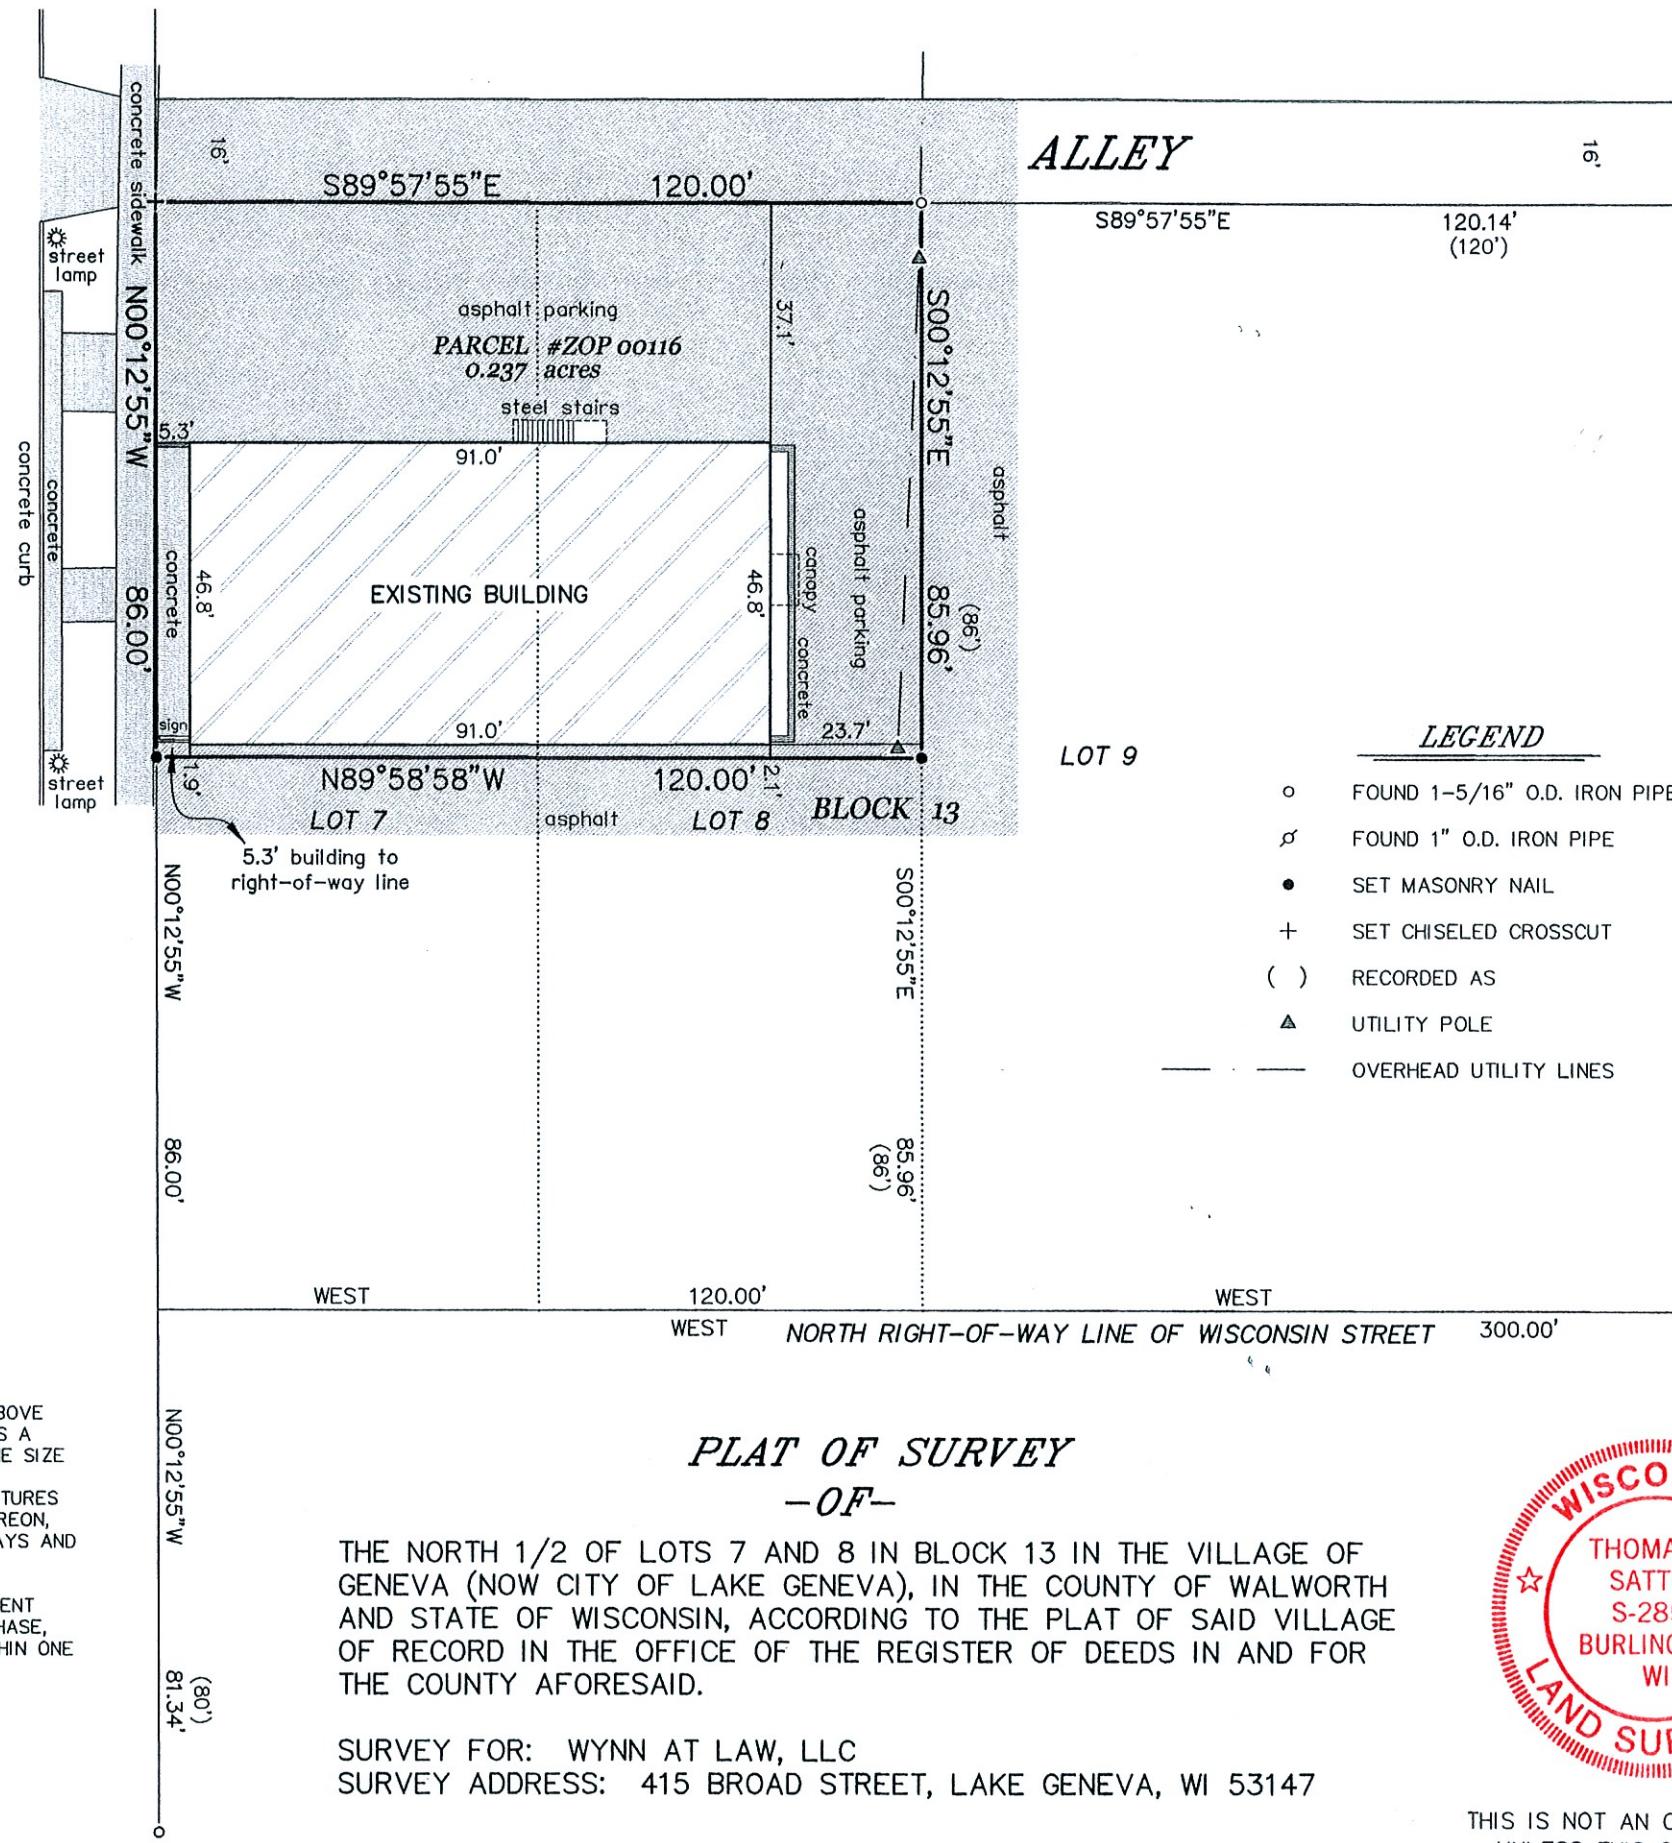

"I HEREBY CERTIFY THAT I HAVE SURVEYED THE ABOVE DESCRIBED PROPERTY AND THAT THE ABOVE MAP IS A CORRECT REPRESENTATION THEREOF AND SHOWS THE SIZE AND LOCATION OF THE PROPERTY, ITS EXTERIOR BOUNDARIES, THE LOCATION OF ALL VISIBLE STRUCTURES AND DIMENSIONS OF ALL PRINCIPAL BUILDINGS THEREON, BOUNDARY FENCES, APPARENT EASEMENTS, ROADWAYS AND ENCROACHMENTS, IF ANY."

"THIS SURVEY IS MADE FOR THE USE OF THE PRESENT OWNERS OF THE PROPERTY, AND THOSE WHO PURCHASE, MORTGAGE, OR GUARANTEE THE TITLE THERETO WITHIN ONE YEAR FROM DATE HEREOF."


SATTER SURVEYING, LLC
LAND SURVEYS, MAPPING AND PLANNING
272 ORIGEN STREET
BURLINGTON, WI 53105
262-661-4239



Thomas L. Satter
THOMAS L. SATTER
S-2850
DATE

112107
S-2850
JOB NUMBER

BEARINGS HEREON RELATE TO THE SOUTH LINE OF BLOCK 13 OF THE ORIGINAL PLAT OF LAKE GENEVA. ASSUMED BEARING OF WEST.

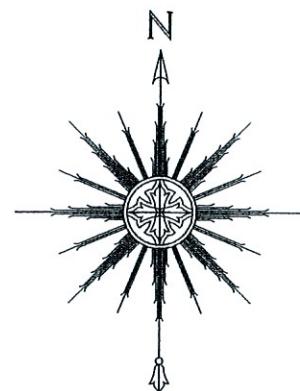

0 15' 30' 60'
SCALE: 1" = 30'

DECEMBER 10, 2021
DATE