



61-6

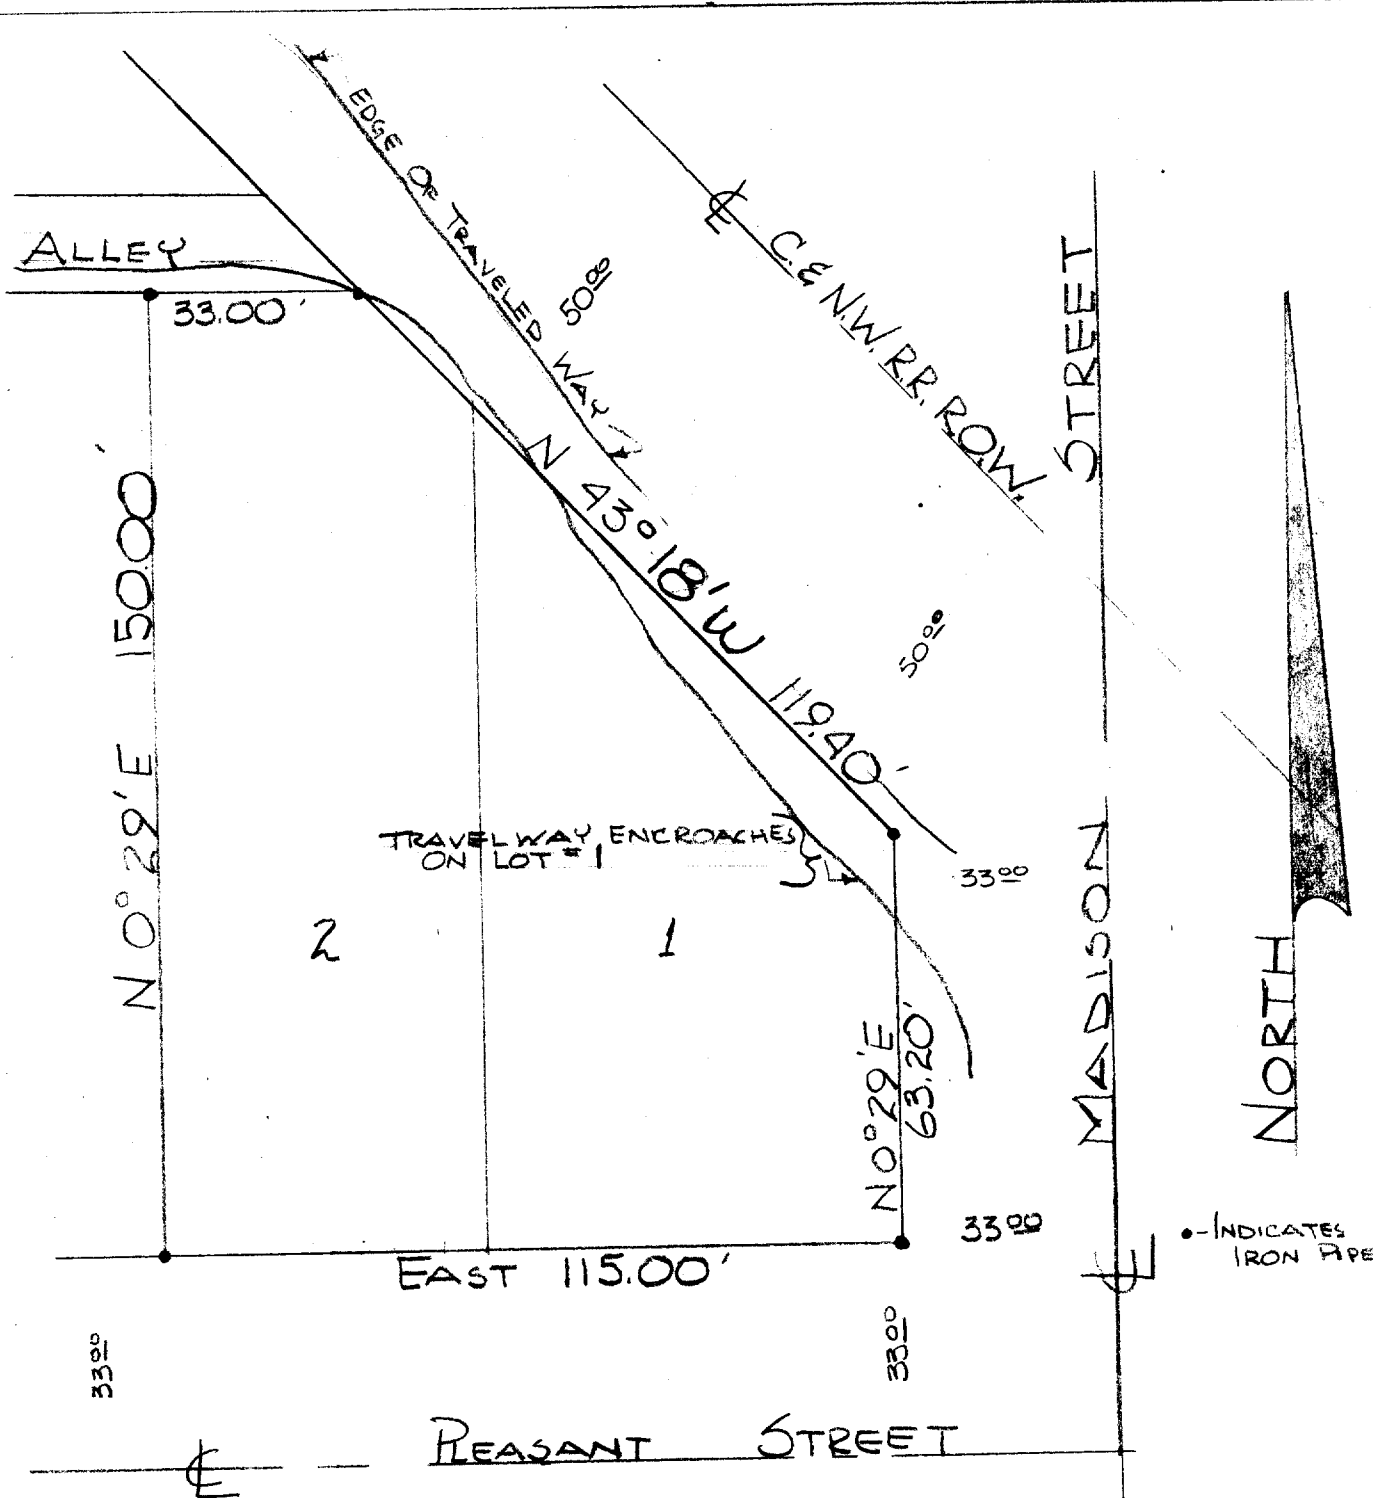

DESCRIPTION: Lots 1 & 2 of ~~subdivision~~ in the City of Lake Geneva, Walworth County, Wisconsin.

CERTIFICATE: I, James F. King, surveyor do hereby certify that I have surveyed the property herein described, on the 28th day of July, 1961.

James F. King

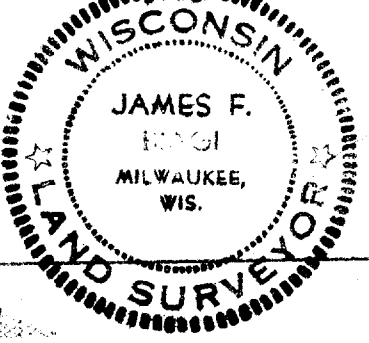

61-6

CL-1