




SCALE 1"=20'
● CONC. MONU.
○ IRON PIPE

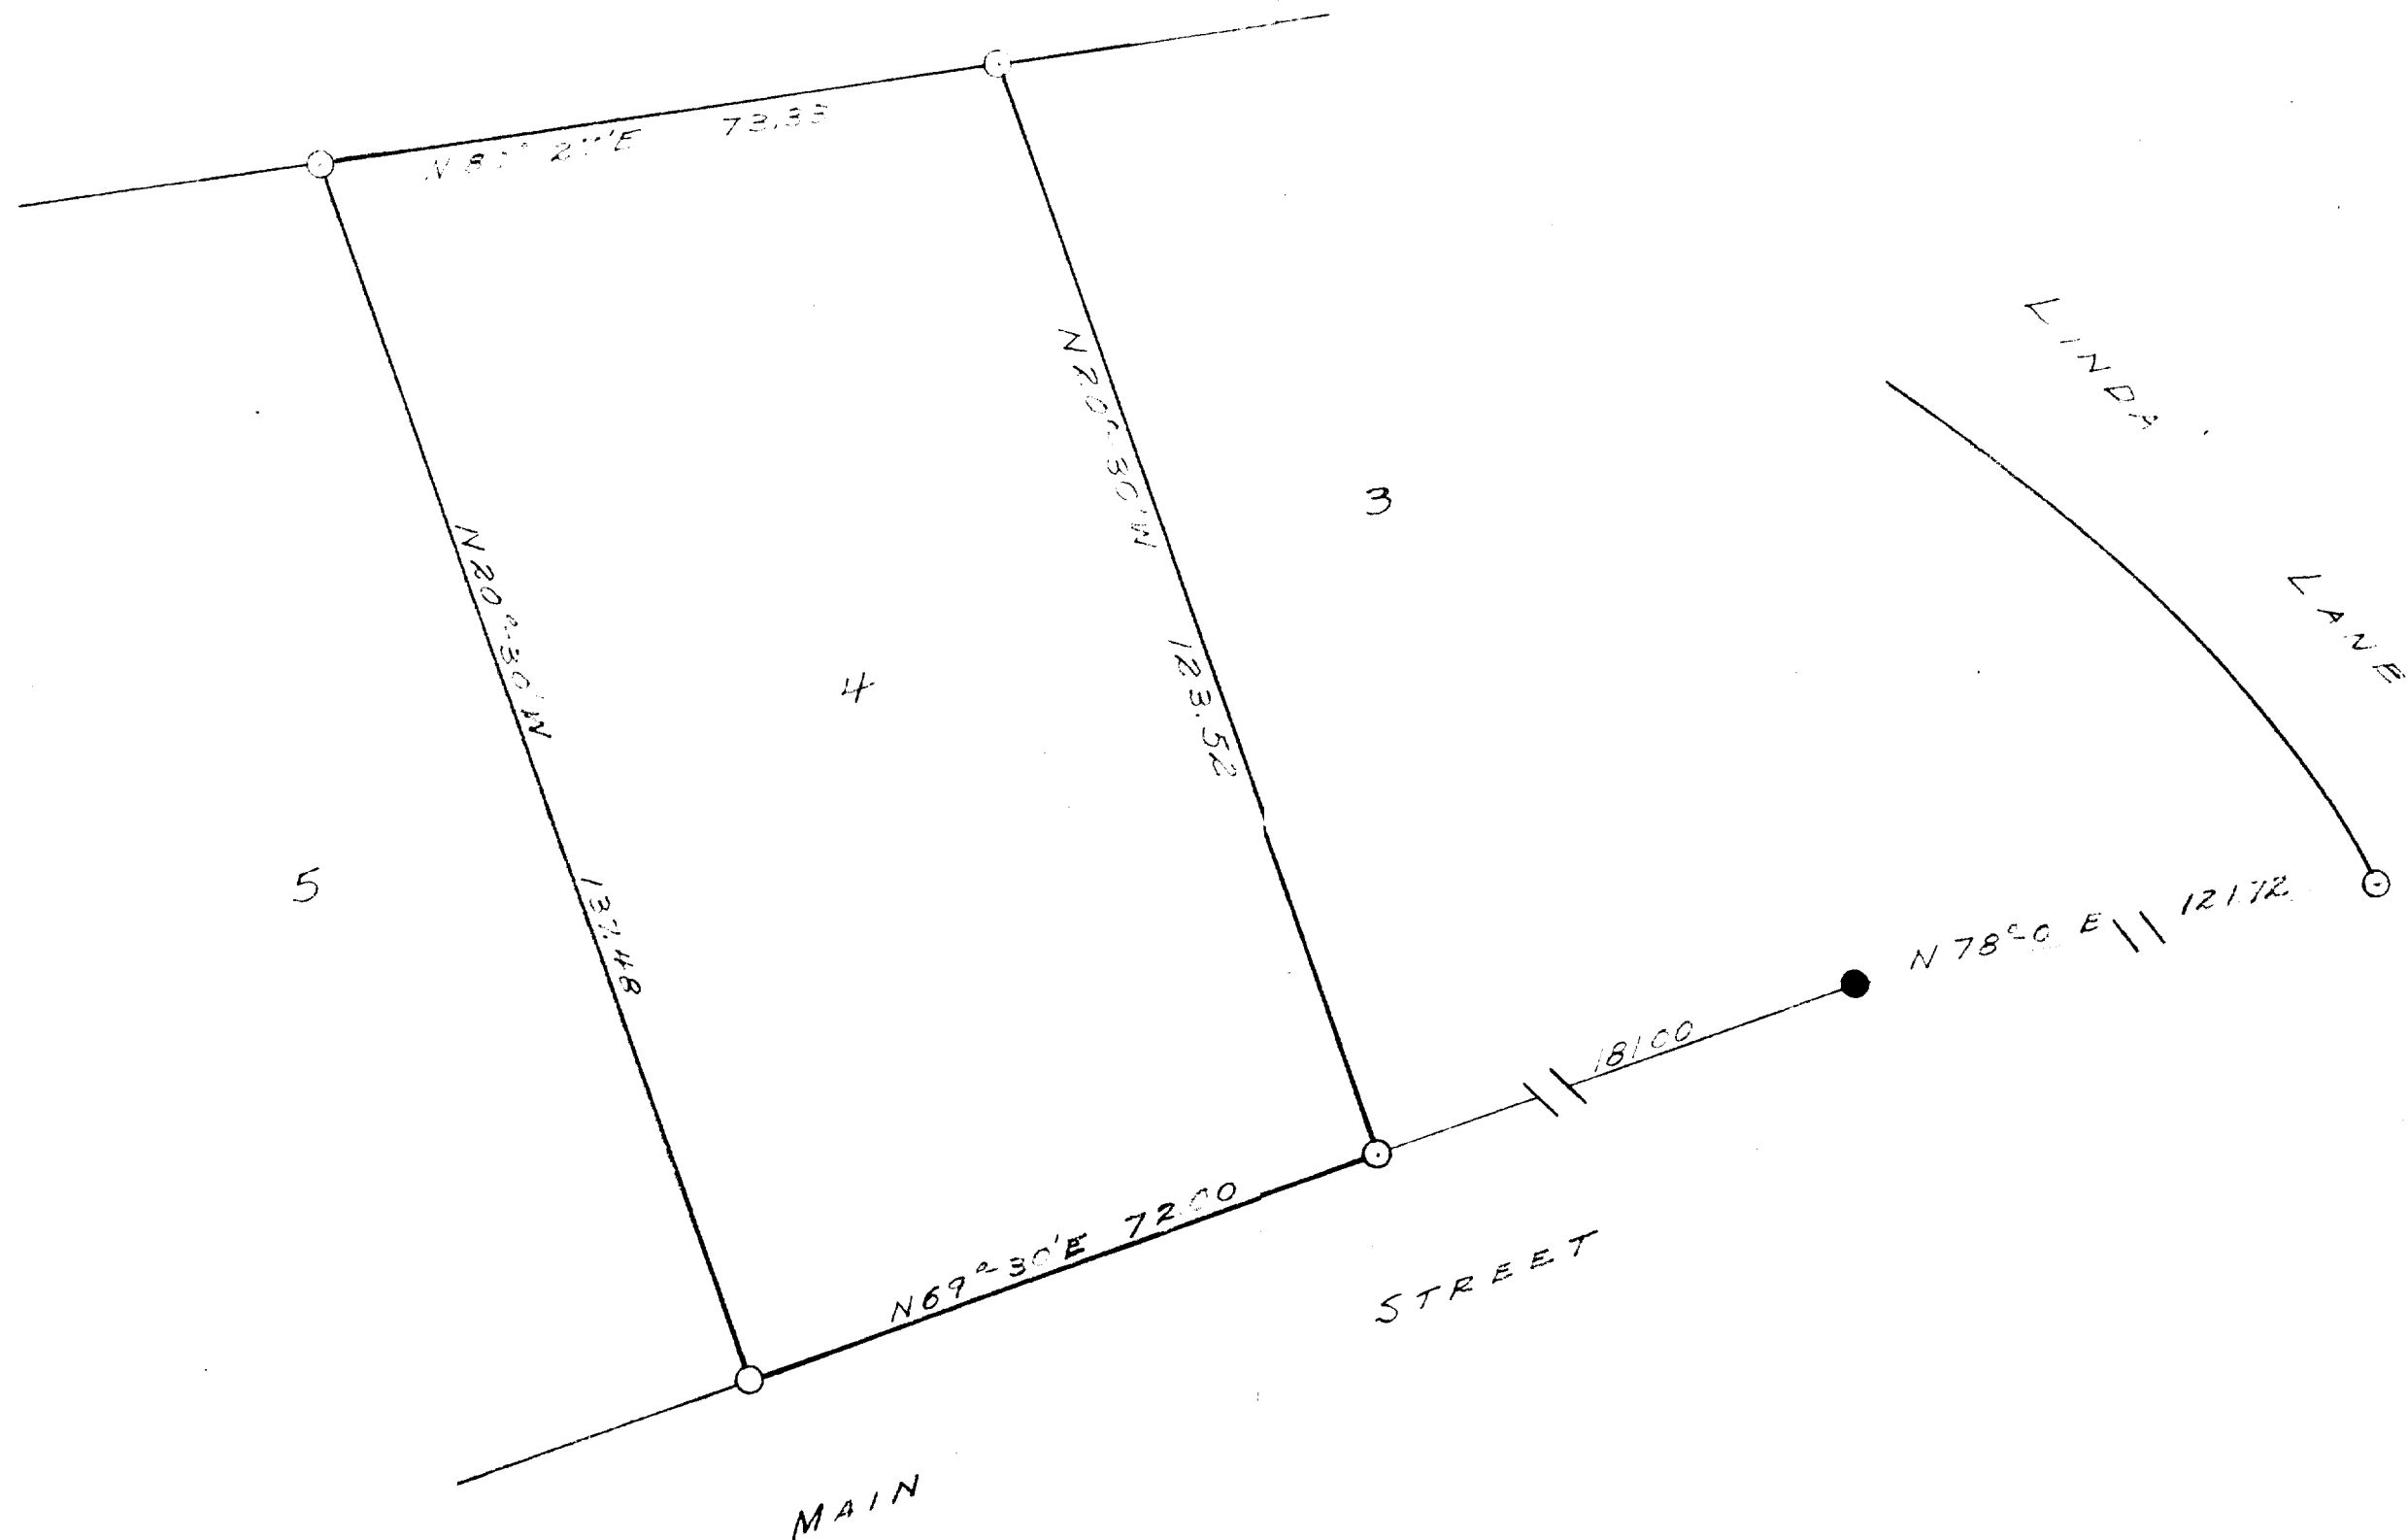

STATE OF WISCONSIN)
COUNTY OF WALWORTH) SS.

I, LLOYD L. JENSEN, DO HEREBY CERTIFY THAT I HAVE
SURVEYED THE PROPERTY SHOWN HEREON ACCORDING TO THE
OFFICIAL RECORDS, AND THAT THE PLAT ABOVE IS A
CORRECT REPRESENTATION OF THE LOT LINES OF SAID
PROPERTY.

ELKHORN, WISCONSIN
MARCH 16, 1954

7-40J

Lloyd L. Jensen
WALWORTH COUNTY SURVEYOR

PLAT OF SURVEY OF

LOT 4, STURWOOD
ADDITION TO THE CITY
OF LAKE GENEVA, WALWORTH
COUNTY, WISCONSIN

Lloyd L. Jensen
SURVEYOR

SCALE 1" = 20'

DATE MARCH 1954