

71


6/29/21

Survey for O. Paulson, Lot 45, Ferguson Ad.
Found original Cor. Sta. of this block set when
plat was surveyed, Depression in top 1' E. of walk
and 8' N. of walk

Measured east 66' and set 2" iron stake 8' N. of
walk.

Measured North 151' and set 2" iron stake 1'
from walk. Brick alley crossing is 18.8' should
be 16'. Yel. poles are in lot.

Measured E 66' and N 151' from S. E. Cor. and
set 2" iron stake, Paulson's chicken fence partly
on line,
Lot 66' x 151'

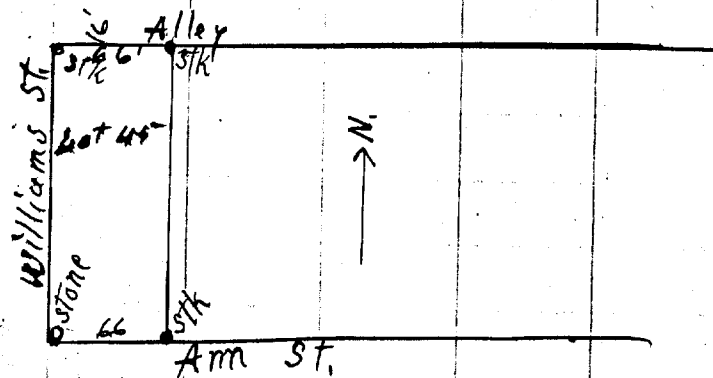

Lot 45 - Ferguson's add.

ZF-42
43

7-413-sk