


72 6/29/21

Survey of lot 1. B. 25
 Found stake at N.E. & S.E.
 With transit set N. line
 16' E. of N.E. Cor. stake
 N.E. Cor. stake and 66'
 26. and set 2" iron sth
 lot 2 and 66' S. from
 iron stake. Set 2"
 Double white oak & B.O.
 West of center.

Crawford, Roy Wightman
 lot 60' by 172'
 Cor's lot 2 also N.E. cor lot 1,
 of lot and set 2" iron sth
 lot 2. Measured S. 60' from
 West from N.W. Cor. Lot 2. Block
 Measured E. 16' from S.E. Cor.
 N.W. Cor. lot 1. and set 2"
 iron stake at N.E. Cor.
 in group on south line

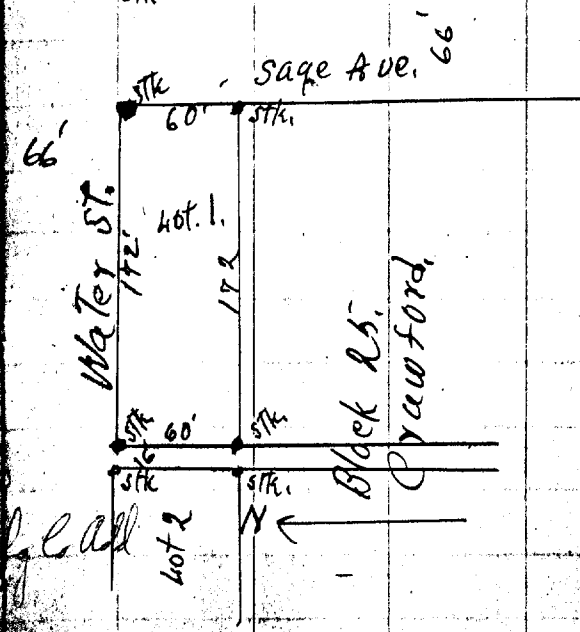

Lot 1 Blk 25 Gen. Lake Crawford M. Call