


SAGE

STREET

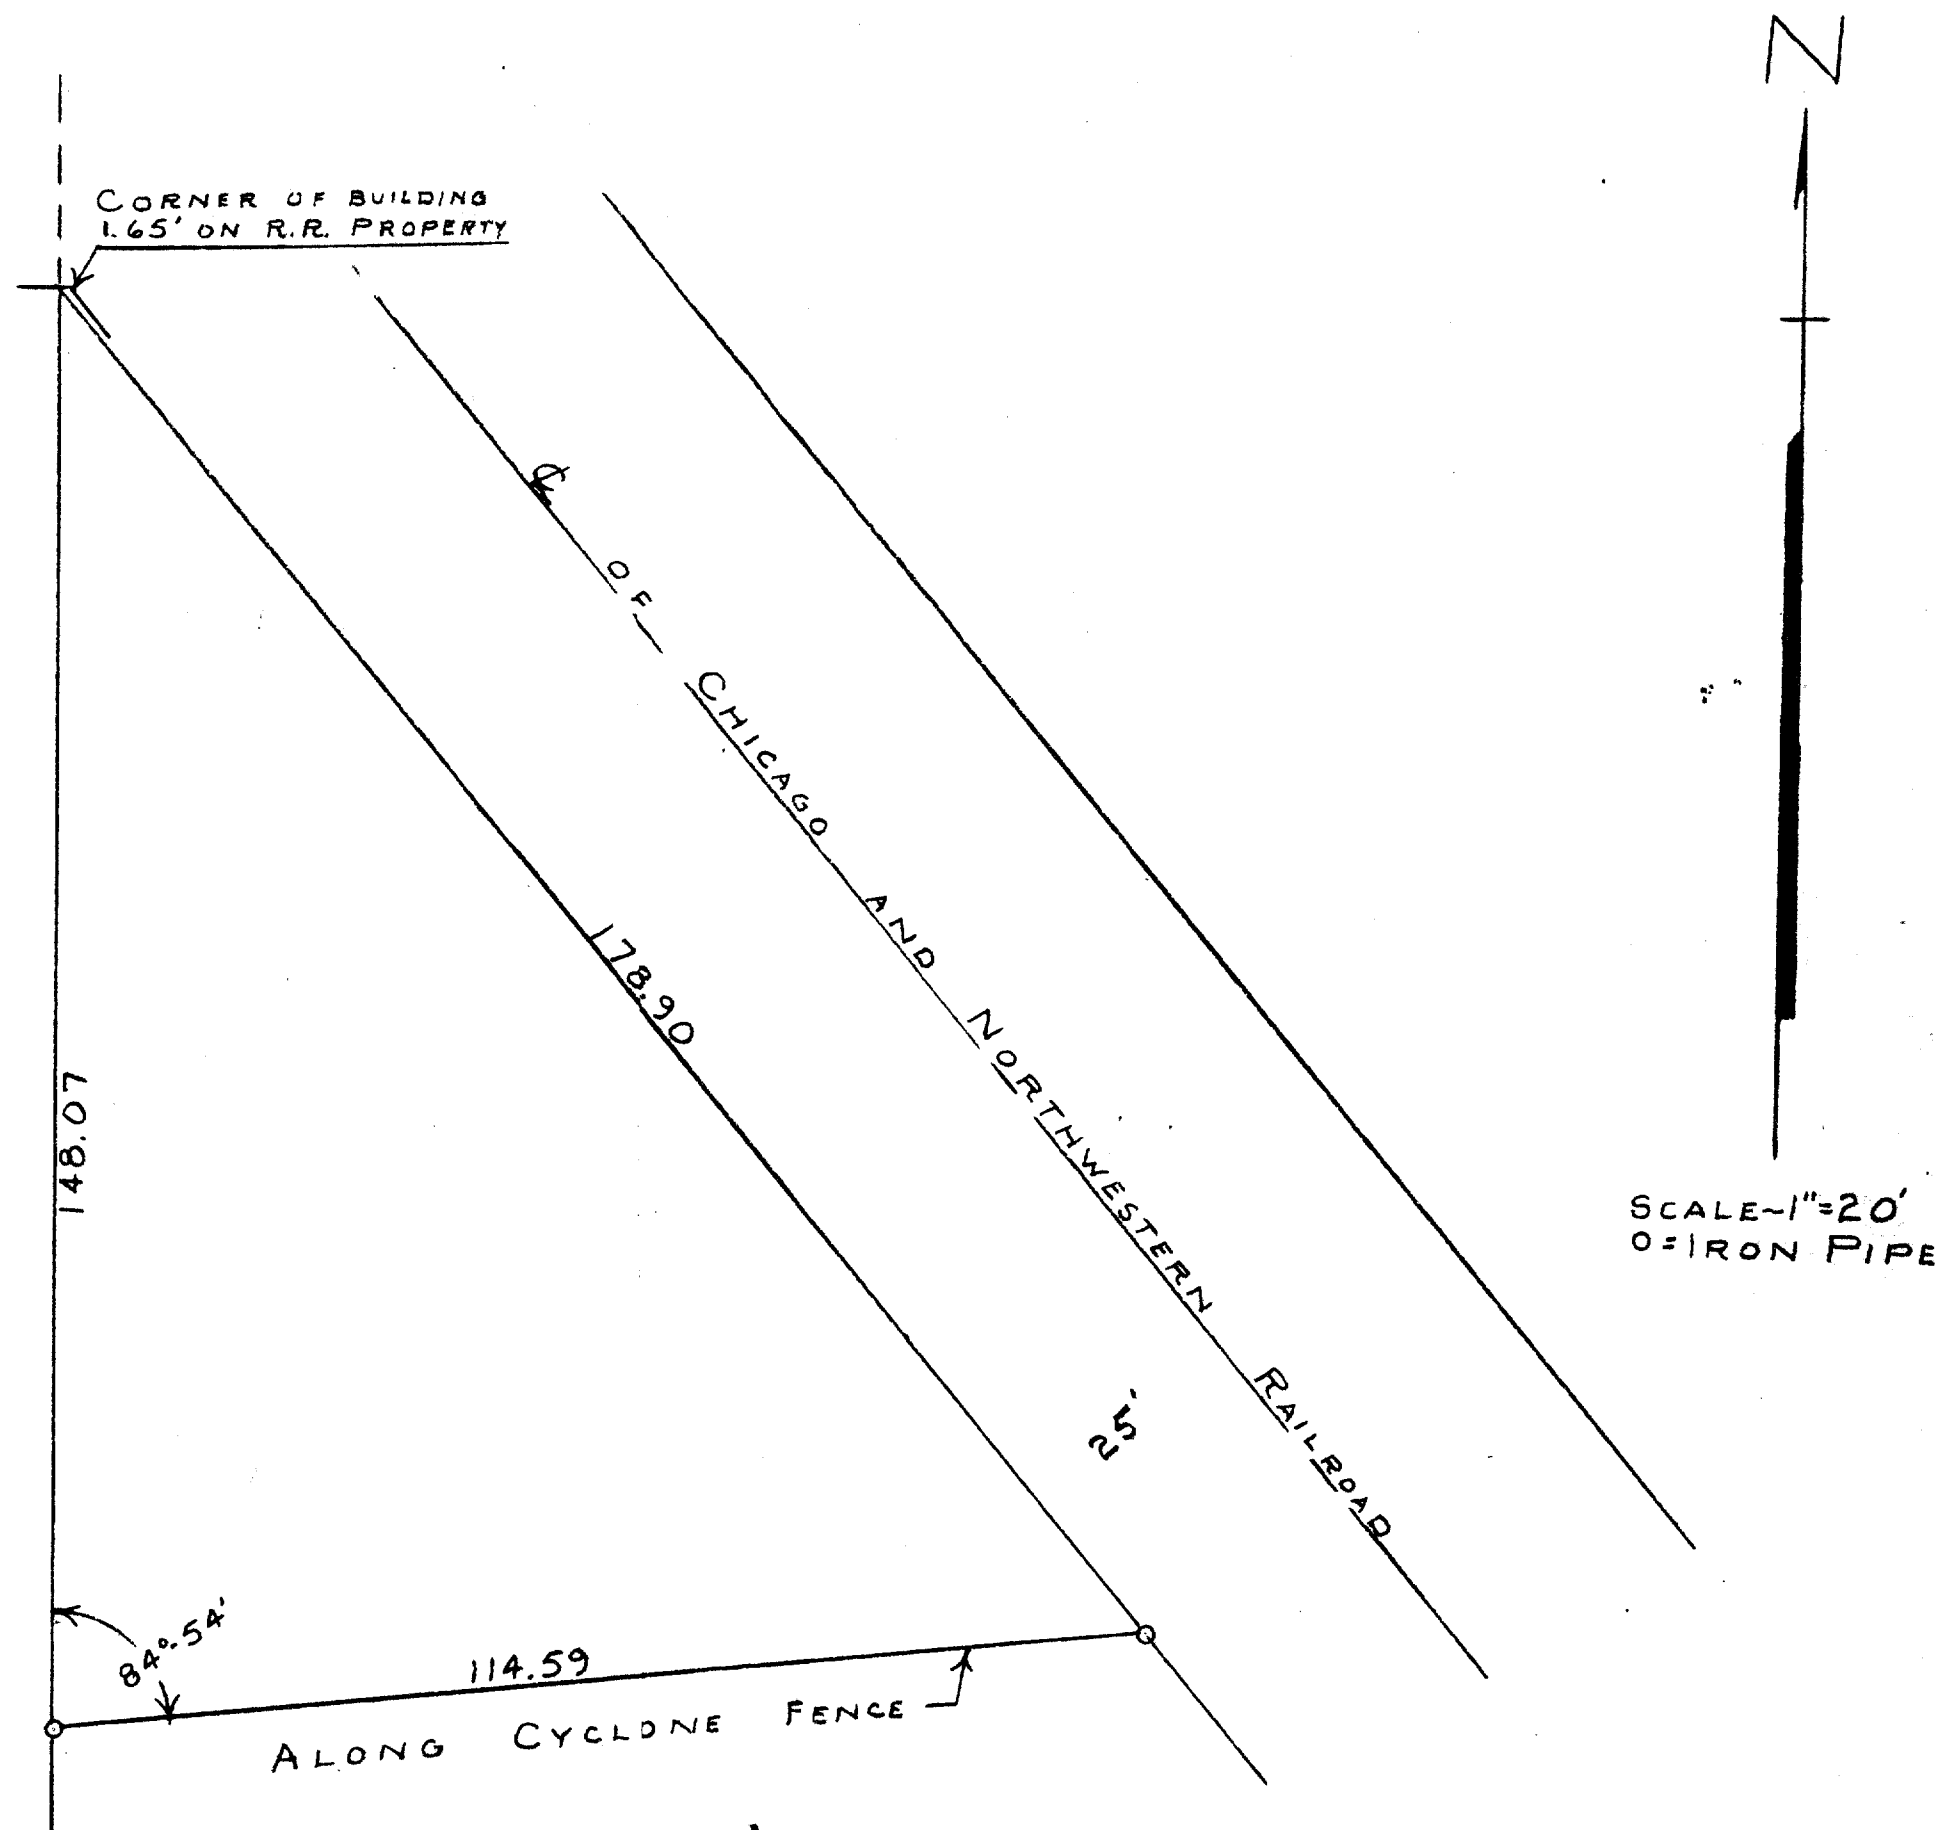

PLAT OF SURVEY OF A PARCEL OF LAND LOCATED IN THE NE $\frac{1}{4}$ OF
SECTION 36, T2N R17E, CITY OF LAKE GENEVA, WALWORTH COUNTY,
WISCONSIN
NOV. 1956

George T. Dunham
GEORGE T. DUNHAM, SURVEYOR
DELAVER, WISCONSIN

7-42