
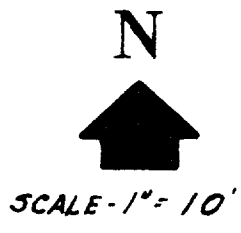


Shred and

HAROLD M. KOLB
REGISTERED PROFESSIONAL LAND SURVEYOR
715 BUILDING
LAKE GENEVA, WIS. 5314

ALLEY - 16' Wide

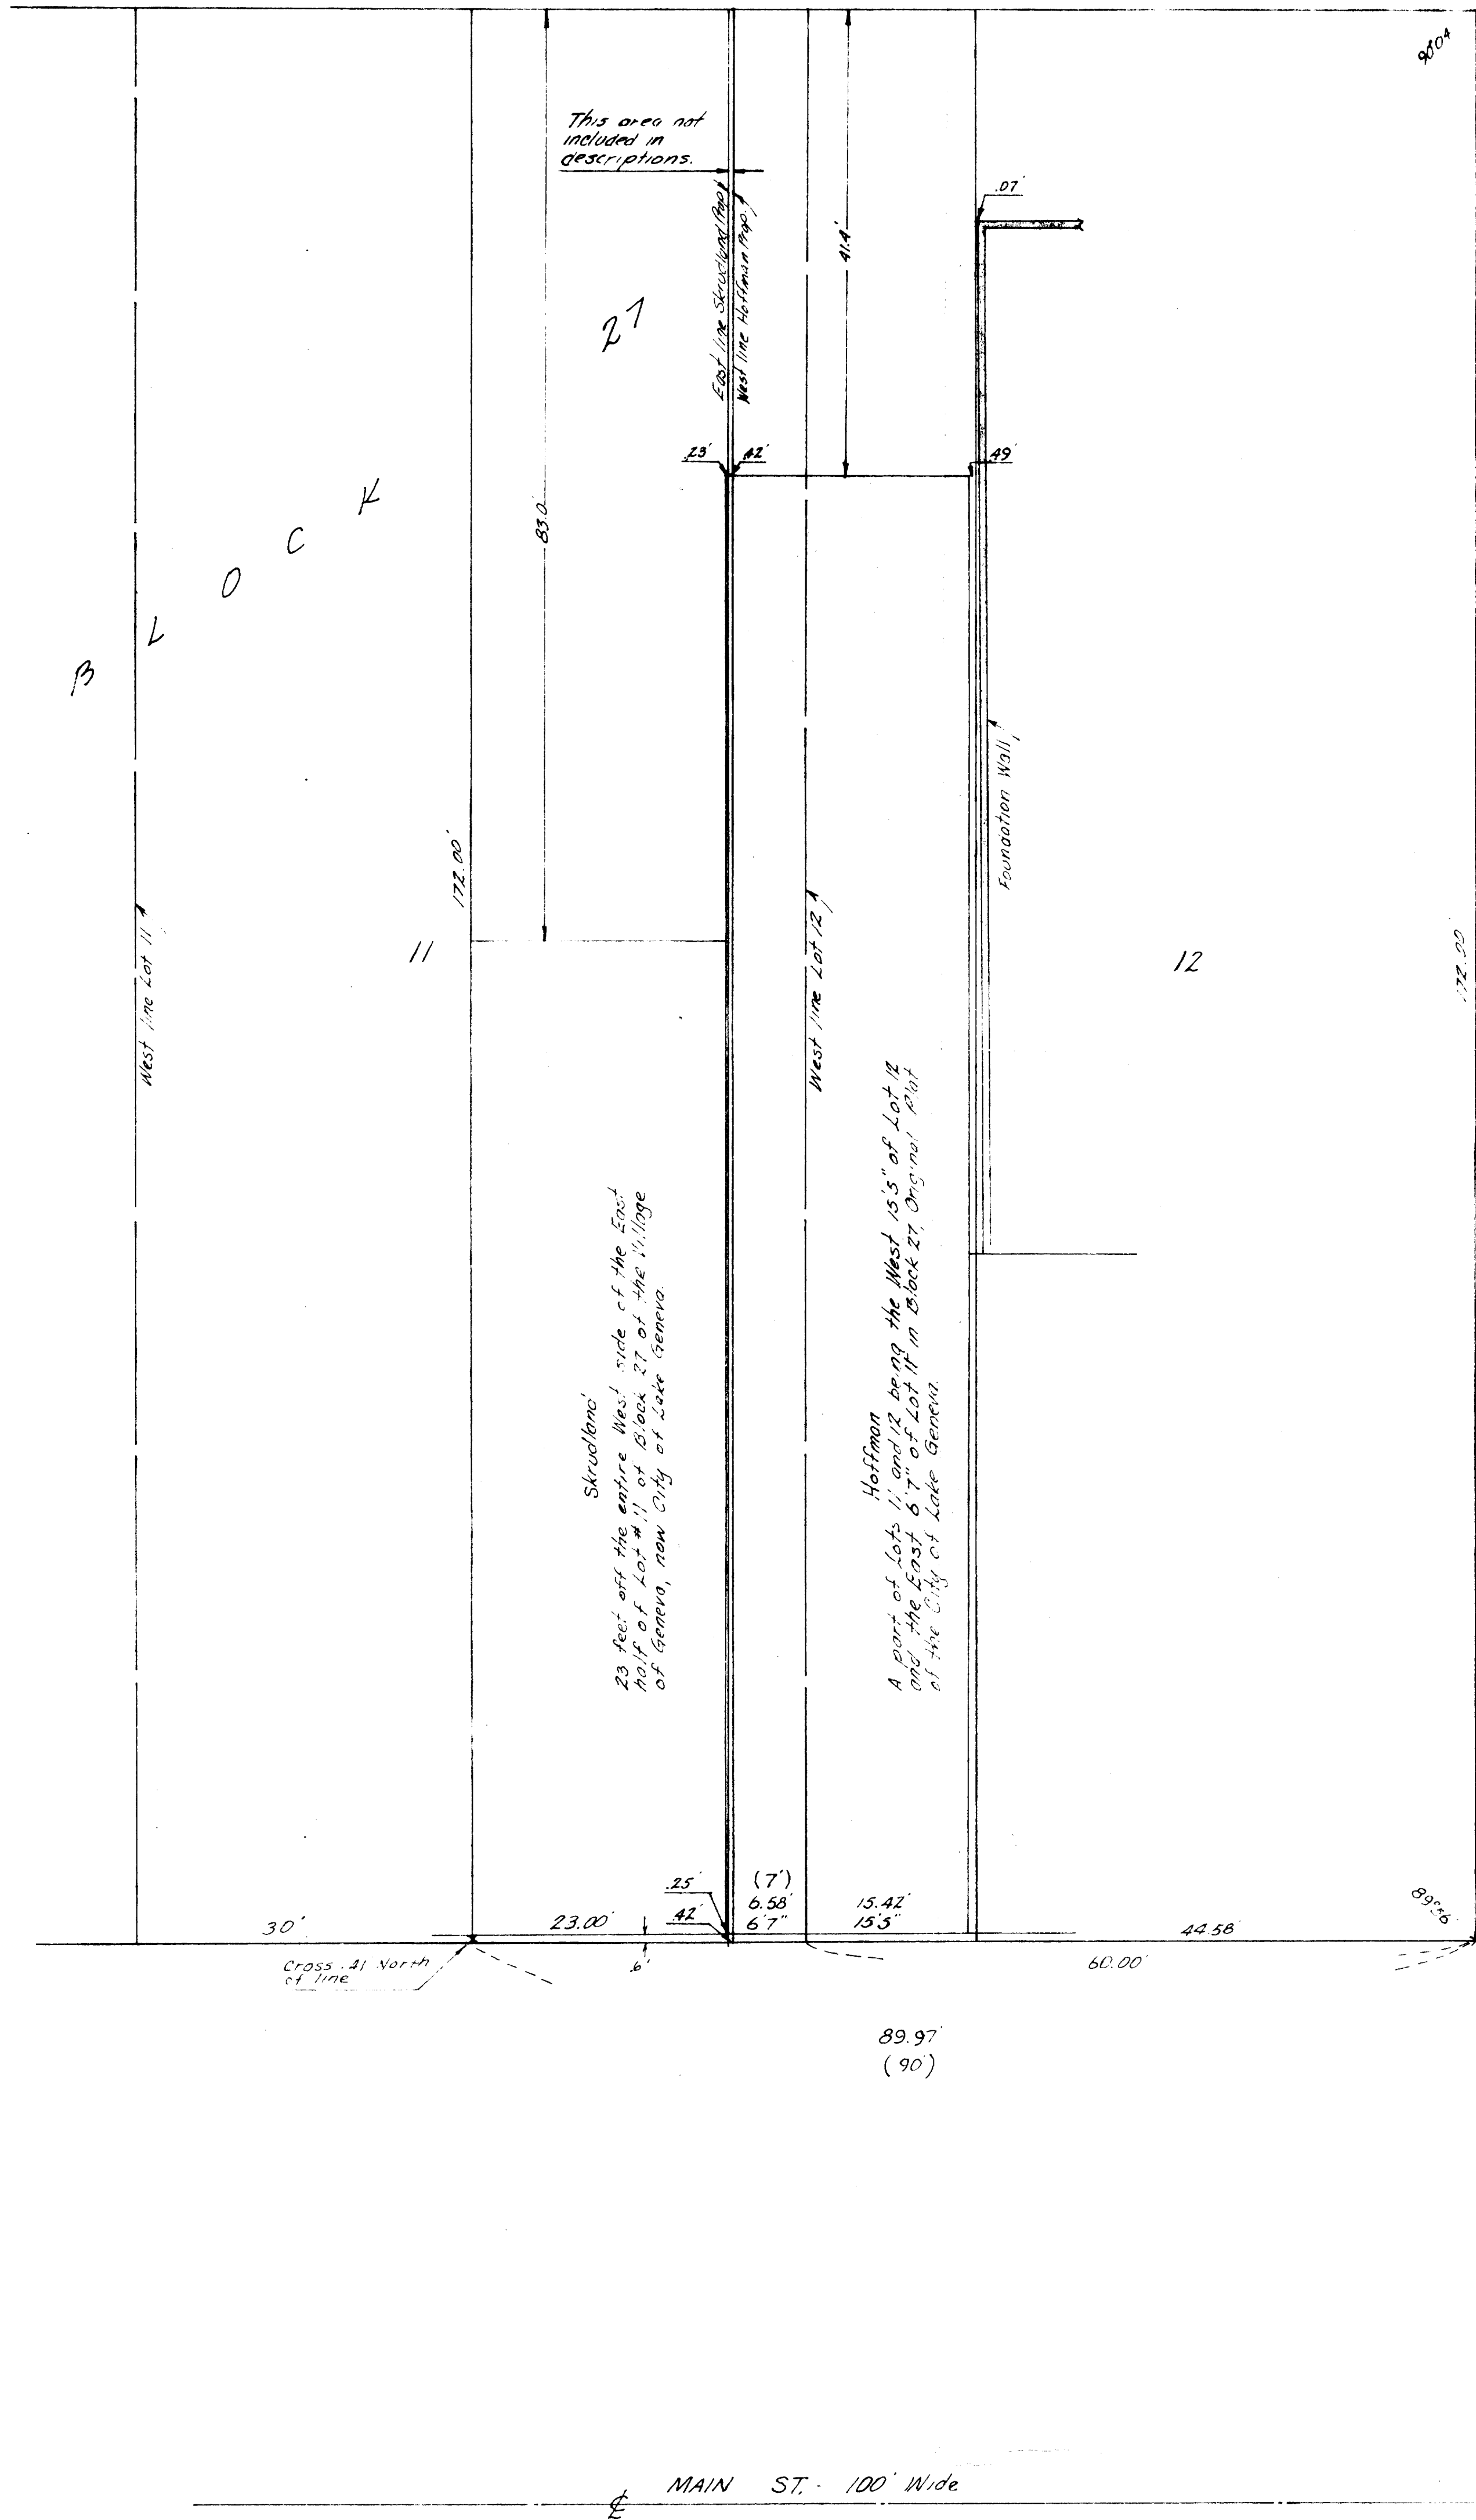

SCALE - 1" = 10'

x - Found cross cut in line
() - Described as

PLAT OF
Part of Lots 11 and 12, Block 27,
Original Plat, City of Lake Geneva,
Walworth County, Wisconsin.

CENTER ST. 80' Wide

7-422