


70

6/29/21

survey for Lot 84
 Stake found at S.W. +
 Stake " at S.W. cor.
 With The S.W. stakes
 E. stakes 50' E.
 S.W. stake which is

columbian. Request Ed. Reinert
 S.E. Cors. & verified
 lot 43. West line set straight
 N. stakes 150' N of S. stake
 All 2" iron stakes except
 1"

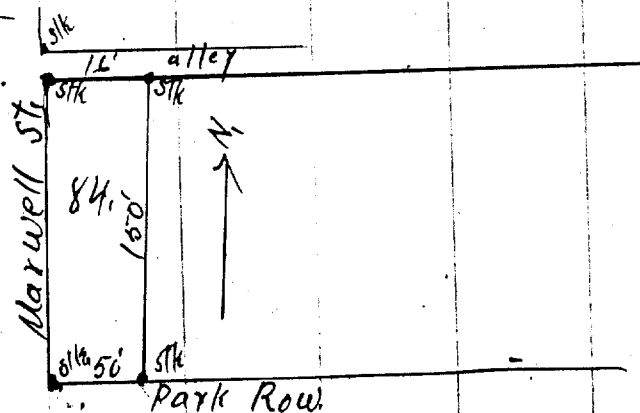

7-424-sh