

Oct 31, 1938 25
Mrs. Mason called for survey ~~of~~
of the following:

The North Twenty Five (25) feet of
the west One Hundred (100) feet of
the south Eighty Six (86) feet of
Lots Seven (7) and eight (8). Block
Seventeen (17), Village of Geneva,
Wis. now City of Lake Geneva,
Wis.

A bldg at the rear of the above
described lot ~~at~~ this bldg extends
north of the south line of the
above lot and is to remain as
long as needed, as it is, but if
removed or torn down then this

permit terminates

Began survey at 9 A. M. and
finished today's work at 11 A. M.
2 hours + 25¢ \$3.30

measured E. wall Cook St. 172'
alley to N. wall line Geneva St.
Measured on the wall N. line Geneva
St. 362.5' Measured N. from N line
Geneva St. 86' + 61' at 61' found
iron sth. 1.15' E. of wall at 86'
found iron sth. 1.15' E. of wall
Measured E. 100' from sth. at alley end
See page 37

27 Mrs. Mason contd
Made point at inner line of

new basement wall form,
measured east from point E. S. of
alley str. S. W. cor. of Main.

Mason's lot iron str 11 1/2 in.

measured E. on this line 100'

and made point 1.15 ft. E. of

inner face of stoner laid to
mark S. E. Cor. of Mrs. Mason's
lot.

Measured E. on N. line of
walk, N. line Geneva St. 100'

and made point. Measured
N. 11. to West line, 58.6' to

bdg, measured E. on bldg 8.4

To E. line of bldg, extended N.

line Geneva St. walk 1.4' and

measured N. to N. line of bldg, etc.

Then West 8.4' along N. line
of bldg, and set iron str. opp wall

str. South point is on E. line
of Mason lot.

E. line Mason lot runs along
E. line of inner form
basement wall.

This makes location West wall
of basement as built the full

Mrs. M. Mason contd.


28

thickness of wall and form
west East of East line of lot,
and this plus extension of
of eaves will give building
line of basement.

Survey to be completed
when other conditions are
completed.

B. B. Shuck
Survey completed June, 6-1939
iron stakes set at all 4
corners.

N. 25' of S 1/2 of West 100 ft
of lots 7 & 8 Block 14
Original Geneva Village

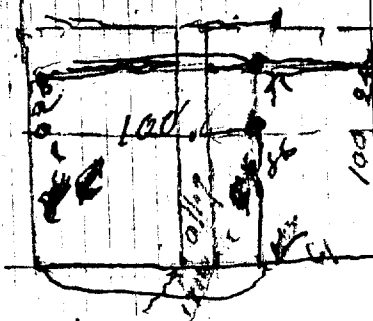

Lot 100' E + W
by 25' N + S,

Mrs. Margaret Mason

Survey completed.

Description, B.L. #529 + B.P. #17

Lots 7 + 8 - Block 17 City of Geneva

North 25 ft. of the West One

Hundred feet of the South 86

feet of Lots 7 + 8 Block 27

original Geneva Village

Completed Jan. 6 - 1939.

Two Blue Print maps.

Description

Begin in the West line of Block

17 (East line of Cook St.

at an iron stk 1.2 ft. East

of E. line of walk, thence South

1.2 ft. East of walk 25 ft. thence

E. parallel to and 61 ft. N. of

N. line of side walk 100 ft. thence

N. parallel to said East line

Cook St. 61' S.E. Cor. parcel

therewith surveyed, to an iron stk.

thence in same line N. 25 ft. to an

iron stk. this line is 101.2' of

E. line of Cook St. thence West

parallel to N. line Geneva St. 250

ft. to point of beginning. tall

wood stakes are set at N.E. &

N.W. Cors said parcel contains

3
lot flat-topped
East line is at East line of row
2500 sq ft more or less

50

5/18, 21,

Survey of Lot 8
Stake found at N. E. Cor.
Stake S. E. Cor. Lot 10
line Lot 8. B. 17,
E. line, 120' W. of
line 60' W. of
1" iron stakes set
Wood stakes set at
Block 17.

Block 17, Mrs. O'Brien
Lot 10. Block 16, and old
Block 17 and used to
Lot 60' x 172'
W. line of Block 17, W.
E. line
at all 4 corners.
N. E. & ~~S. E.~~ Cors. of Lot 10

Pessie Palmer Asst.

OP-168

169

170

Lot 8, Blk 17 One Plat

7-426-1