


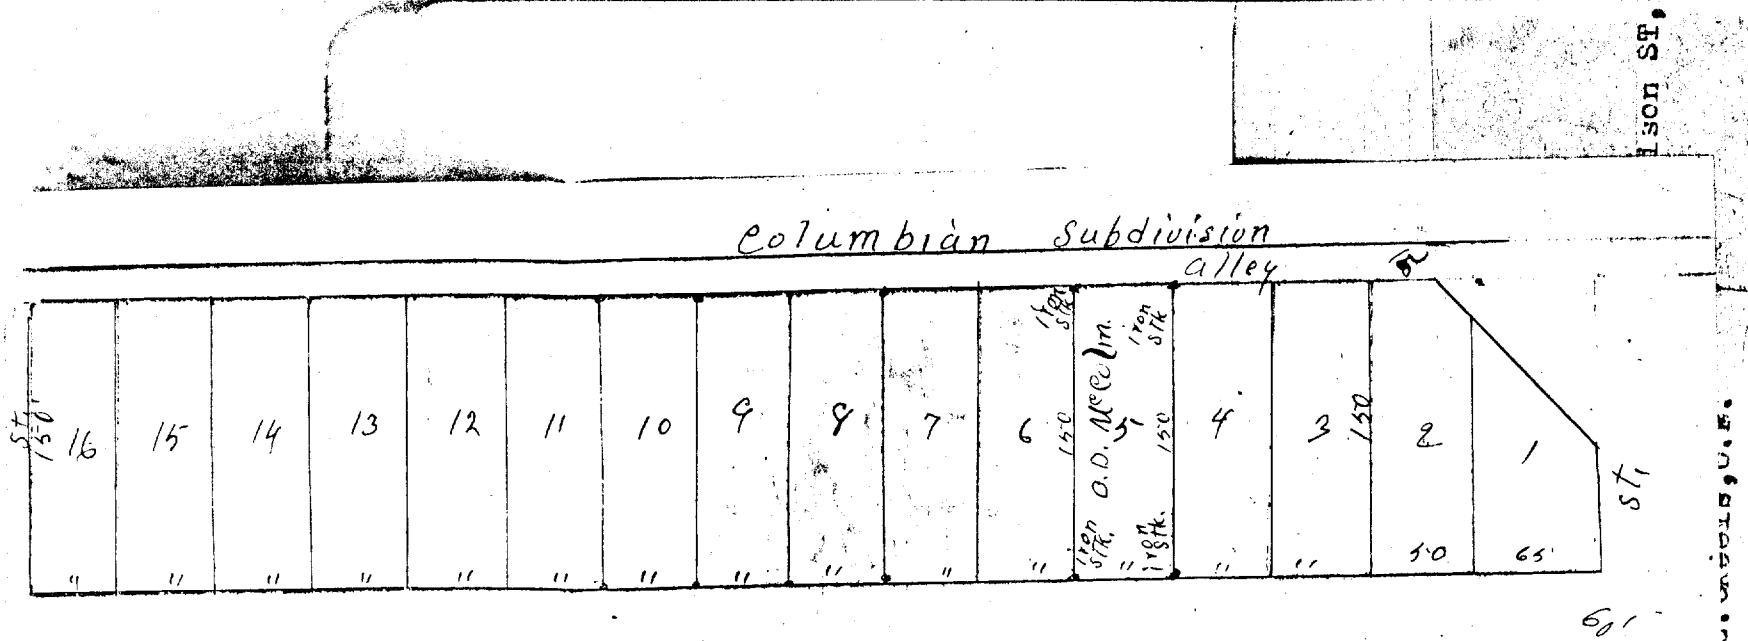

Maxwell
 Pleasant Street
 By request of O. D. McColm we have surveyed and staked
 Lot No. 5, Columbian Subdivision, Lake Geneva, Wis., as indicated
 hereon, Lot 50' x 150'.
 Iron stakes, previously set for lots 8 & 10 were found and verified
 and at 100' east of east cors of Lot 8. Iron stakes were set
 and at 50' east of these iron stakes were also set as indicated.
 April 3, 1922.
 Scale 100' to 1"
 J. G. Skeels, C. E.
 Bessie Palmer, Asst.
 charged \$1.80

Lot 5 - Columbian Subd.

7-438.2k

April 1, 1922
Survey for W. McColm.
Measured E. 100' from
set iron stake from
Measured east 100' from sta.
iron stake. Measured
and set iron stake.
stakes.

Lot 5 Columbian,
Stake at S. E. Cor. Lot 8, and
this point E. 50' & set iron stake.
N. E. Cor Lot 8, and set
E. from last stake above 50'.
All 4 corners marked by iron

Columbian Subd.

CL-4

7-428-sk