

60

Apr. 1, 1922

Began survey for
Marsh Addition.

Found iron stake at N.W.
at S.W. Cor. Lot 7. Verified
for N.W. Cor. Lot 10.
Stake.

Measured E. on N line
set by self in 1911 for
point above and dug
found. Measured S.
and made point (note)
set small stake, then
stake on trace. Lots 180

Apr. 2, 1922

Finished survey for
as follows:

Set transit over a point
S. of Cor. Stone N.E. Cor.
Cor. stake S.W. Cor. Lot
measured West 256'
Lot 10 and W. line
Measured south 60' and
Franklin Ave. 180' S. of
lined in and set iron
Lot 60x180' Well
Small Box elder

Howard Bence, Lot 10, D.O.

Cor. Lot 2, and wood stake
wood stake and set iron stake
Measured south 60' and set iron

of Lot 2 and dug for stake
D. Boutelle, also 120' south of last
for stake. No stakes or evidence
on E. line Franklin Ave 120'
in com. walk) Measured W. 180' &
W. 16, & dug for stake. No
by 860 & 16' alley N.W.S. thru the Block.

Howard Bence, Lot 10, Marsh Add.

in E. line Franklin Ave. 120'
Seet. 35-2-17 and set rod over
7. Sighted over line to rod and
and set iron stake for N.E. Cor.
of alley.

W. (from a point in E. line of
Seet. Cor. above) 256' and
stake for S.W. Cor. Lot 10,
entirely in lot 10,
midway on S. line.

Jessie Palmer set


7-429-sh

Apr. 11, 1922
Began survey for
Marsh Addition
Found iron stake
at S.W. cor. lot 4
for N.W. cor. lot 10.
Stake.

Howard Bengel lot 10, D.C.
and wood stake
at N.W. cor. lot 2
Measured south 60' and set iron
stake and dug for stake
also 120' south of la
stake. No stakes provided
line found in the 120'
m. walk. Measured W. 120'
16, dug for stake. No
stake. With the B.

ward Bengel lot 10, Marsh
E. line found in 200, 12
83-2-17 and set rod or
sighted over line to rod or
and set iron stake for N.E.
of alley.

Measured West 236'
Hot 10 and W. line
Measured south 60' and
found in the 120' S of
line and set iron
stake for S.W. cor. lot 10.
Midway on S. line
Bessie Palmer &

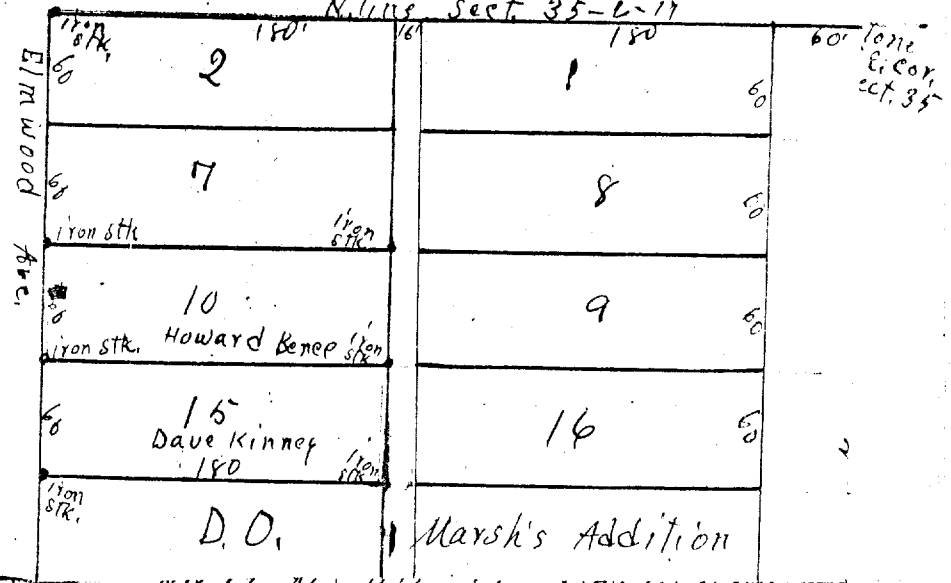

Small box & 1 der
Hot 60x150
lined in and set iron
stake for S.W. cor. lot 10.
Measured south 60' and
found in the 120' S of
line and set iron
stake for N.E.
of alley.