


ROAD

RIDGE

50'

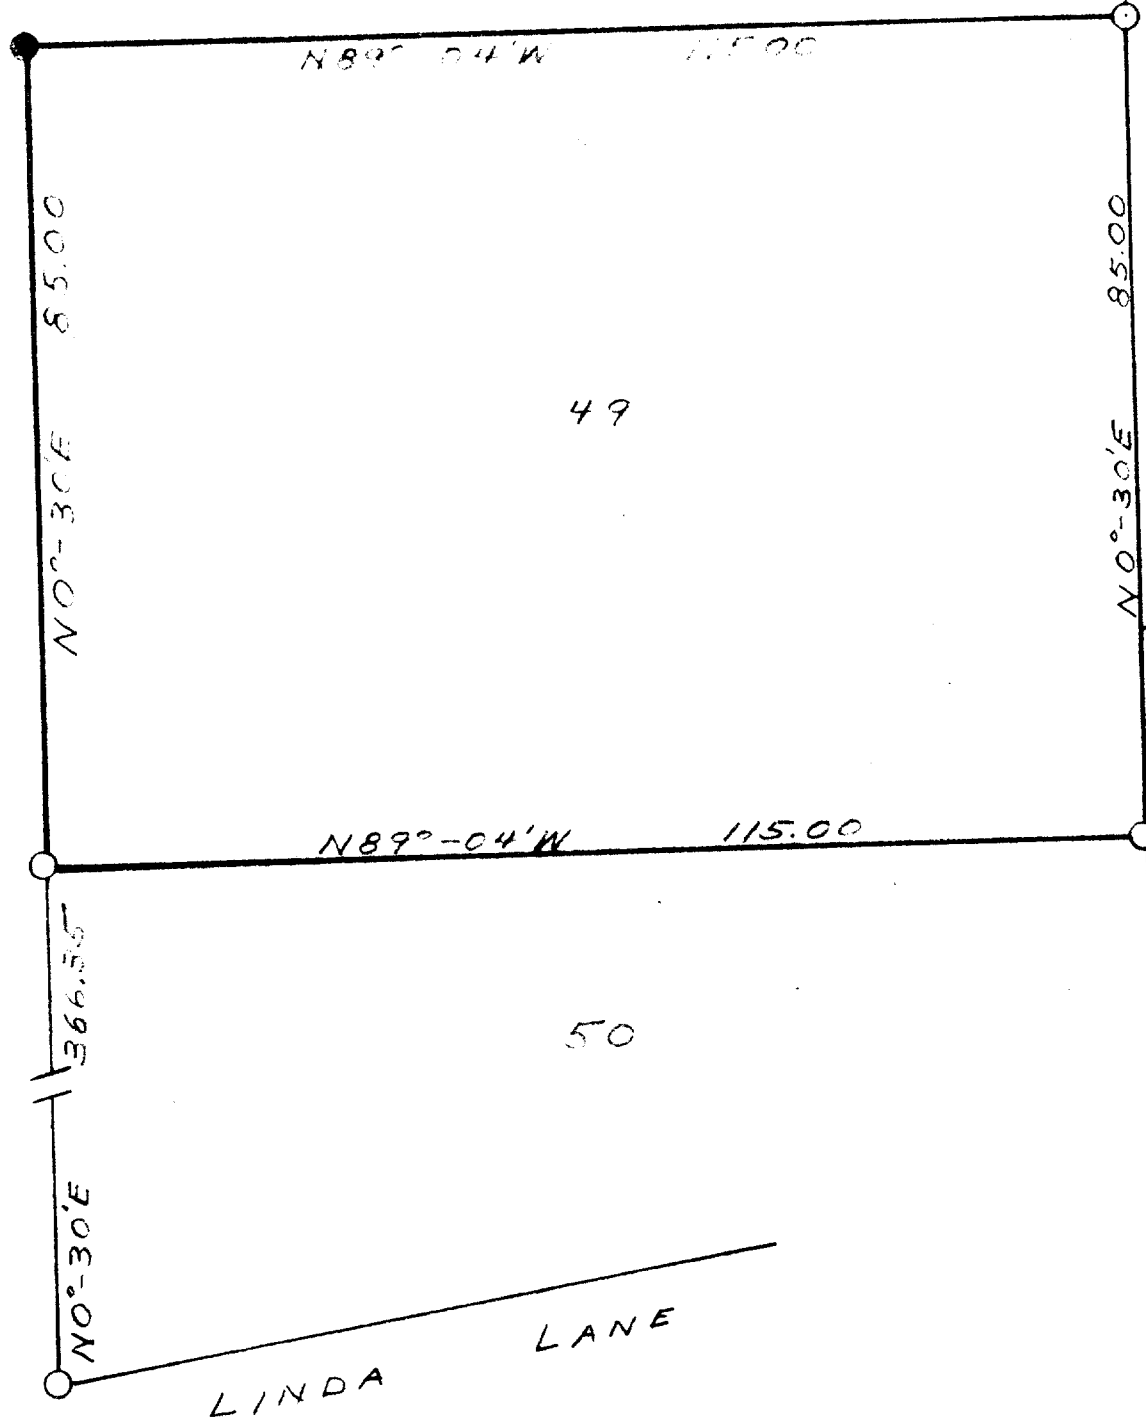

SCALE 1"=20'
● CONC. MONU.
○ IRON PIPE

STATE OF WISCONSIN) SS
COUNTY OF WALWORTH)
I, LLOYD L. JENSEN, DO HEREBY CERTIFY THAT I
HAVE SURVEYED THE PROPERTY SHOWN HEREON ACCORDING
TO THE OFFICIAL RECORDS, AND THAT THE PLAT ABOVE
IS A CORRECT REPRESENTATION OF THE LOT LINES
OF SAID PROPERTY.

MARCH 16, 1954
Lloyd L. Jensen
WALWORTH COUNTY SURVEYOR

PLAT OF SURVEY OF

LOT 49, STURWOOD
ADDITION No 2 TO THE CITY
OF LAKE GENEVA, WALWORTH
COUNTY, WISCONSIN

Lloyd L. Jensen
SURVEYOR

DATE MARCH 1954

7-42J

SCALE 1" = 20'