


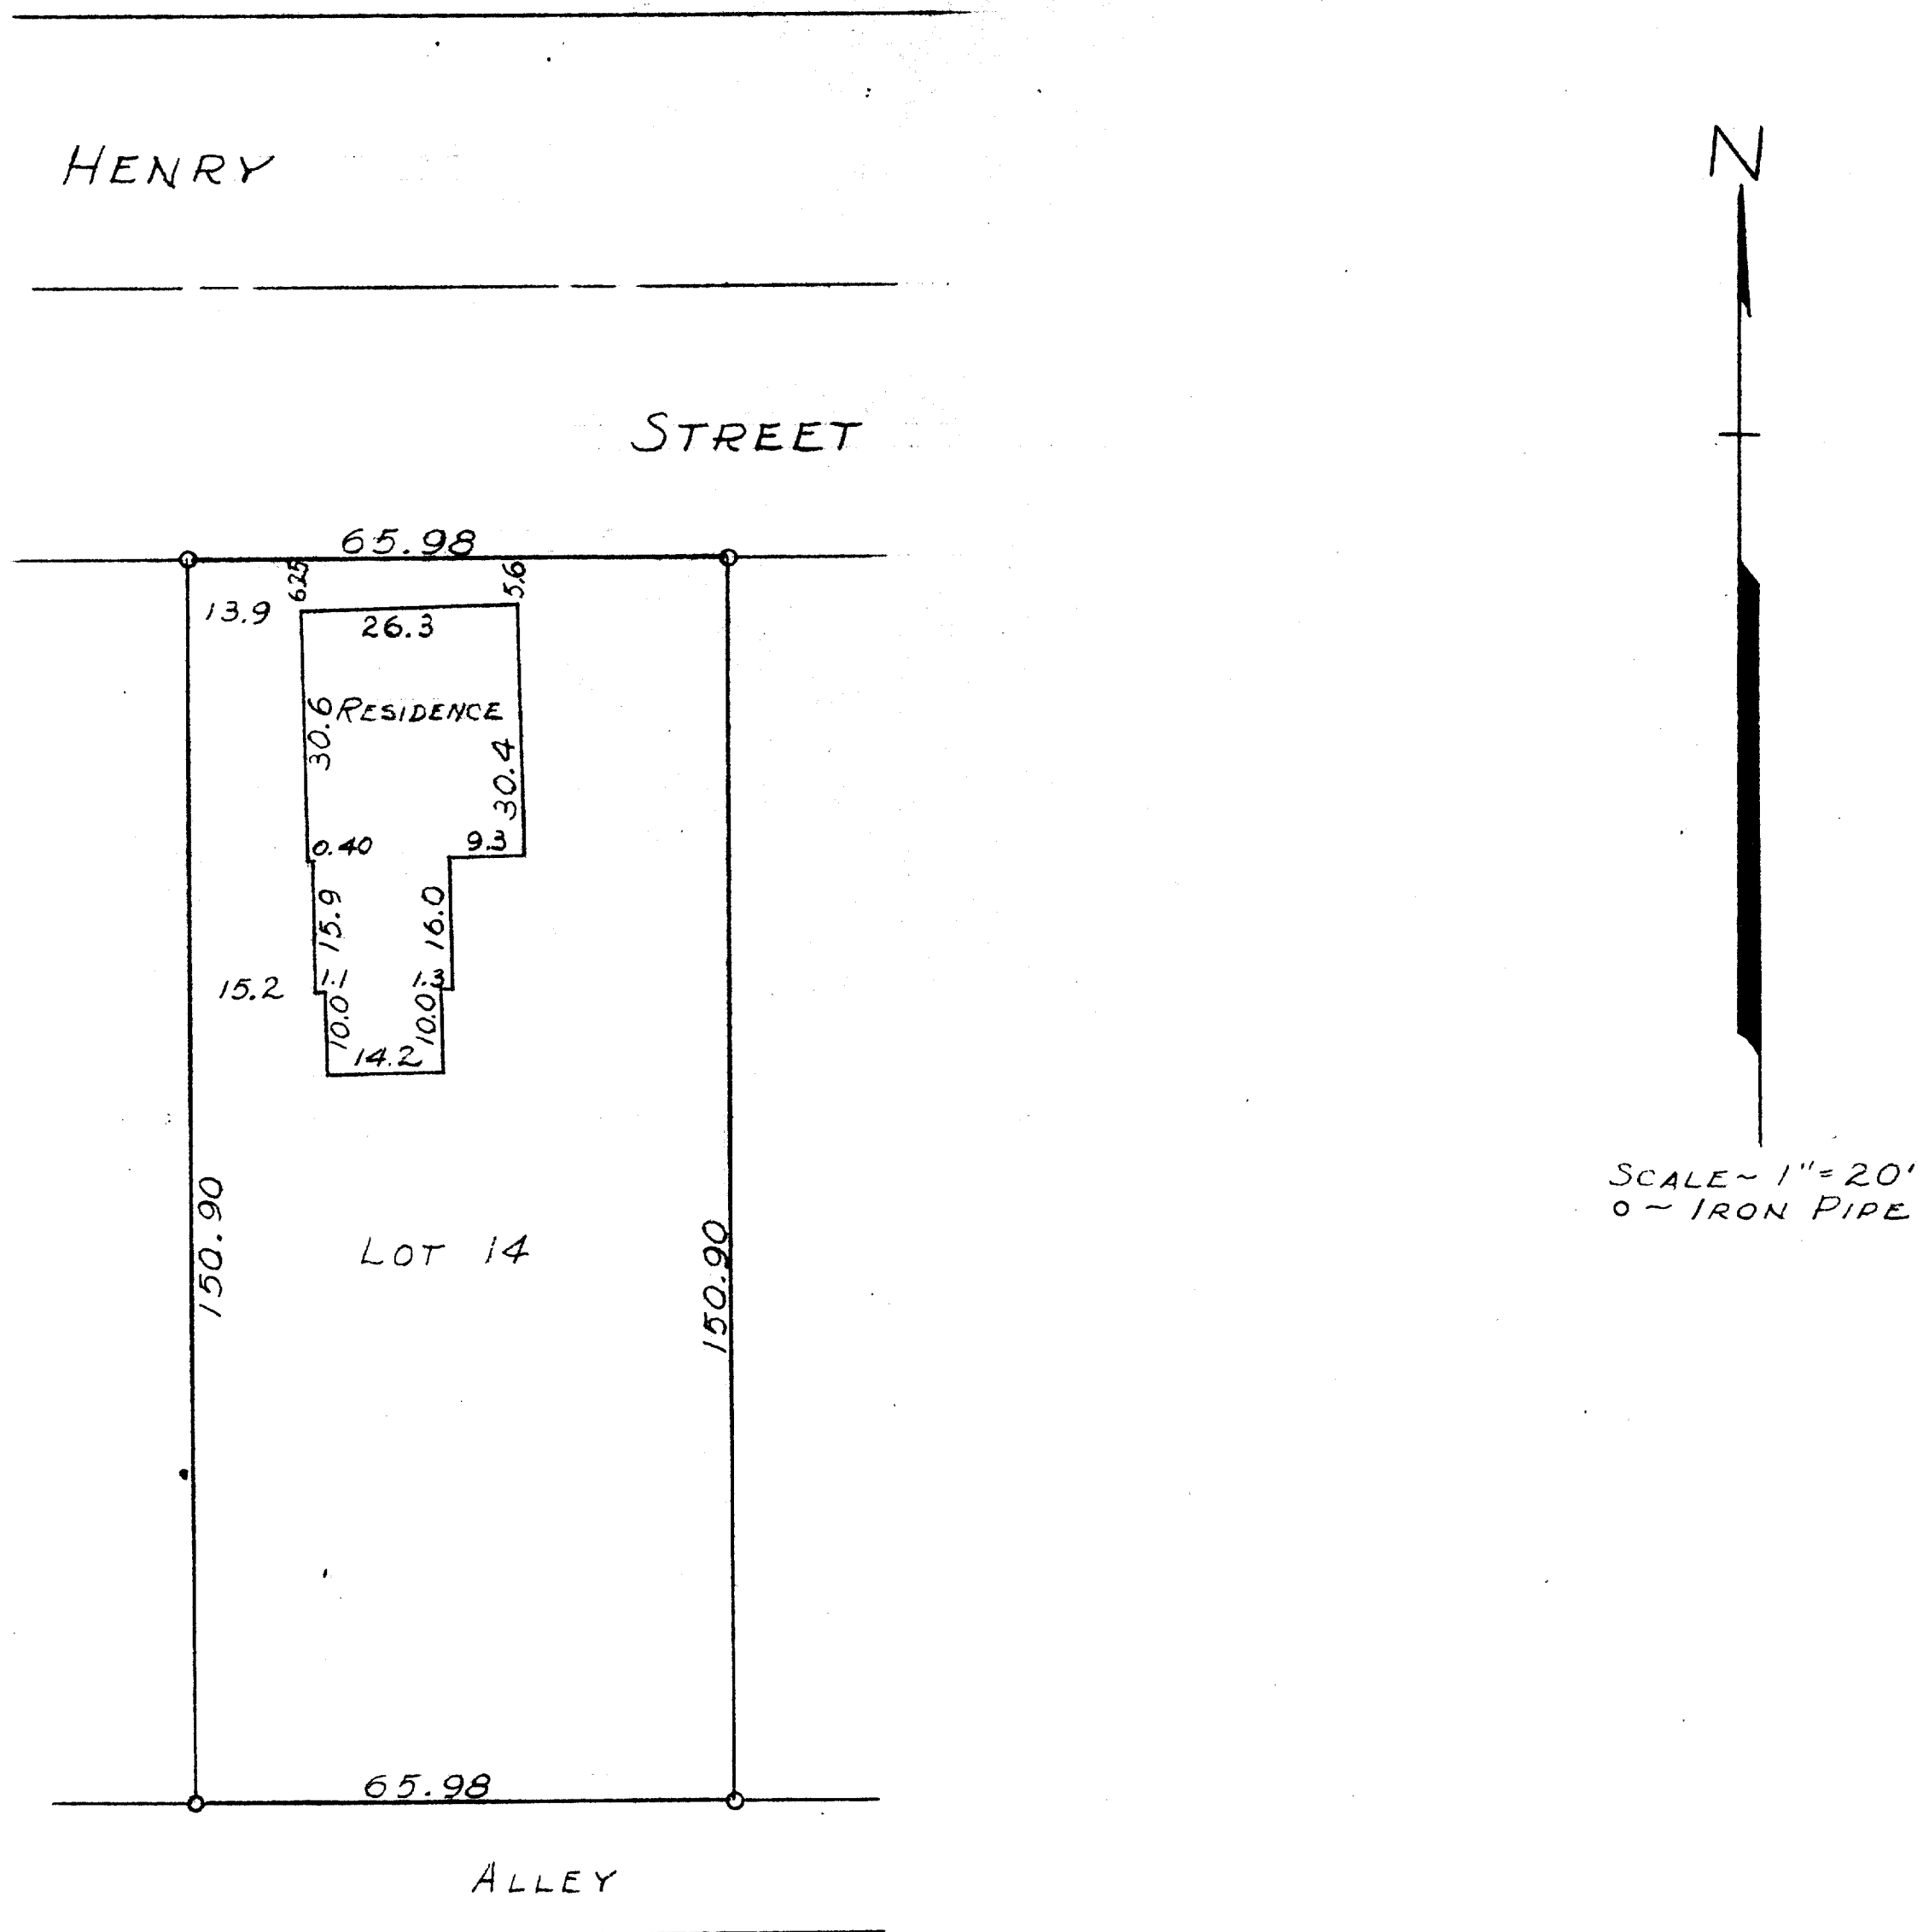

STATE OF WISCONSIN) S.S.
COUNTY OF WALWORTH)

I, GEORGE T. DUNHAM, DO HEREBY CERTIFY THAT I HAVE SURVEYED
THE PROPERTY DESCRIBED AS FOLLOWS:
LOT 14, FERGUSON'S ADDITION TO THE CITY OF LAKE GENEVA,
T2N R17E, WALWORTH COUNTY, WISCONSIN.
AND THAT THE PLAT SHOWN ABOVE IS A CORRECT REPRESENTATION OF THE
PROPERTY LINES AND OF THE BUILDINGS LOCATED THEREON.
JULY 22, 1957

George T. Dunham
GEORGE T. DUNHAM, SURVEYOR
DELAVER, WISCONSIN

7-45

EF-15