


CENTER

STREET

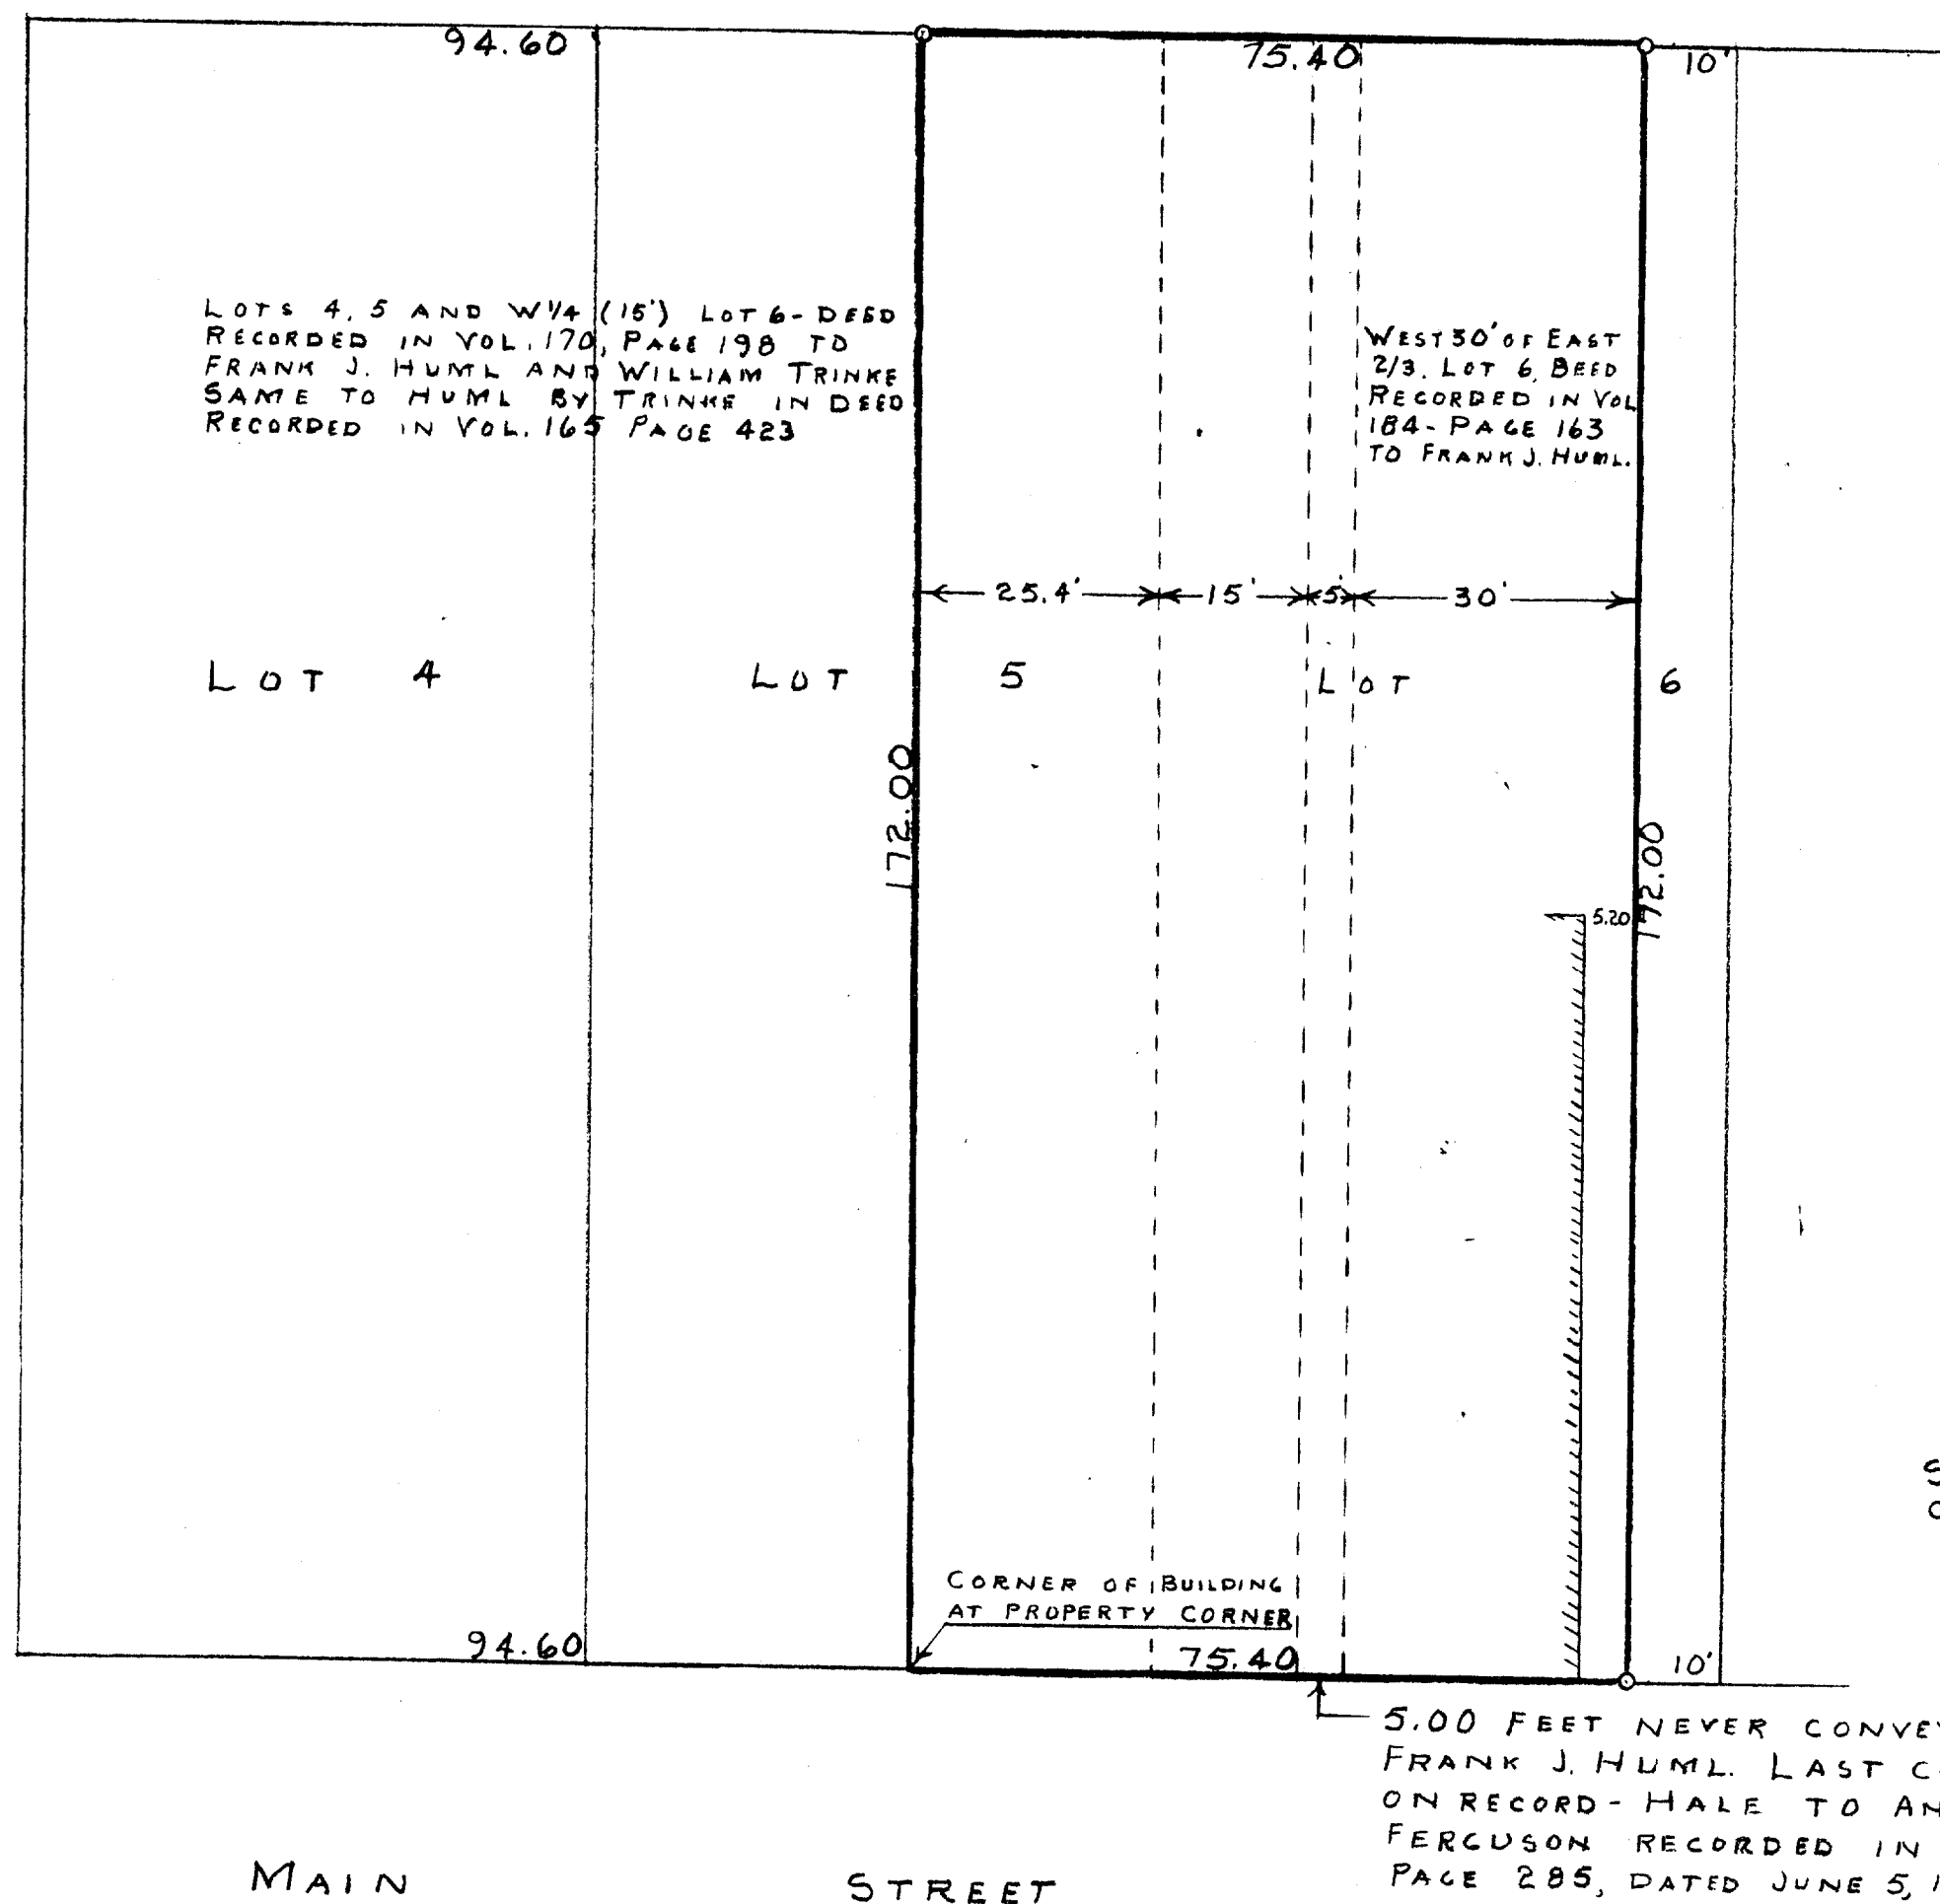

PLAT OF SURVEY OF PART OF LOTS 5 AND 6, BLOCK 28, ORIGINAL PLAT OF THE VILLAGE (NOW CITY) OF LAKE GENEVA, WALWORTH COUNTY, WISCONSIN NOV. 29, 1956

George T. Dunham
GEORGE T. DUNHAM
DELAVER, WISCONSIN
WIS. LAND SURVEYOR NO 5-306

7-46