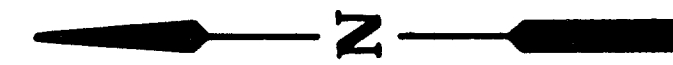
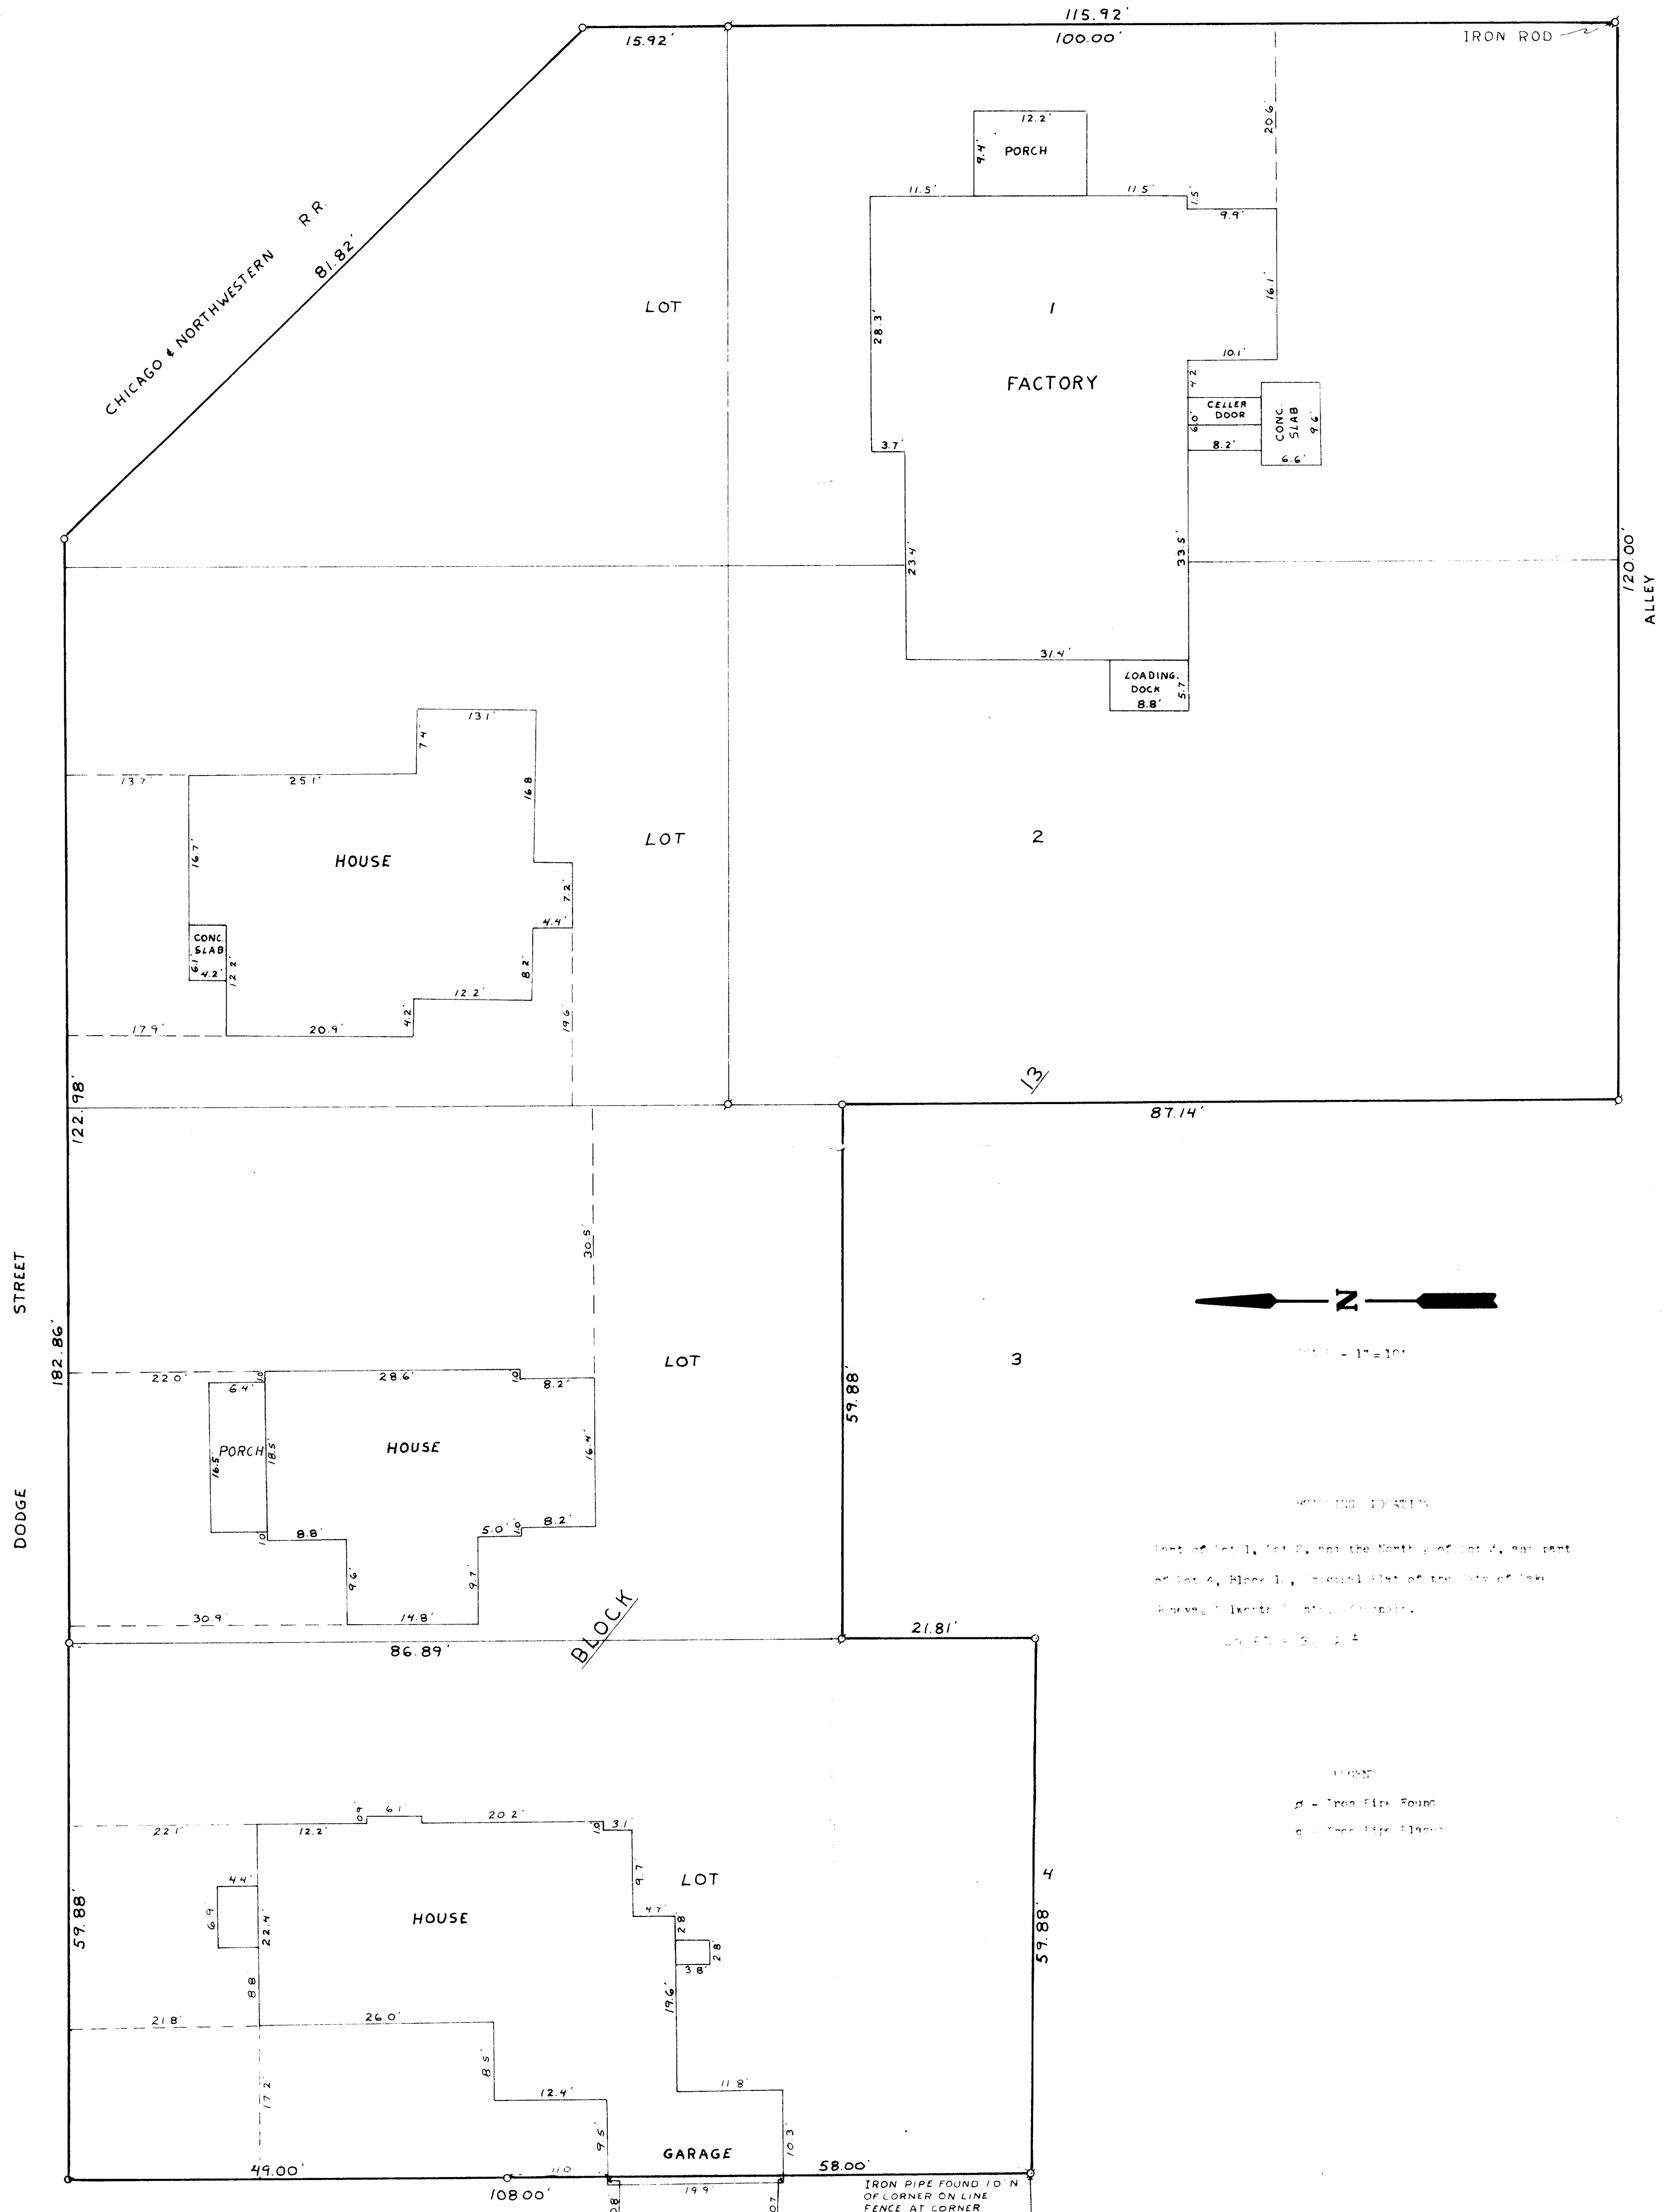


CHICAGO & NORTHWESTERN
R.R.
81.82'


$$1000' - 1" = 10'$$

GOULDING, LORETTA


East of lot 1, lot 2, and the North 1/2 of lot 4, and part of lot 4, Block 10, Original Plat of the City of New Haven, Connecticut, to wit, as shown.

$$-9.65 = 2.14 + \frac{1}{2}$$

1002

d - Iron Pipe Found
e - Iron Pipe Placed

IRON PIPE FOUND 10' N.
OF CORNER ON LINE
FENCE AT CORNER

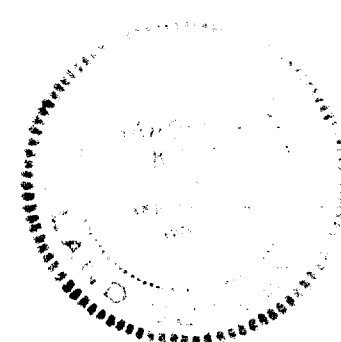We consider the system (1) and (2) for $\lambda = 1$.

Dec 21 1973