


HAROLD H. KOLB

REGISTERED PROFESSIONAL LAND SURVEYOR
LAKE GENEVA, WISCONSIN

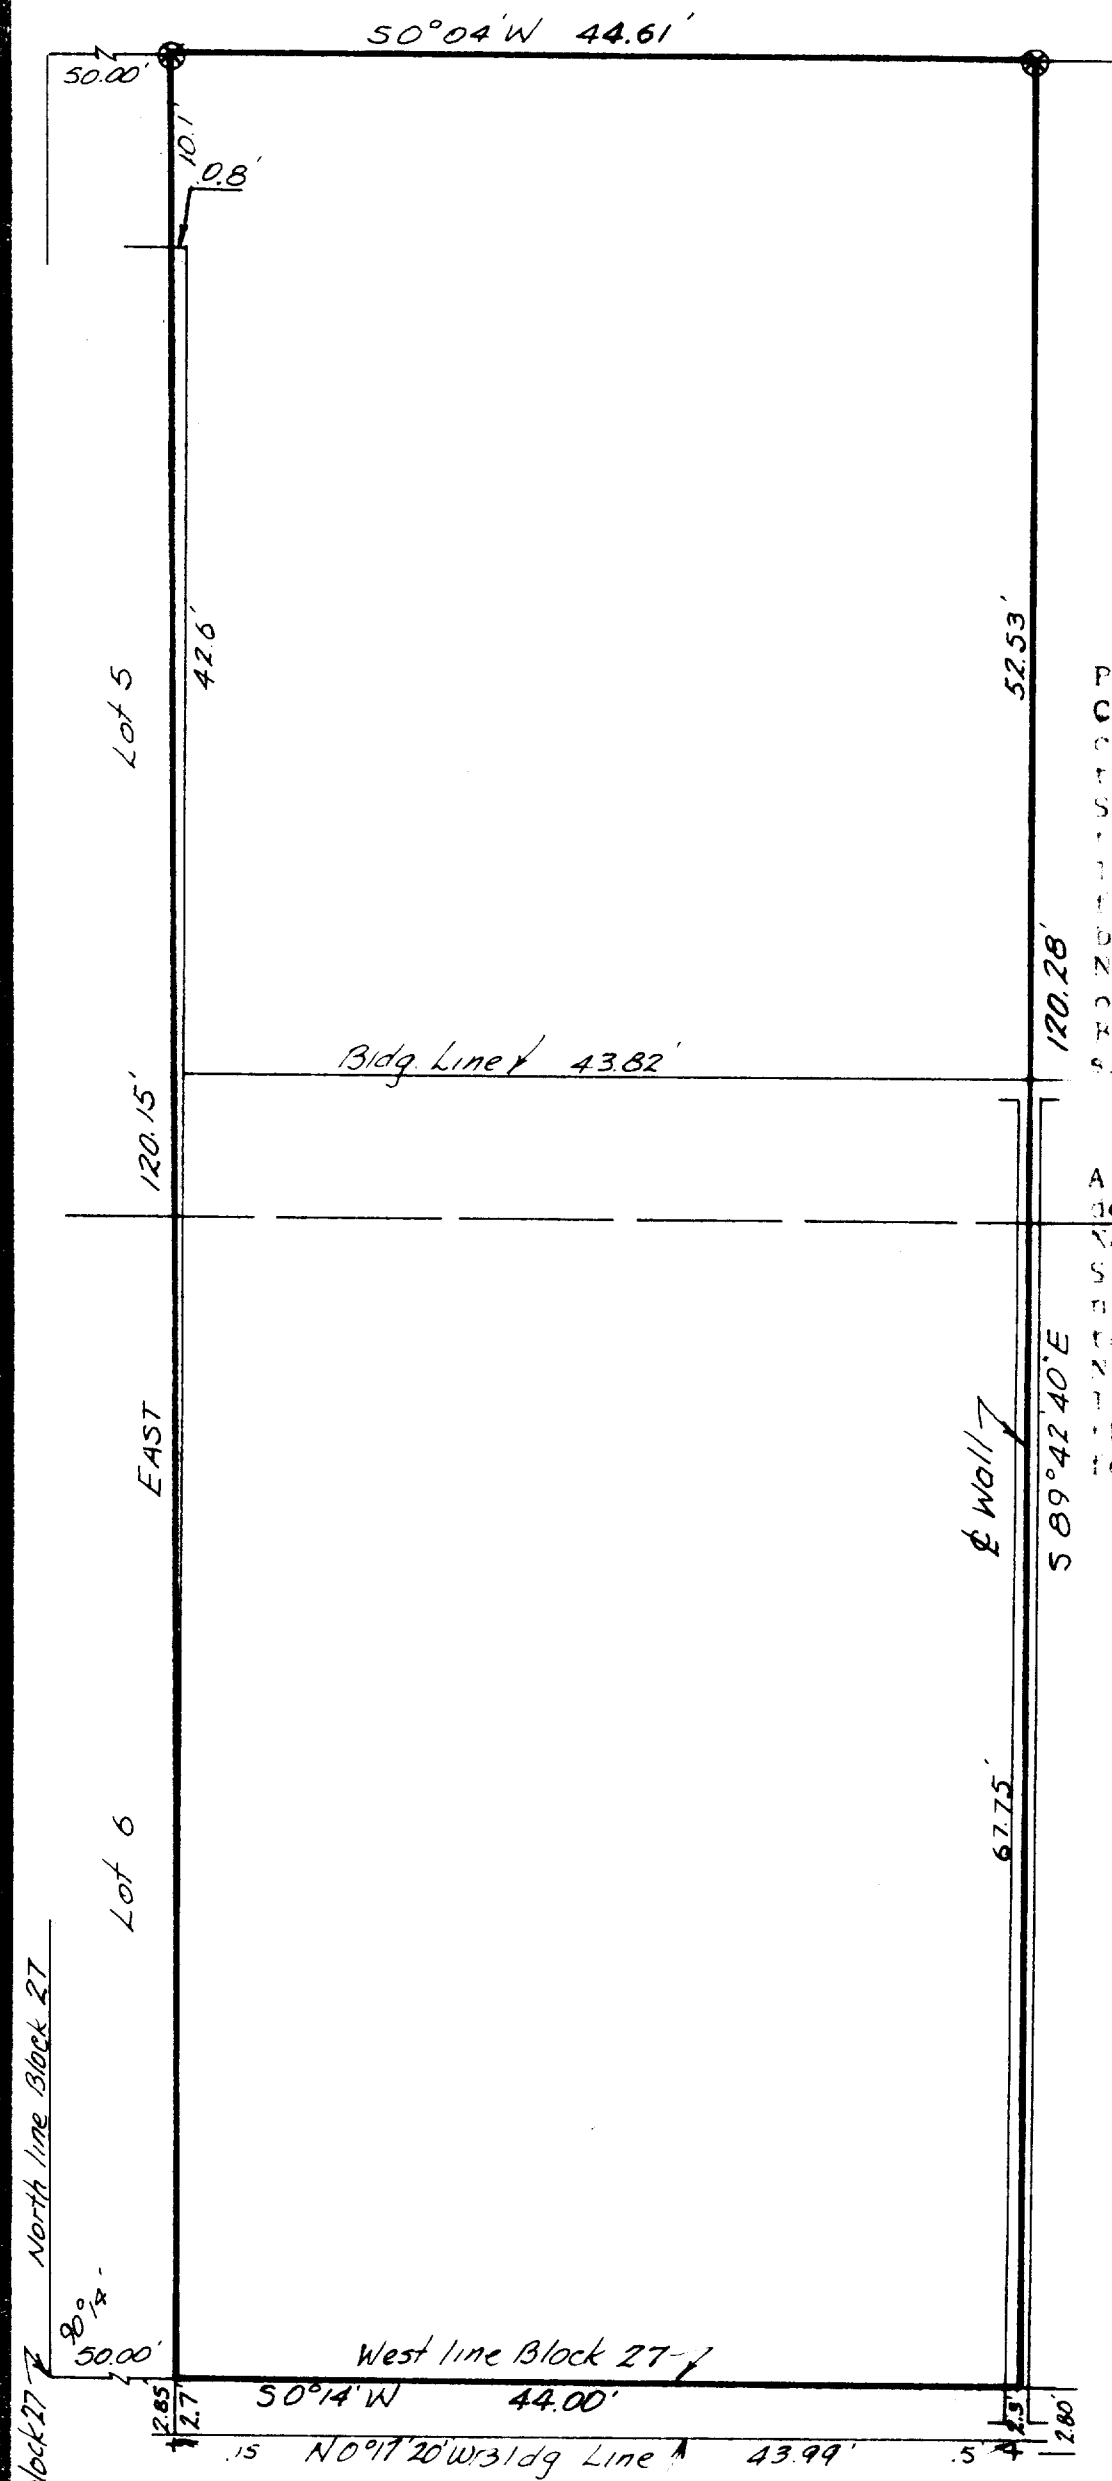


PLAT OF SURVEY OF

Part of Lot 5, and 6, Block 27, Original Plat City of Lake Geneva, Walworth County, Wisconsin described as follows: Commencing at the Northwest corner of said Block 27, thence S 0°14' W 50.00 feet to the place of beginning; thence East 120.15 feet parallel to the North line of said Block 27; thence S 0°06' W 44.61 feet; thence N 89°42'40" W 52.53 feet to the beginning of a party wall; thence continue N 89°42'40" W 67.75 feet along the centerline of said party wall to the West line of said Block 27; thence N 0°11' E 44.00 feet along said West line to the place of beginning.

DESCRIPTION OF

A building encroachment into Broad Street described as follows: Commencing at the Northwest corner of said Block 27; thence S 0°14' W 50.00 feet to the place of beginning; thence continue S 0°14' W 44.00 feet to the centerline of a party wall; thence N 89°42'40" W 2.3 feet along said centerline; thence N 0°17'20" W 43.99 feet along the West building line; thence East 2.3 feet to the place of beginning.

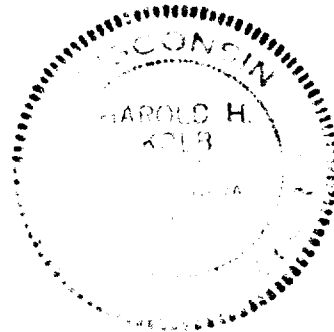

LEGEND

- - IRON PIPE FOUND
- - IRON PIPE PLACED
- - CONCRETE MONUMENT
- ⊗ - Railroad Spike
- + - Cut Cross

Scale - 1"=10'

BROAD ST.

I, HAROLD H. KOLB, DO HEREBY CERTIFY THAT I HAVE SURVEYED THE PROPERTY HEREON DESCRIBED ACCORDING TO THE OFFICIAL RECORDS, AND THAT THE PLAT HEREON IS A CORRECT REPRESENTATION OF THE LOT LINES.

Harold H. Kolb

HAROLD H. KOLB

WISCONSIN REGISTERED LAND SURVEYOR, S-187

DATE December 19, 1973

OP-263

7-466