

RONALD H. ZIMMERMAN  
REGISTERED LAND SURVEYOR

PLAT OF SURVEY

FOR

WAUKESHA SAVINGS & LOAN

GEORGE


STREET

EAST

50

4' CONC WALK

TO W LINE OF MADISON ST

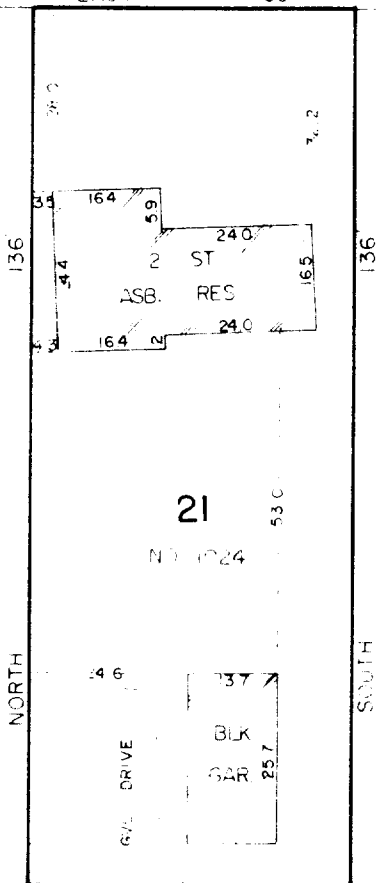

SCALE 1" = 30'

ALLEY

CERTIFICATION

STATE OF WISCONSIN  
COUNTY OF WAUKESHA: SS

I, RONALD H. ZIMMERMAN, REGISTERED LAND SURVEYOR, DO HEREBY CERTIFY THAT I HAVE MADE A SURVEY  
OF LOT 21, WATSON'S BLVD ADD, CITY OF LAKE GENEVA, WALWORTH CO  
AND THE EXISTING BUILDING AND IMPROVEMENTS LOCATED THEREON AND THAT THE PLAT HEREWITH DRAWN  
IS A CORRECT REPRESENTATION OF SAID SURVEY

DATE NOV 30 1973

RONALD H. ZIMMERMAN

S 868

7-468