



O-INDICATES IRON PIPE

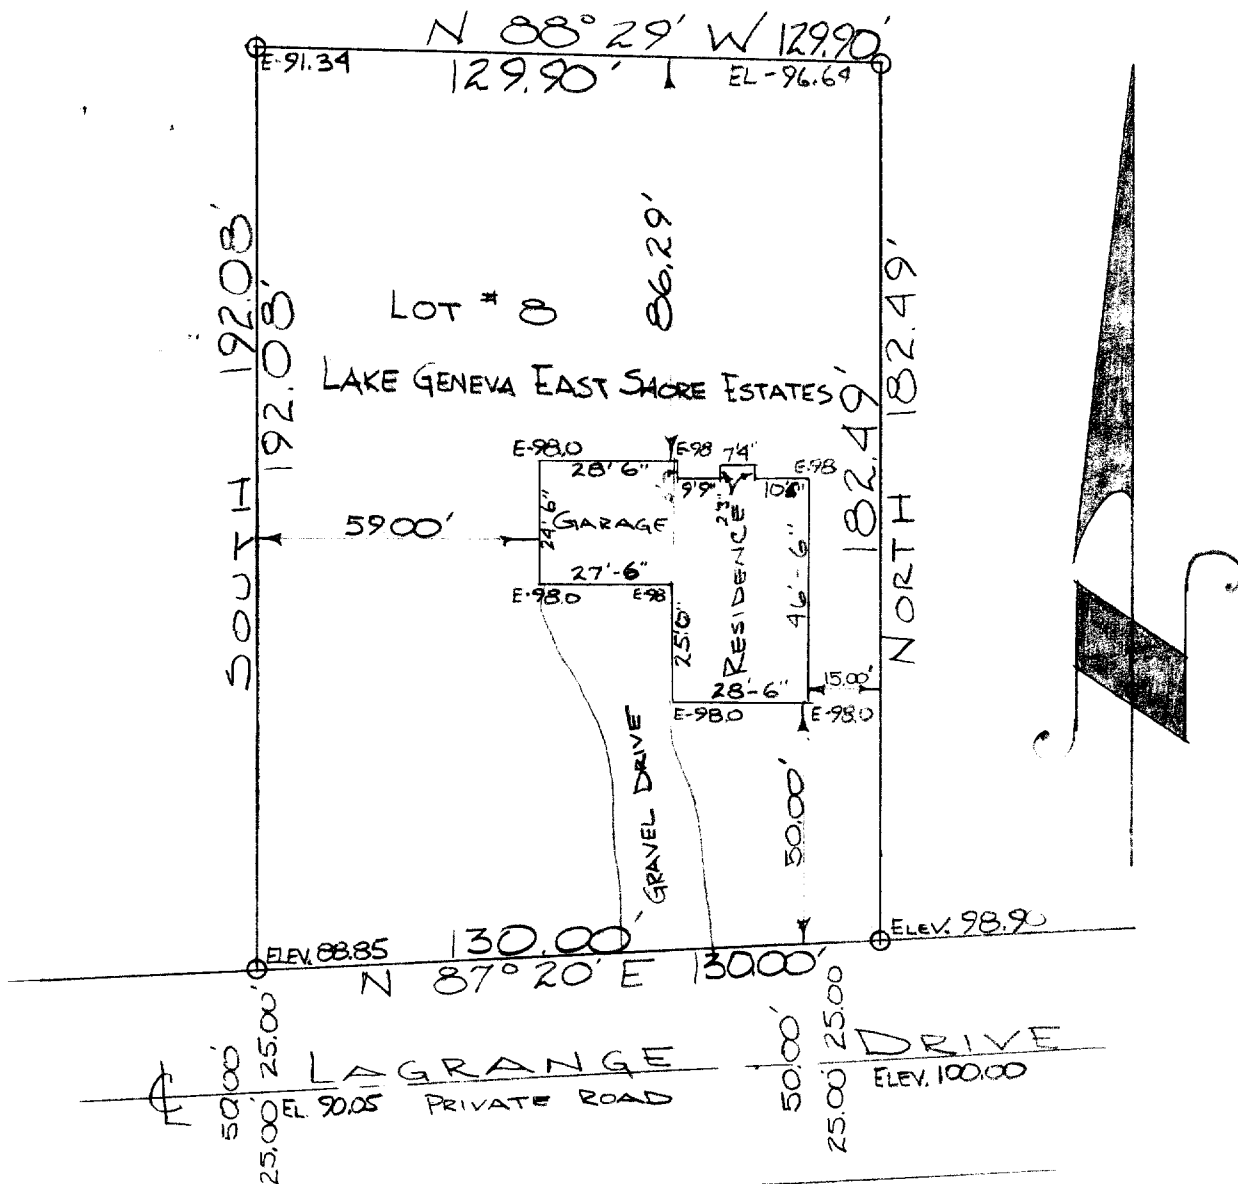

DESCRIPTION: Lot #8 of Lake Geneva East Shore Estates Subdivision, in the City of Lake Geneva, Walworth County, Wisconsin.

CERTIFICATE: I, James F. Biagi, surveyor, do hereby certify that I have surveyed the property hereon described and that the location of all the improvements are as shown on the drawing above.

June 20, 1966

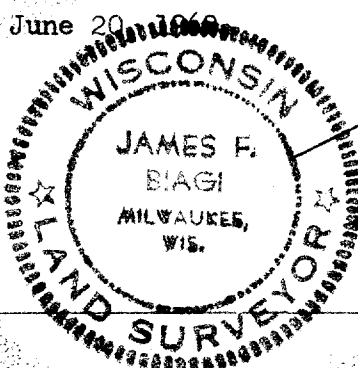

James F. Biagi

2458

7-46B