


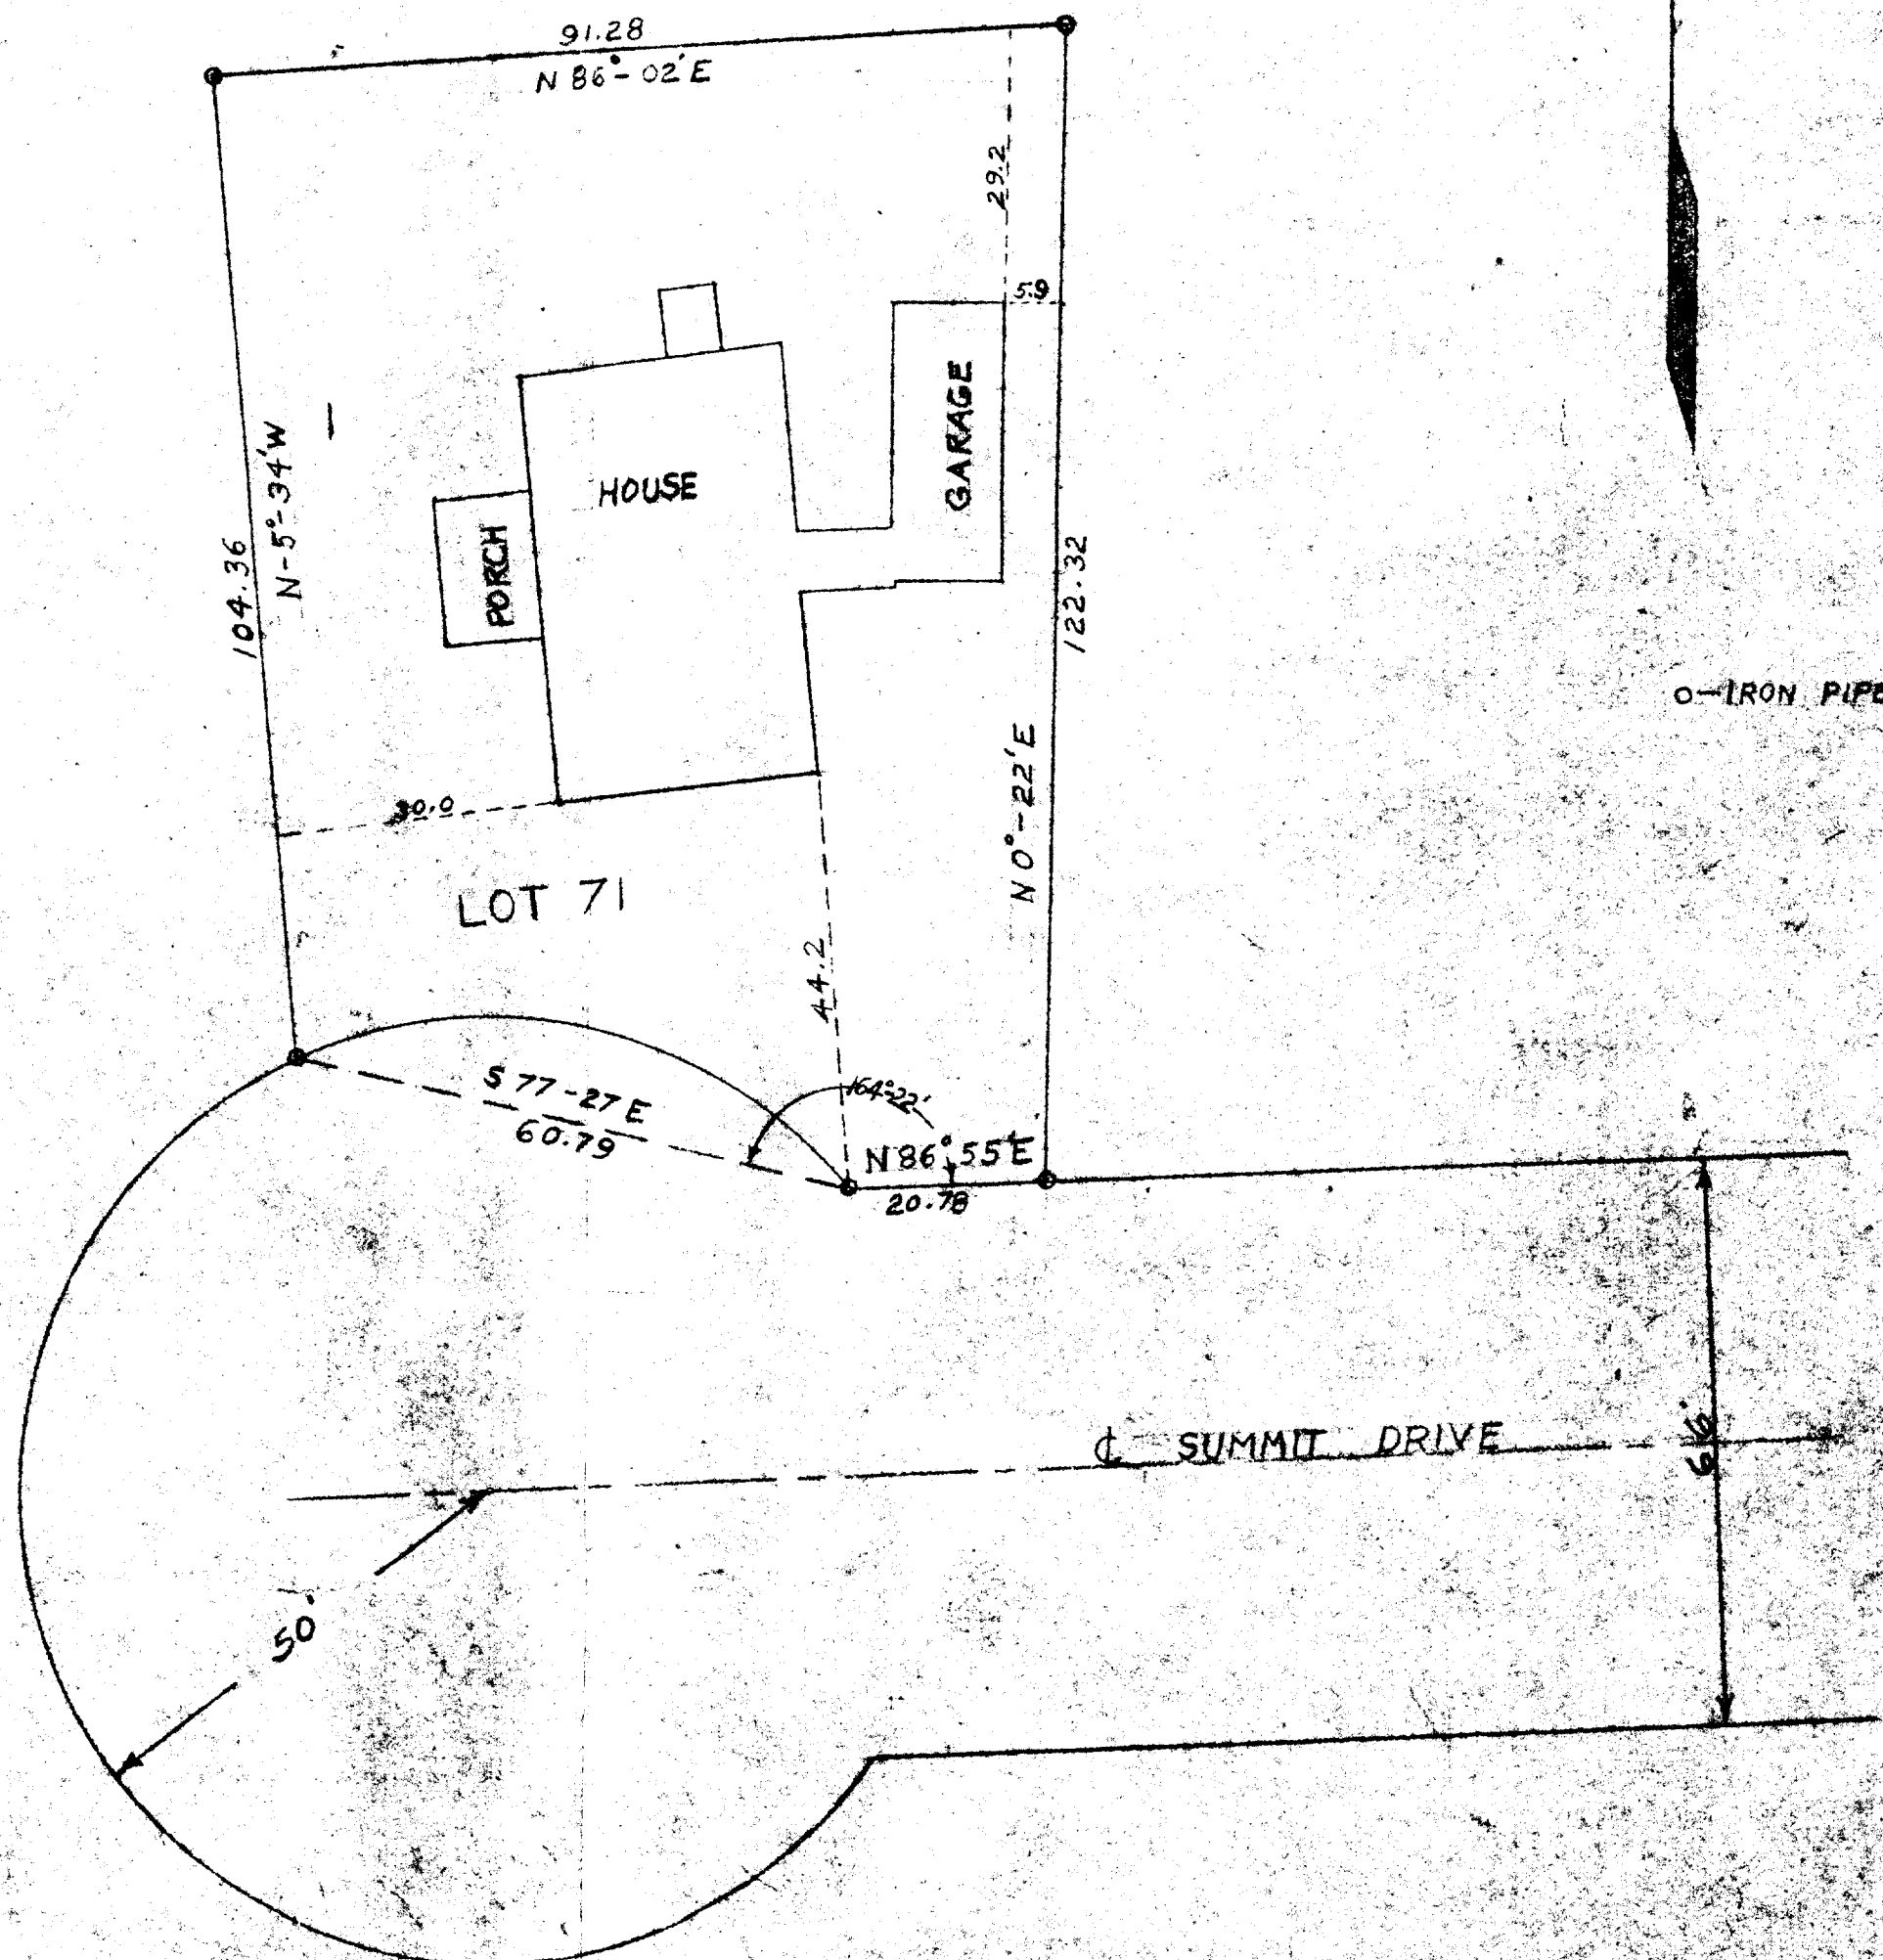

STATE OF WISCONSIN
COUNTY OF WALWORTH

I, LLOYD L. JENSEN, DO, HEREBY CERTIFY THAT I HAVE SURVEYED
THE PROPERTY DESCRIBED HEREON ACCORDING TO THE OFFICIAL RECORDS
AND THAT THE PLAT HEREON IS A CORRECT REPRESENTATION OF THE
LOT LINES AND PRINCIPAL LINES OF BUILDINGS THEREON.

PLAT OF SURVEY OF

LOT 71 OF STURWOOD ADDITION NO. 3
LOCATED IN THE CITY OF LAKE GENEA
WALWORTH COUNTY WISCONSIN

ELKHORN, WISCONSIN NOV. 5, 1955

SCALE - 20'

DATE NOV. 5, 1955