


# PLAT OF SURVEY

Lot 1 of the Certified Survey Map No. 5045 recorded July 27, 2022 in the Walworth County Register of Deeds, as Document 1065967, being a redivision of Lot 150 of Symphony Bay Subdivision, also recorded in the Walworth County Register of Deeds Office as Document 926074, located in the Southeast Quarter of the Southeast Quarter of Section 6, Township 1 North, Range 18 East, City of Lake Geneva, Walworth County, State of Wisconsin.



LEGEND	
○	CLEAN OUT
⊠	ELECTRIC RISER
●	SET IRON BAR
⊞	TELEPHONE RISER
⊞	WATER SHUT-OFF

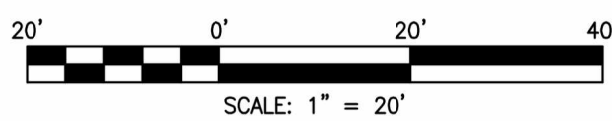

ALL BUILDING TIES SHOWN ARE AS MEASURED TO THE FOUNDATION

6/19/25 JGK - REVISED ADDRESS NUMBER

STATE OF ILLINOIS )  
 ) S.S.  
 COUNTY OF McHENRY )



In my professional opinion, and based on my observations, I hereby certify that the above described property has been surveyed under my direction and that the above map is a true representation thereof and shows the size and location of all visible structures, and dimensions of all principle buildings thereon, boundary fences, apparent easements, roadways, and visible encroachments, if any. This survey is made for the use of the present owners of the property, and also those who purchase, mortgage, or guarantee the title thereto within one year from the date hereof.

Dated at Woodstock, McHenry County, Illinois 6/17 A.D., 2025.

Vanderstappen Land Surveying, Inc.  
 Design Firm No. 184-002792

By: Arthur P. Gritmacker  
 Wisconsin Registered Land Surveyor No. S3021

**NOTE:** Only those Building Line Restrictions or Easements shown on a Recorded Subdivision Plat are shown hereon unless the description ordered to be surveyed contains a proper description of the required building lines or easements.  
 \* No distance should be assumed by scaling.  
 \* No underground improvements have been located unless shown and noted.  
 \* No representation as to ownership, use, or possession should be hereon implied.  
 \* This Survey and Plat of Survey are void without original embossed or colored seal and signature affixed.

Compare your description and site markings with this plat and AT ONCE report any discrepancies which you may find.

CLIENT: FAIRWYN DEVELOPMENT  
 DRAWN BY: JGK CHECKED BY: APG  
 SCALE: 1"=20' SEC. 6 T. 1 R. 18 E.  
 BASIS OF BEARING: PER RECORD SUBDIVISION  
 P.I.N.: ZA504500001  
 JOB NO.: 170870.150-B-1 I.D. LSS  
 FIELDWORK COMP.: 6/14/25 BK. PG.  
 ALL DISTANCES SHOWN IN FEET AND DECIMAL PARTS THEREOF CORRECTED TO 68° F. REF: 170870

