


Survey No. 18.0033.08

TAX ID: ZSR 00008

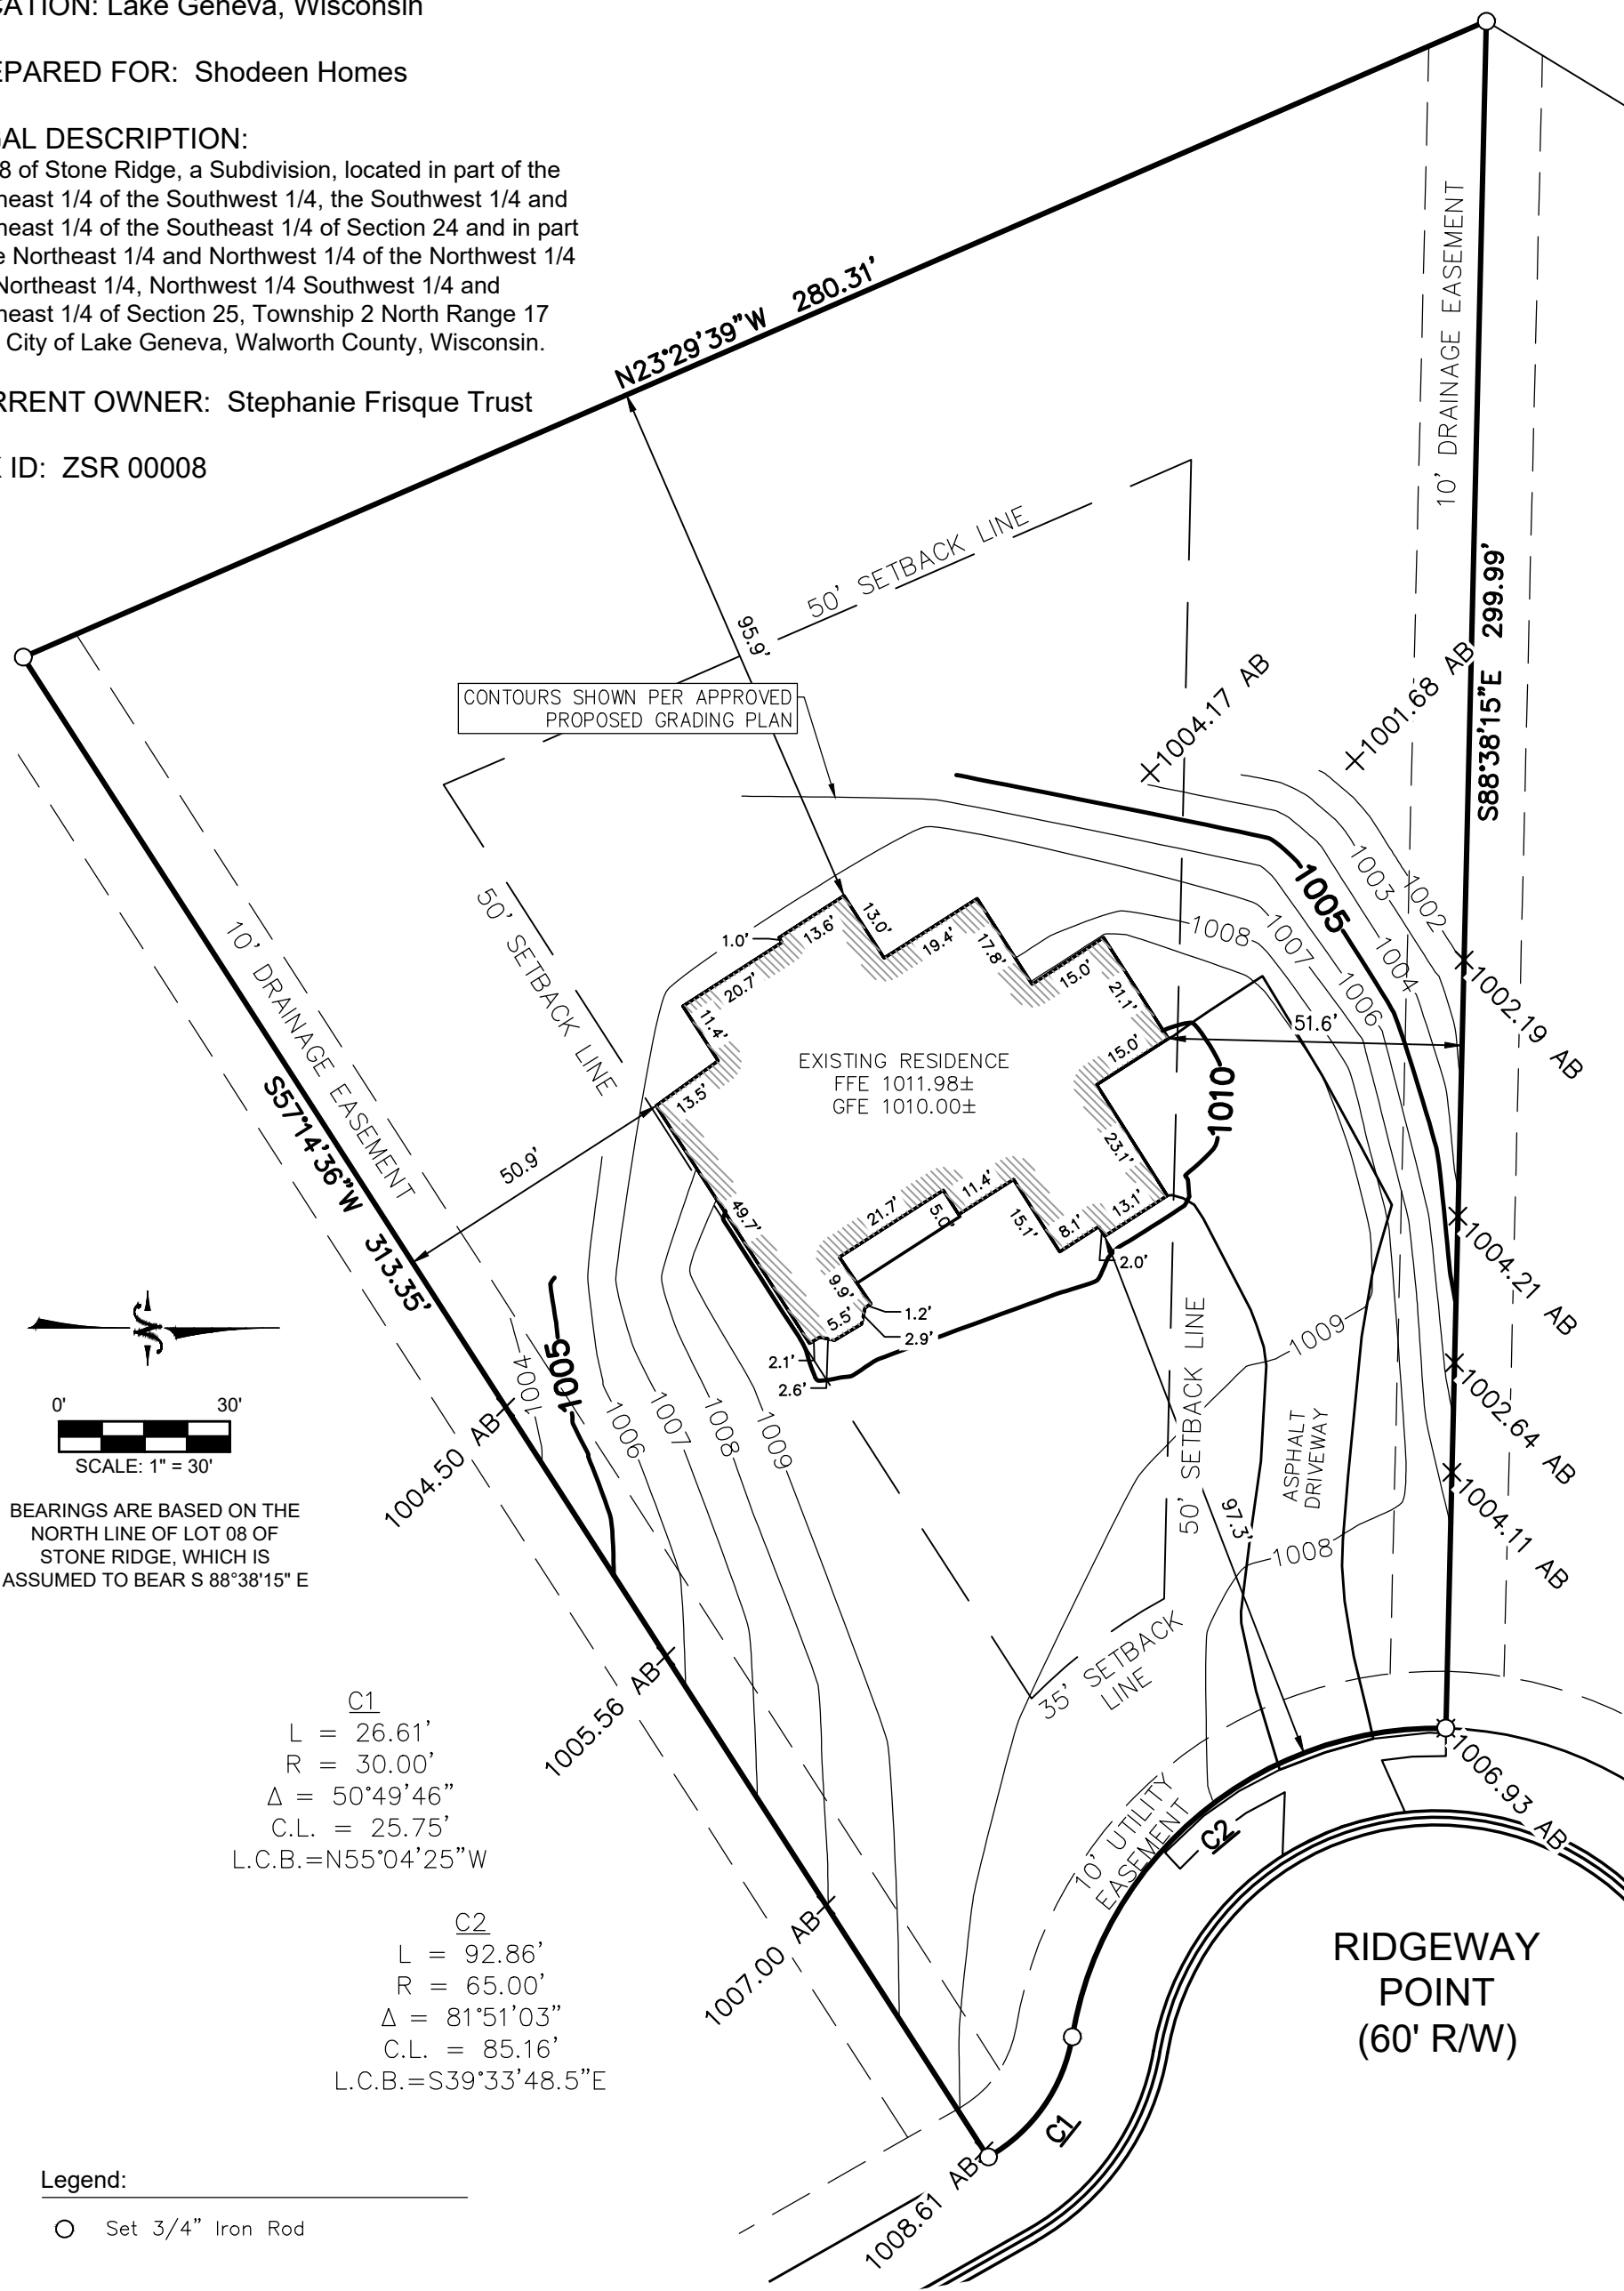

COMPLETION DATE OF  
FIELD WORK: 9/4/2025