


N

SCALE-1"=20'
○=IRON PIPE
●=CONC. MONU.

E L M

STREET

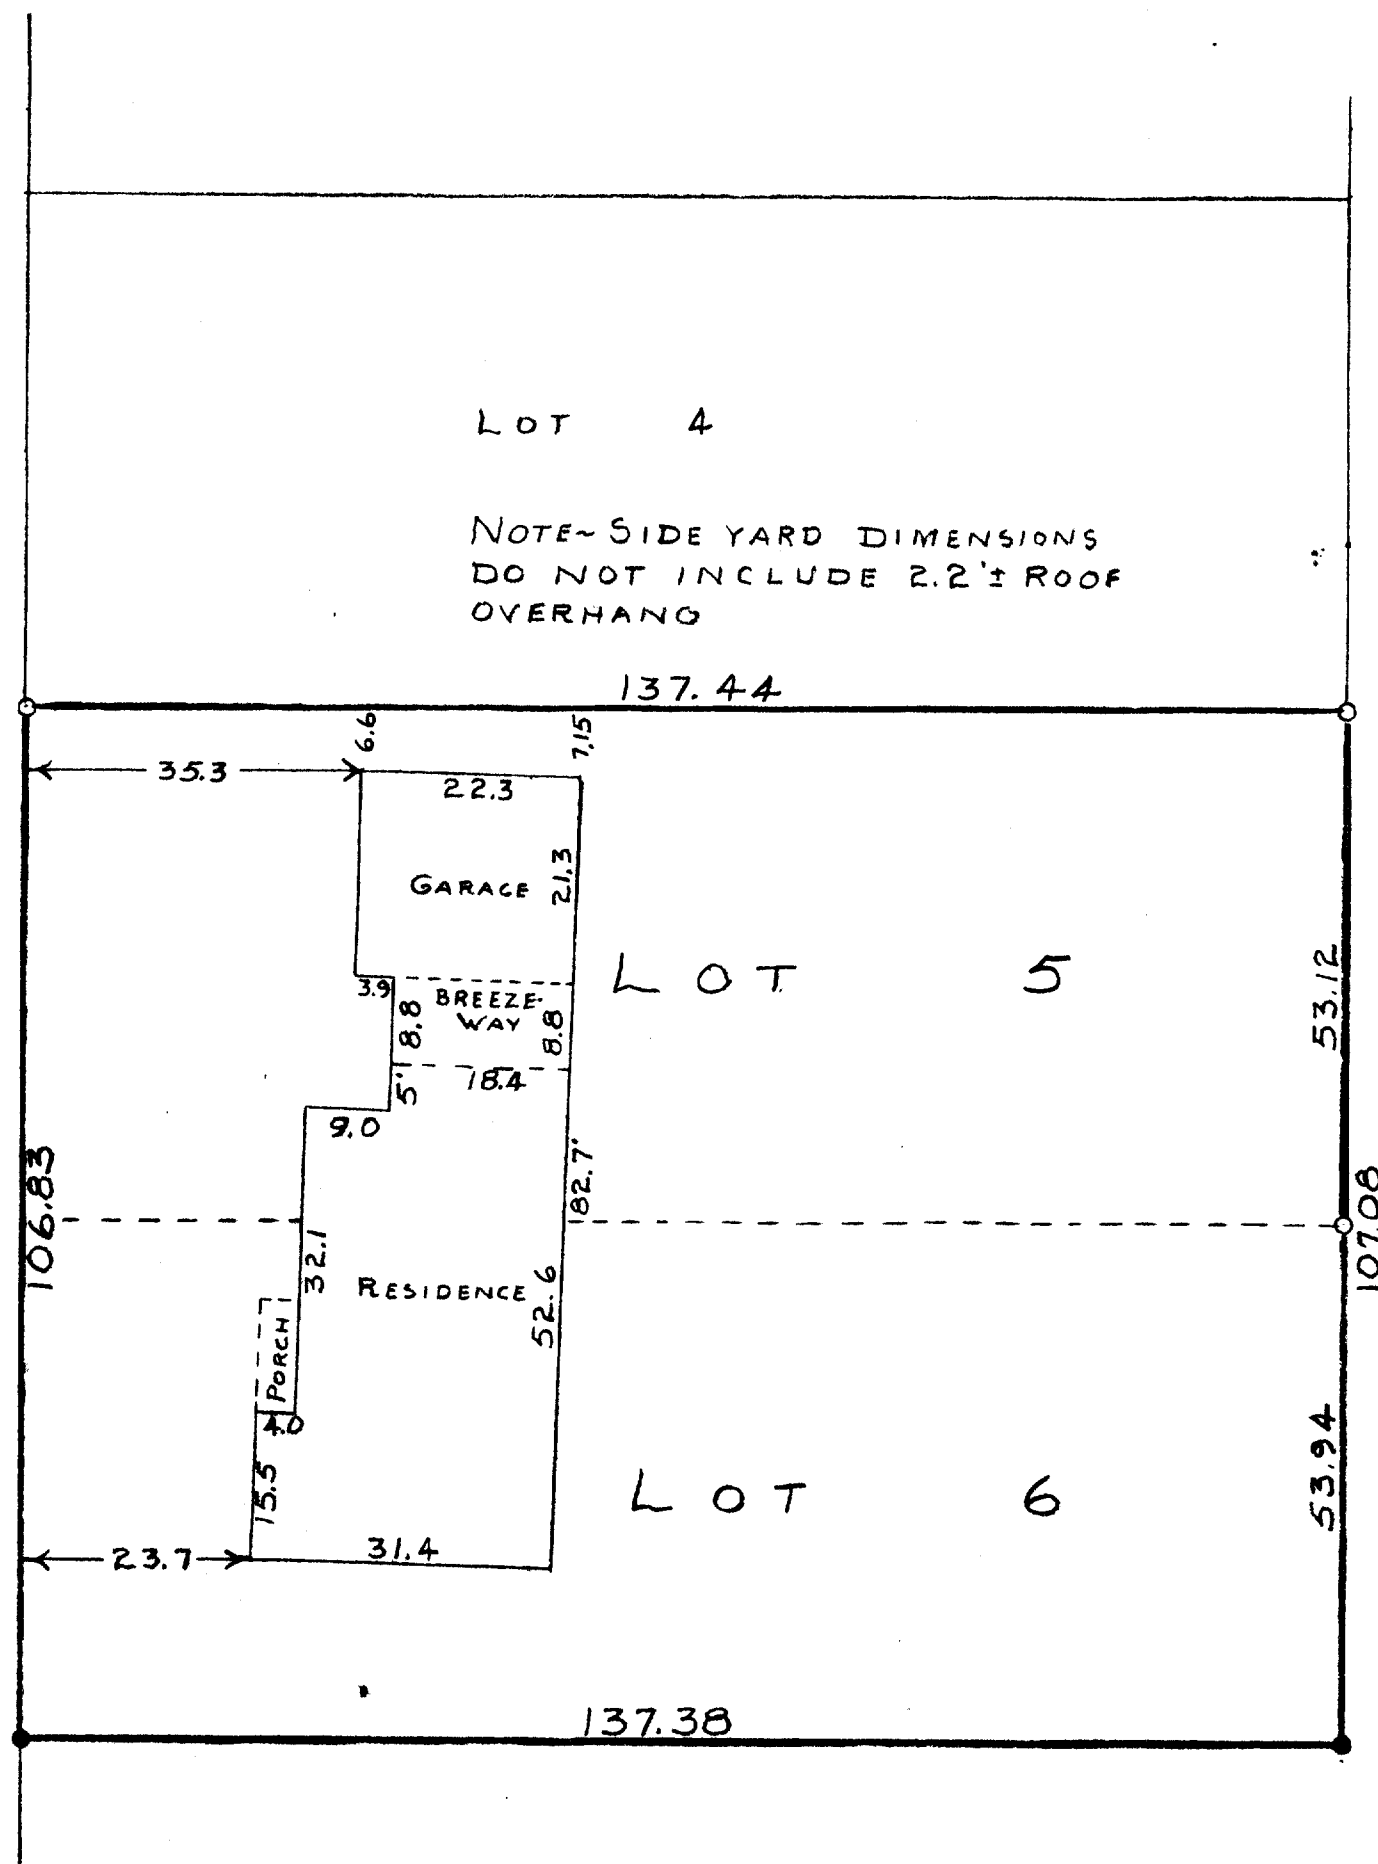

STATE OF WISCONSIN)
COUNTY OF WALWORTH)

I, GEORGE T. DUNHAM, DO HEREBY CERTIFY THAT I HAVE SURVEYED THE
PROPERTY DESCRIBED AS FOLLOWS:

LOTS 5 AND 6, BLOCK 3 OF LAKE GENEVA ESTATES LOCATED
IN THE CITY OF LAKE GENEVA, WALWORTH COUNTY, WISCONSIN.
AND THAT THE PLAT SHOWN ABOVE IS A CORRECT REPRESENTATION OF THE
PROPERTY LINES AND OF THE IMPROVEMENTS LOCATED THEREON
APRIL 10, 1957

George T. Dunham
GEORGE T. DUNHAM
DELAVER, WISCONSIN
WIS. LAND SURVEYOR No. 5-306 7-48